


TOP VIEW

SIDE VIEW

BOTTOM CHORD
MEMBERS BCI-3, 4, 7, 8, BC2-3, 4, 7 & 8

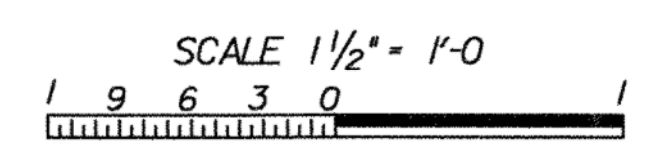

NOTES:
1. FOR NOTES ON BOTTOM CHORD REPAIR DETAILS, SEE SHEET 30.

STATE OF VERMONT		AGENCY OF TRANSPORTATION	
Town Of	SWANTON	Bridge No.	18
Highway No.		Log Sta.	
		Surv. Sta.	
RAIL TRAIL OVER MISSISQUOI RIVER			
LOWER CHORD REPAIR DETAILS 2			
Designed By	R. SACCHI	Drawn By	R. ROSS
Checked By	H. BUI	Bridge Design Supervisor	R. SACCHI
Date	1/23/08	Date	1/23/08
PROJECT	SWANTON	PROJECT NO.	STP ST MHTB(II)
I.G.C. Info.	ZD024LC2.dgn	Date	1/30/2008
Bridge Sheet No.	BR3	Sheet	31 of 63

