


**NOTES:**  
 1. FOR NOTES ON BOTTOM CHORD REPAIR DETAILS, SEE SHEET 30.

**BOTTOM CHORD**  
 MEMBERS BCI-5, 6, BC2-5 & 6

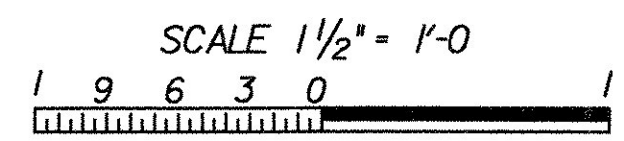

<b>STATE OF VERMONT</b>	
<b>AGENCY OF TRANSPORTATION</b>	
Town Of	SWANTON
Bridge No.	18
Highway No.	
Log Sta.	
Surv. Sta.	
RAIL TRAIL OVER MISSISQUOI RIVER	
<b>LOWER CHORD REPAIR DETAILS 3</b>	
Designed By	R. SACCHI
Drawn By	R. ROSS
Checked By	H. BUI
Date	1/23/08
Bridge Design Supervisor	R. SACCHI
Date	1/23/08
PROJECT	SWANTON
PROJECT NO.	STP ST MHTB(1)
I.G.C. Info.	ZD024LC3.dgn
Bridge Sheet No.	BR3
	Sheet 32 of 63