


NOTE: BEARING SHOE NOT SHOWN

NOTE: BEARING SHOE NOT SHOWN

BEARING DETAILS (EXPANSION)

BEARING DETAILS (FIXED)

- NOTES:
- PAYMENT FOR BEARINGS WILL BE MADE UNDER CONTRACT ITEM 531.10.
 - SEE SHEETS 41 & 42 FOR BEARING SHOE REPAIR DETAILS.

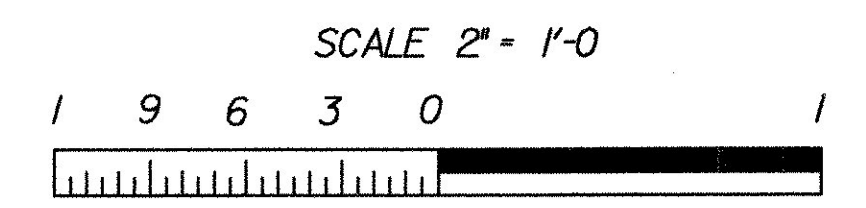

STATE OF VERMONT AGENCY OF TRANSPORTATION	
Town Of SWANTON	Bridge No. 18
Highway No. _____	Log Sta. _____
Surv. Sta. _____	
RAIL TRAIL OVER MISSISQUOI RIVER	
BEARING DETAILS (TRUSS)	
Designed By R. SACCHI/H. BOUI	Drawn By A. ZAWILINSKI
Checked By H. BOUI	Bridge Design Supervisor R. SACCHI
Date 1/23/08	Date 1/23/08
PROJECT SWANTON	PROJECT NO. STP ST MHTB(II)
I.G.C. Info. ZD024BRG2.dgn	1/30/2008
Bridge Sheet No. BR3	Sheet 45 of 63