




15+10
END BRIDGE 15+06.72

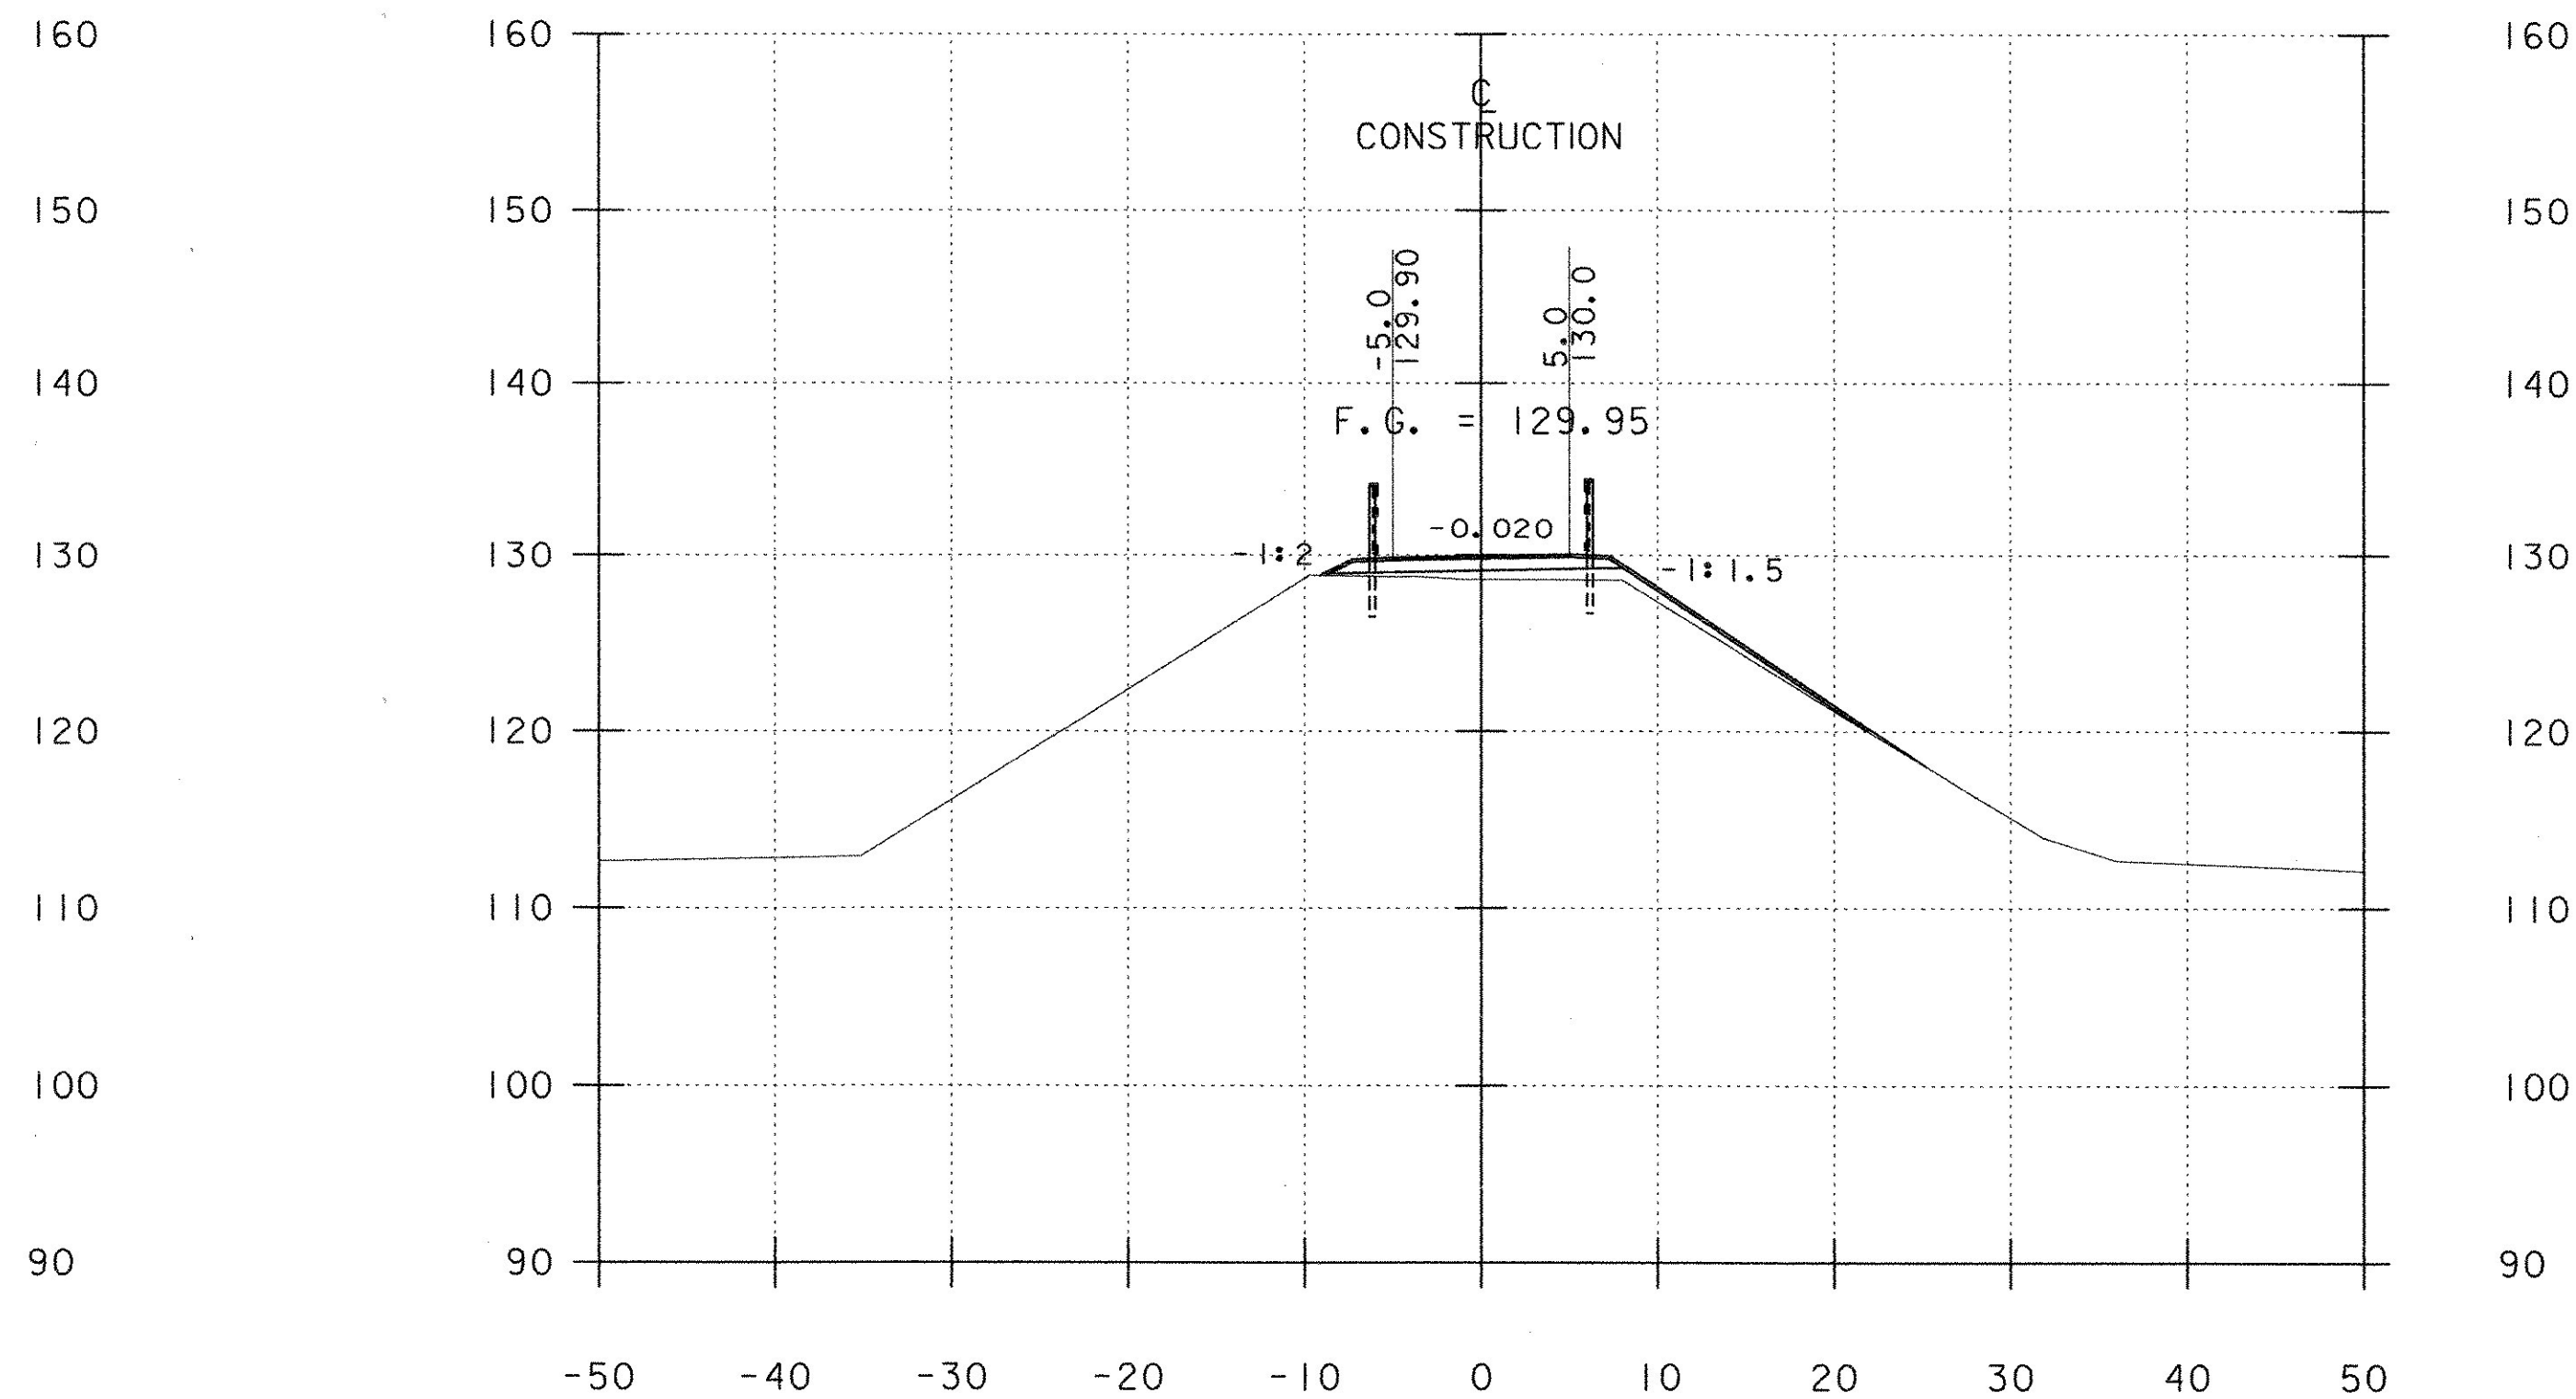

15+62
END PROJECT 16+17

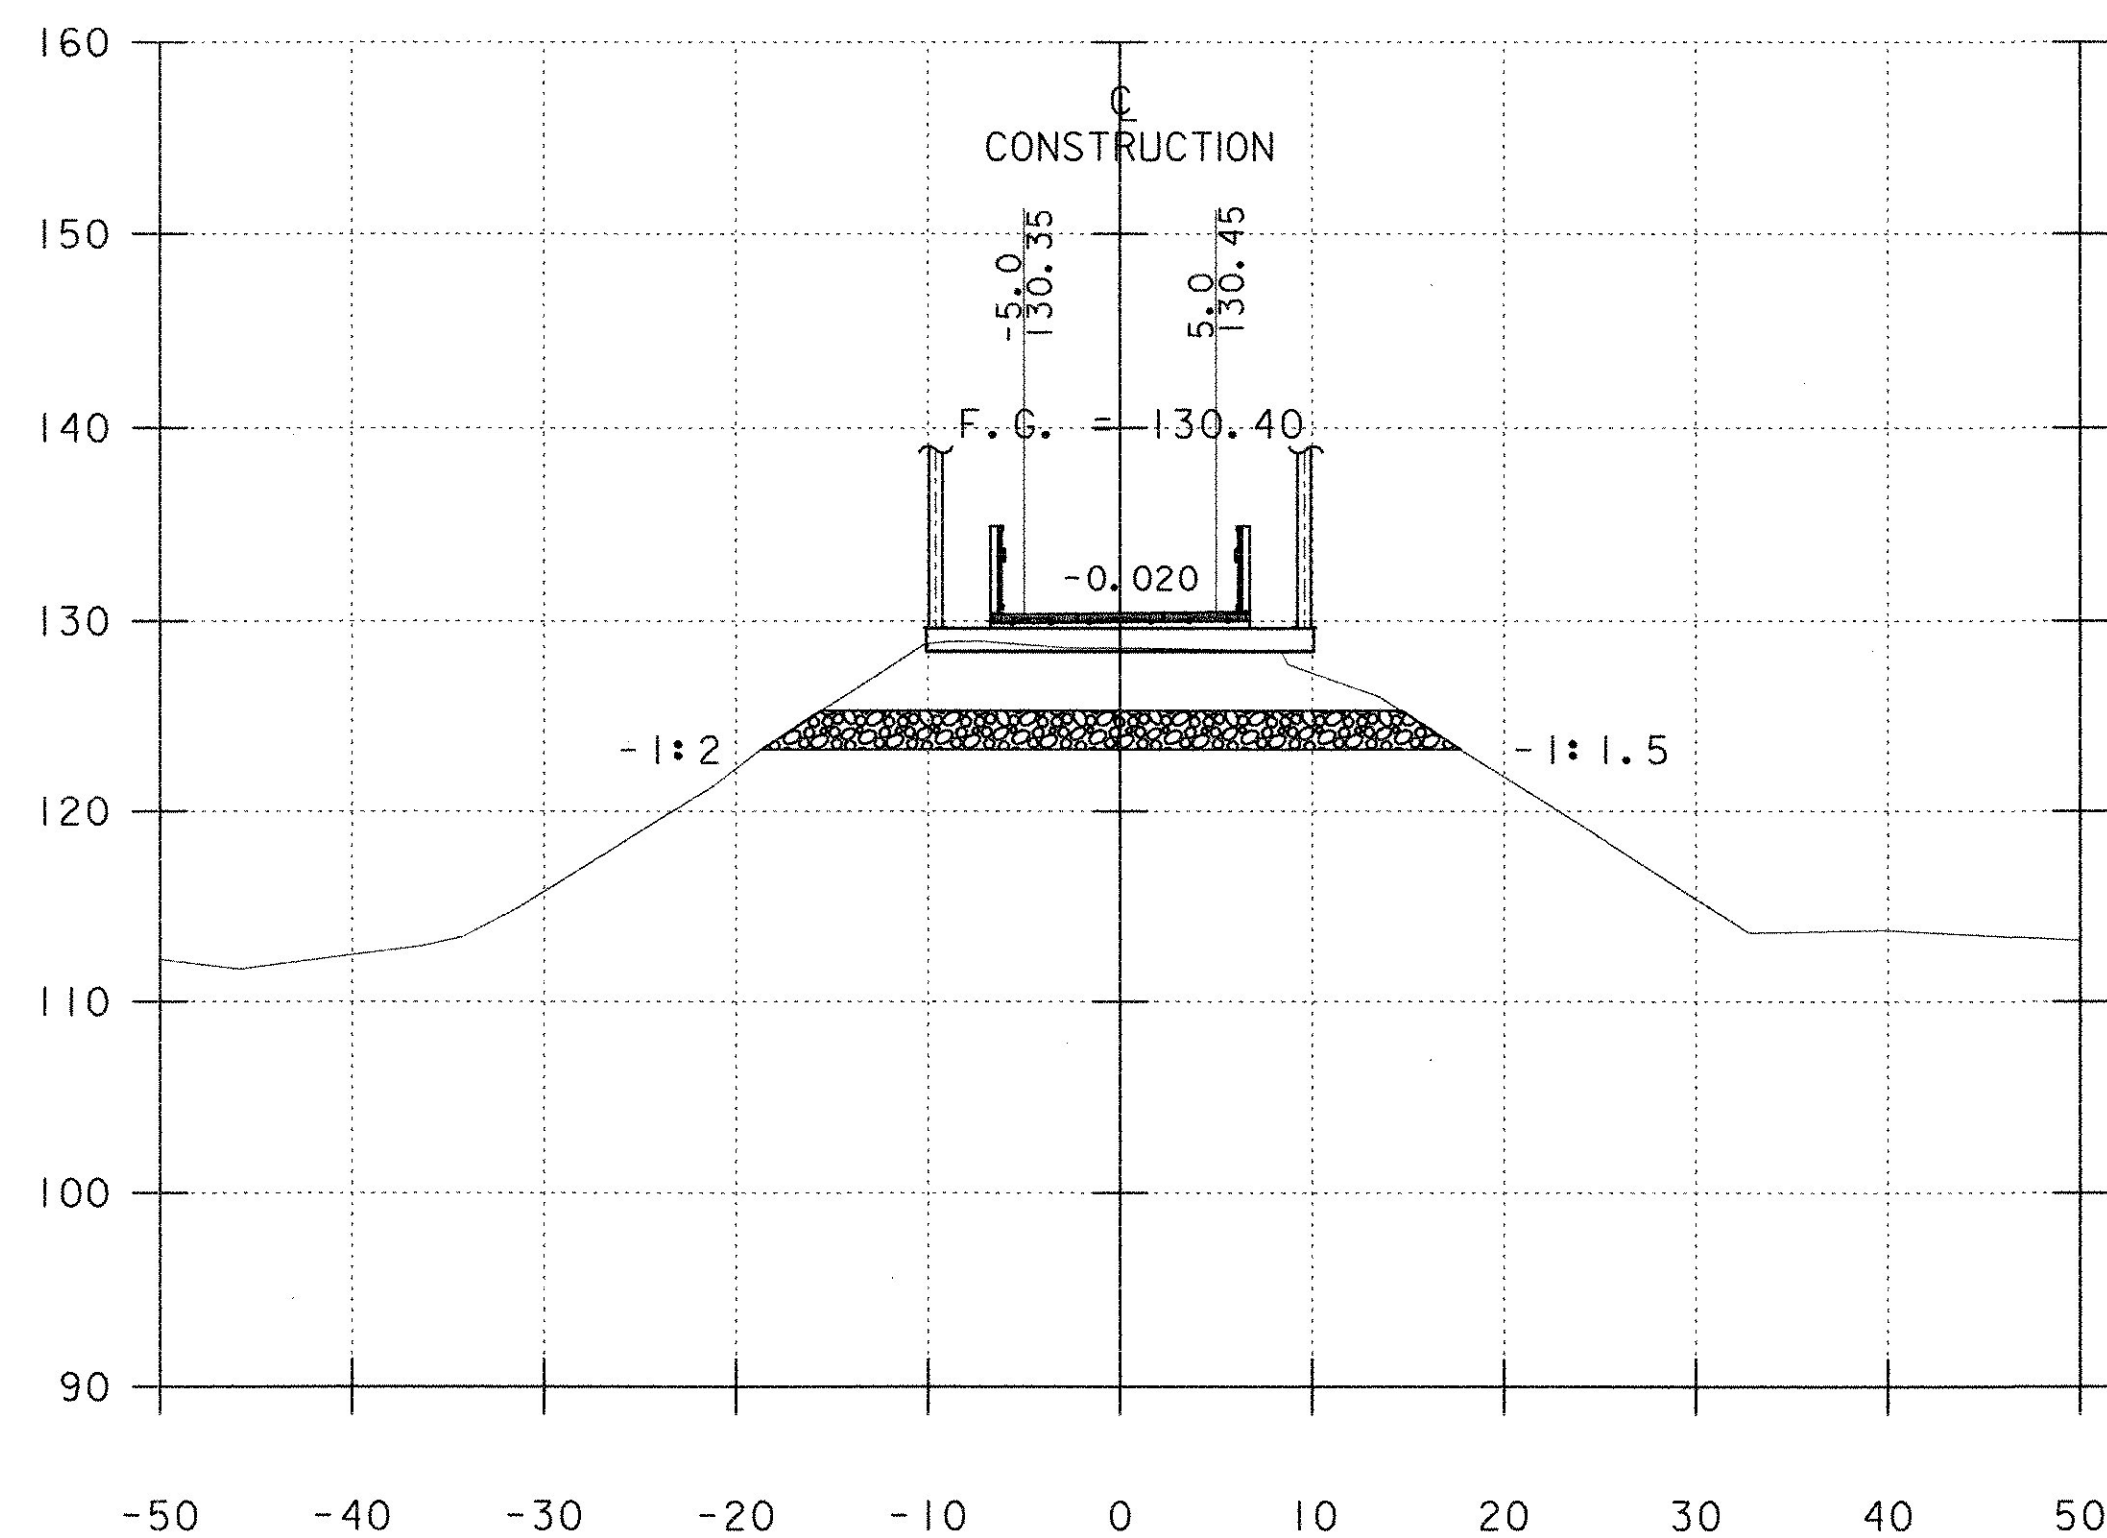

15+00

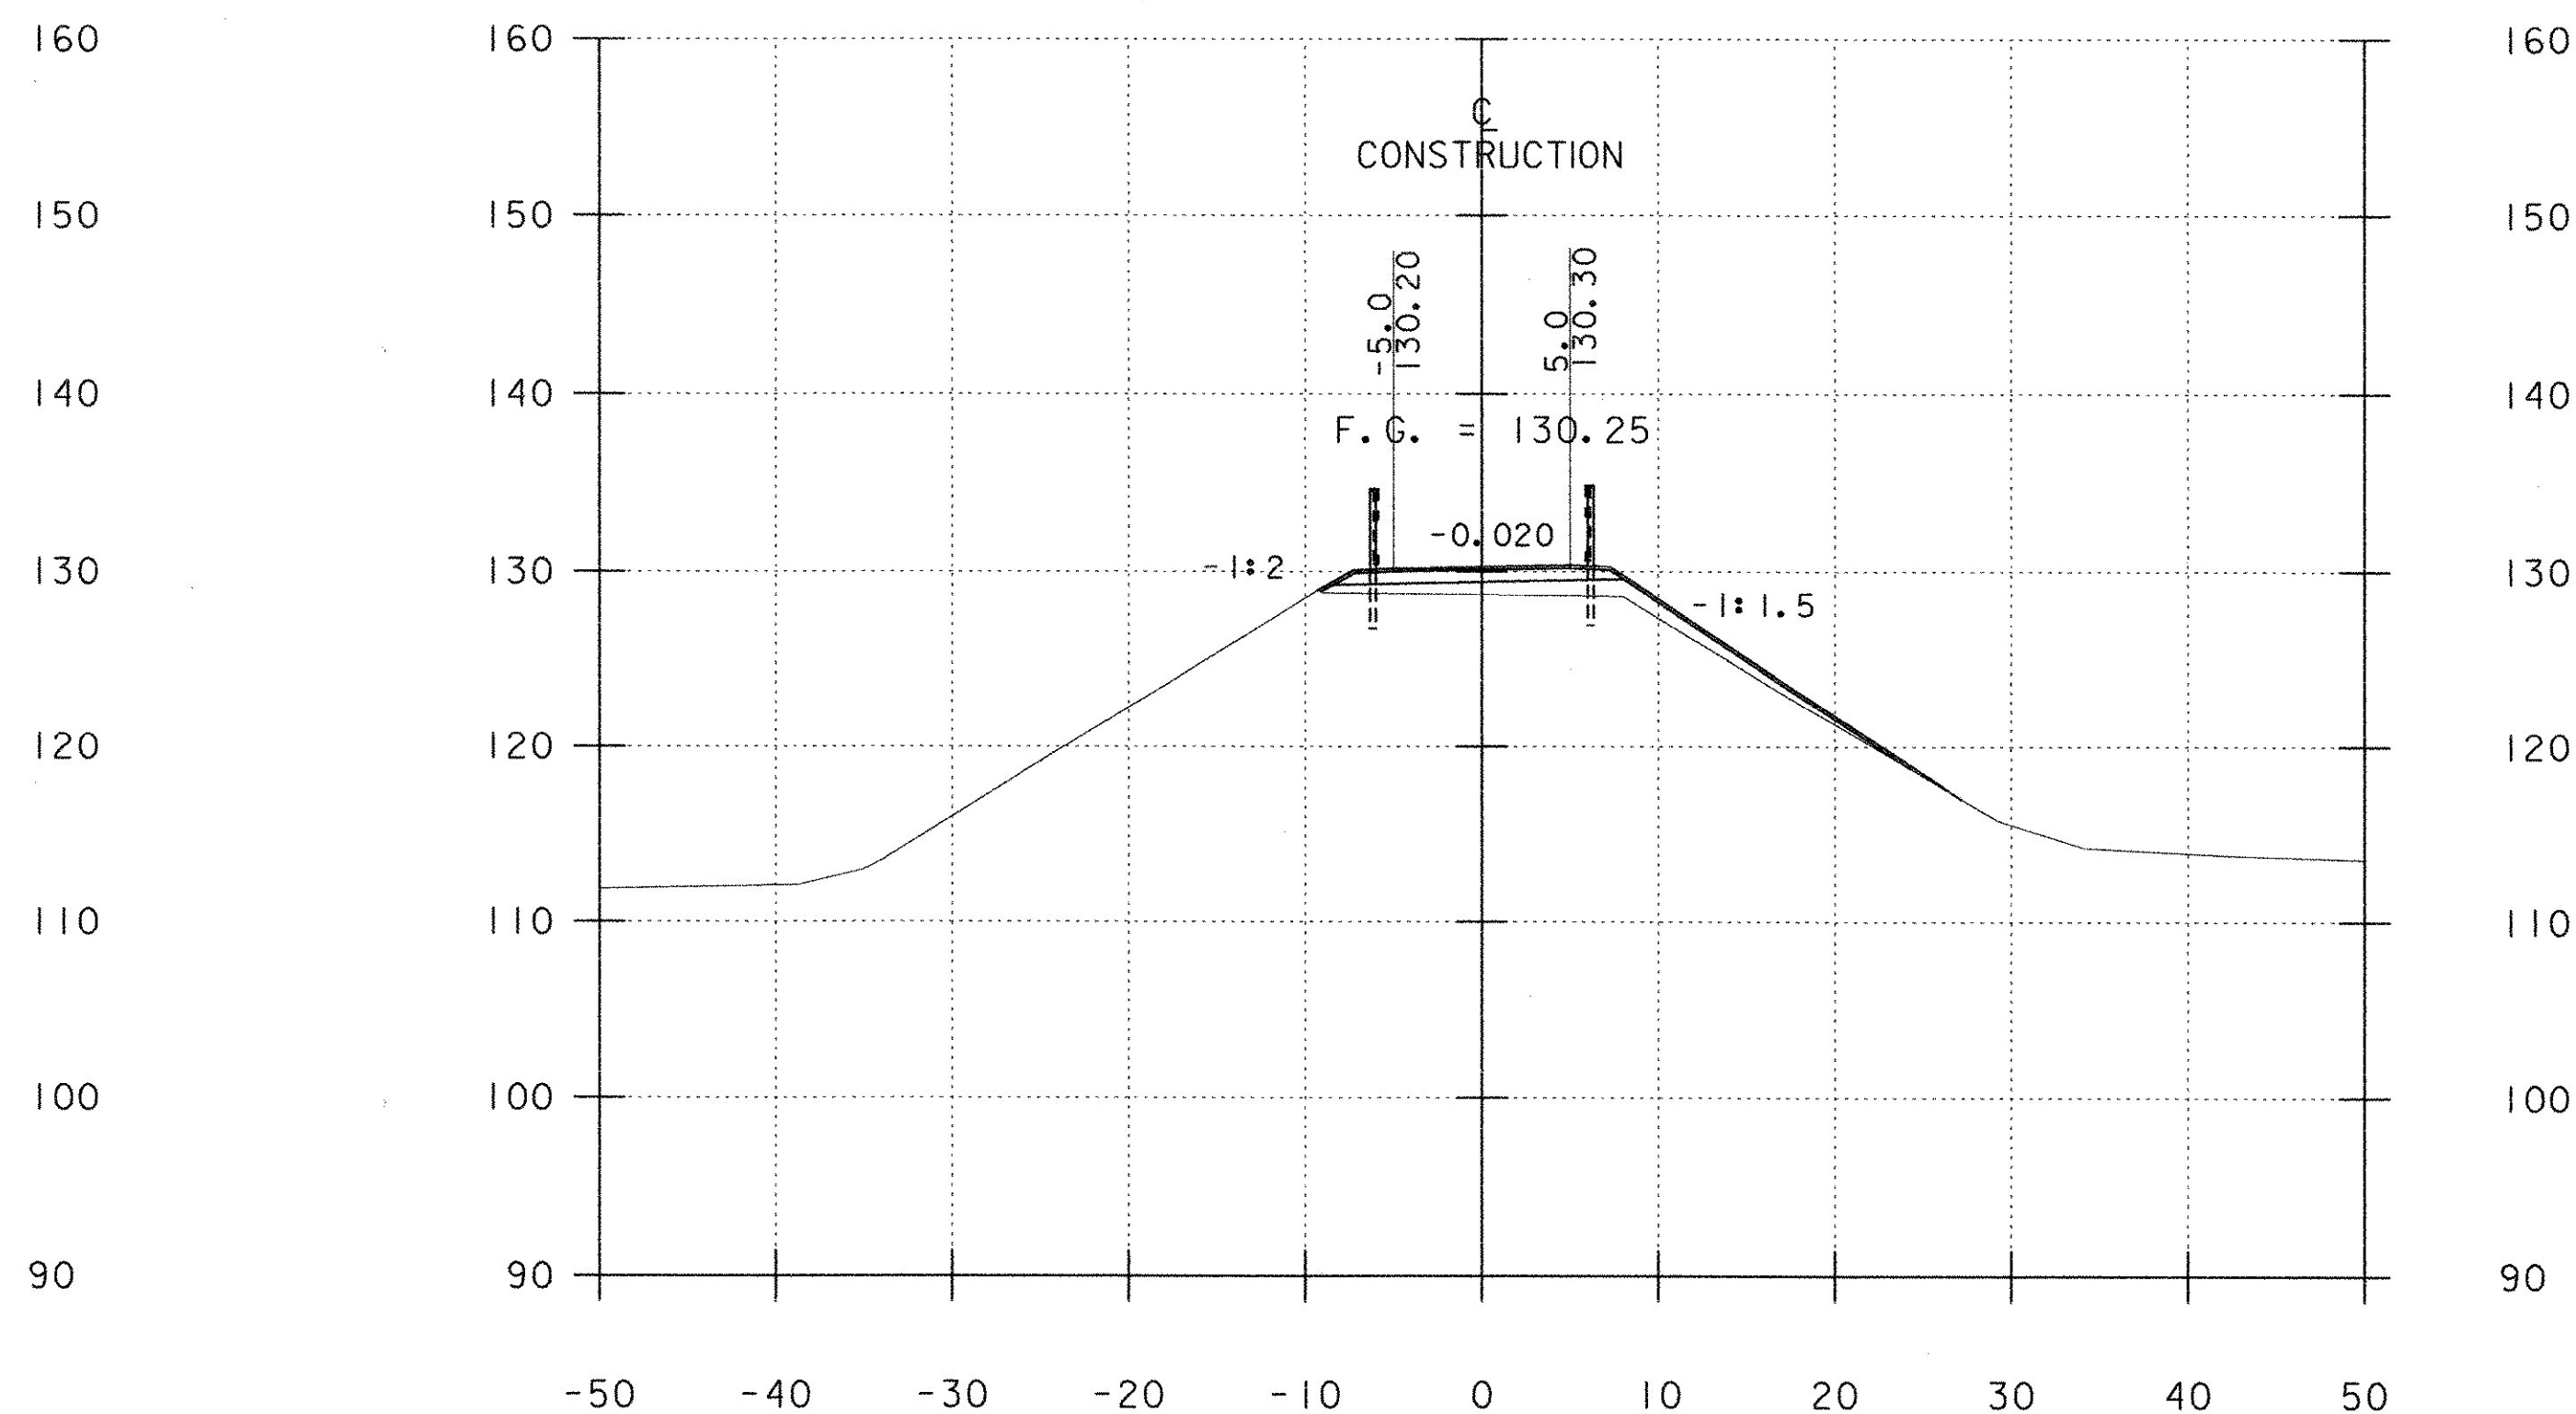

15+25

ROADWAY CROSS SECTIONS

SCALE: 1"=10' HORIZONTAL
1"=10' VERTICAL

DATUM
VERTICAL NGVD 1929
HORIZONTAL NAD 83

URS
URS CORPORATION
28 CORPORATE DRIVE, SUITE 200
CLIFTON PARK, NY 12065
PH# (518) 688-0015

SHEET NAME: ROADWAY CROSS SECTION - SHEET 3

PROJECT NAME: SWANTON
PROJECT NUMBER: STP ST MHTB(I)
FILE NAME: zd024rcs3.dgn
PROJECT LEADER: M. K. CHEVALIER
DESIGNED BY: B. ERNST
DRAWN BY: M. MCINTOSH
CHECKED BY: M. K. CHEVALIER
PLOT DATE: 2/13/2008
SHEET 60 OF 63

