



STA. 2+96.19 LT.  
 BEGIN UNCLASSIFIED CHANNEL EXCAVATION,  
 STONE FILL TYPE I, & GEOTEXTILE UNDER STONE FILL

3+00

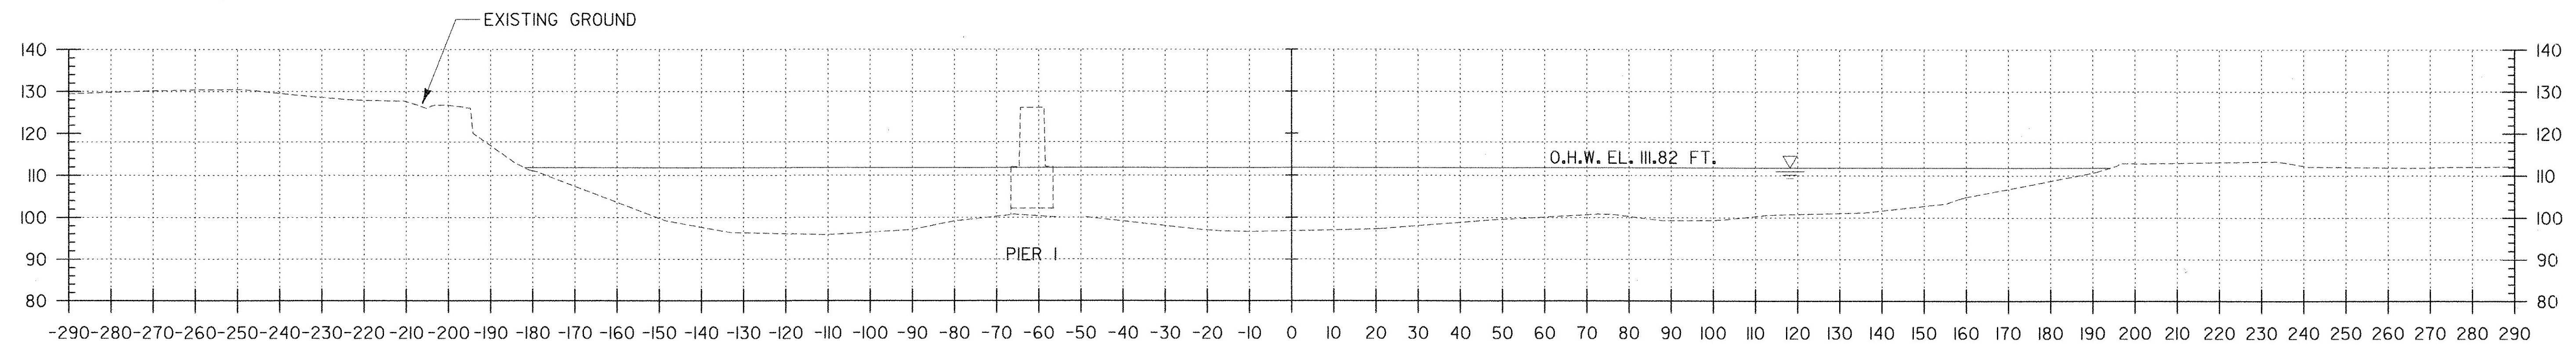


2+75

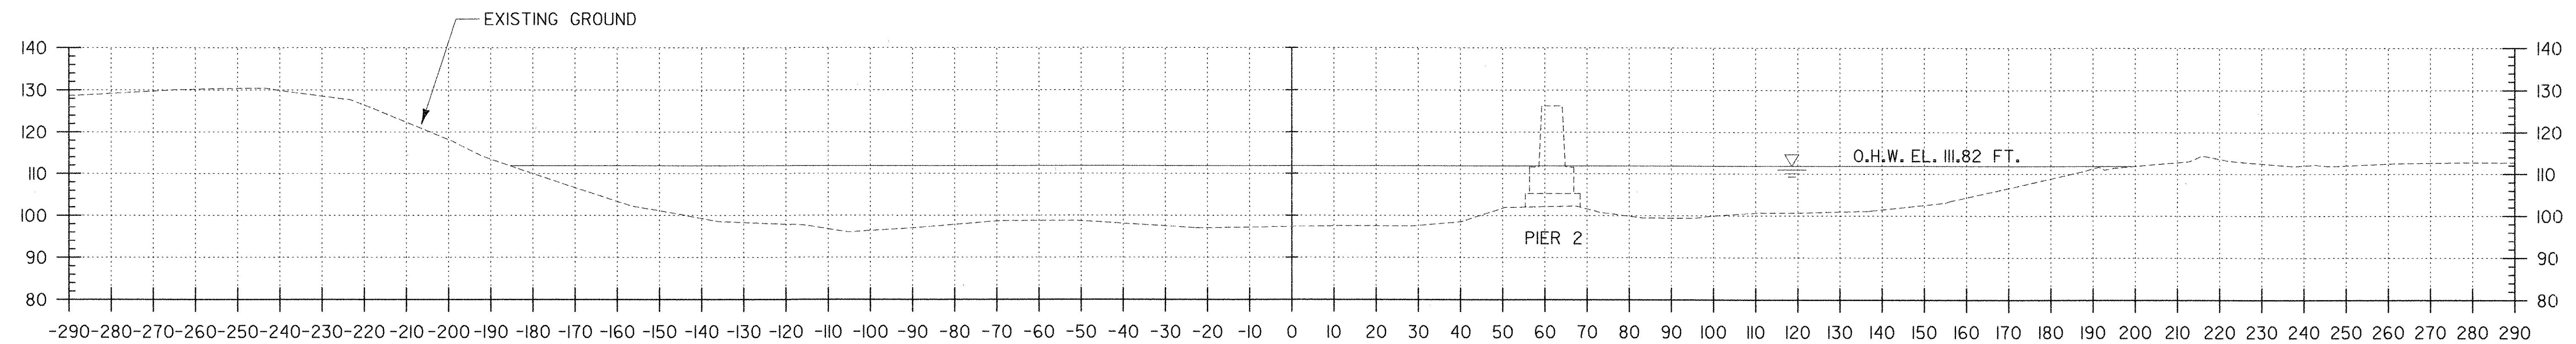

2+50

### CHANNEL CROSS SECTIONS

SCALE: 1"=20' HORIZONTAL  
 1"=20' VERTICAL

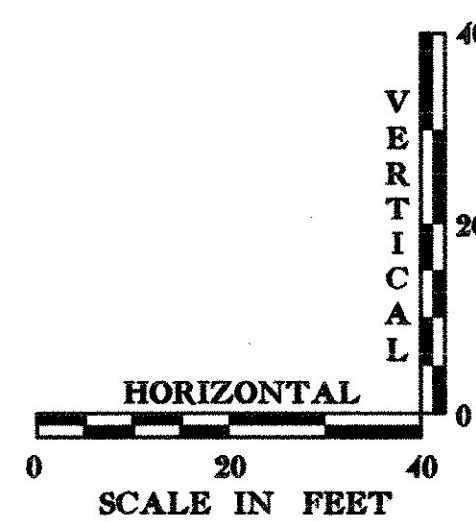

DATUM  
 VERTICAL NGVD 1929  
 HORIZONTAL NAD 83

**URS**  
 URS CORPORATION  
 28 CORPORATE DRIVE, SUITE 200  
 CLIFTON PARK, NY 12065  
 PH# (518) 688-0015

SHEET NAME: CHANNEL CROSS SECTION - SHEET 2	
PROJECT NAME: SWANTON	PROJECT NUMBER: STP ST MHTB(1)
FILE NAME: zd024scs2.dgn	PLOT DATE: 2/13/2008
PROJECT LEADER: M. K. CHEVALIER	DRAWN BY: M. MCINTOSH
DESIGNED BY: B. ERNST	CHECKED BY: M. K. CHEVALIER
	SHEET 62 OF 63