



TYPICAL CHANNEL SECTION
(NOT TO SCALE)

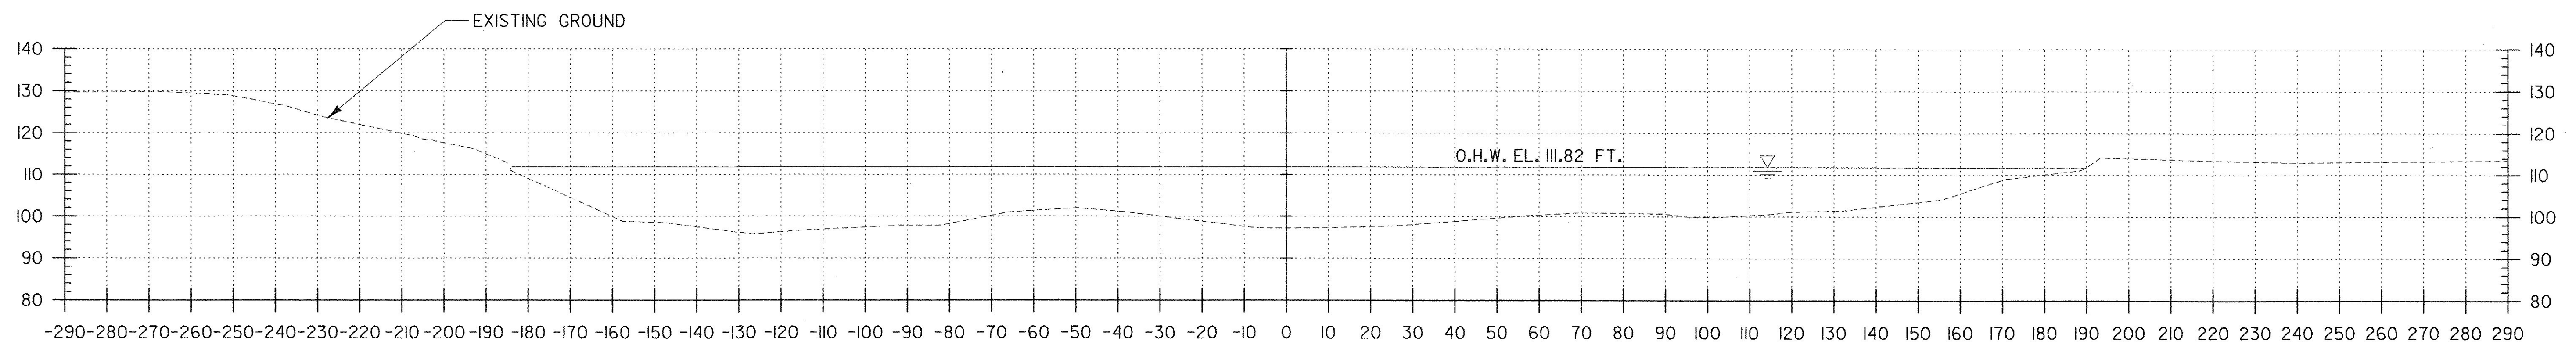

3+50

STA. 3+30.71 LT.
END UNCLASSIFIED CHANNEL EXCAVATION,
STONE FILL TYPE I, & GEOTEXTILE UNDER STONE FILL

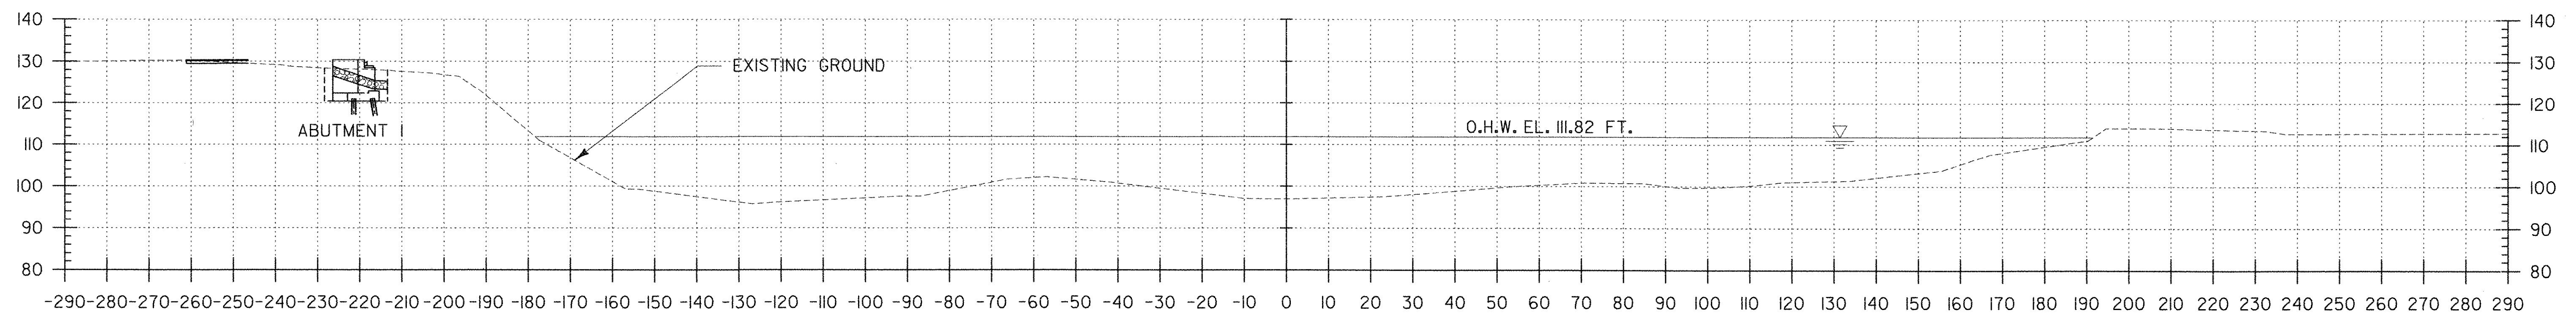


3+25

CHANNEL CROSS SECTIONS

SCALE: 1"=20' HORIZONTAL
1"=20' VERTICAL

DATUM
VERTICAL NGVD 1929
HORIZONTAL NAD 83

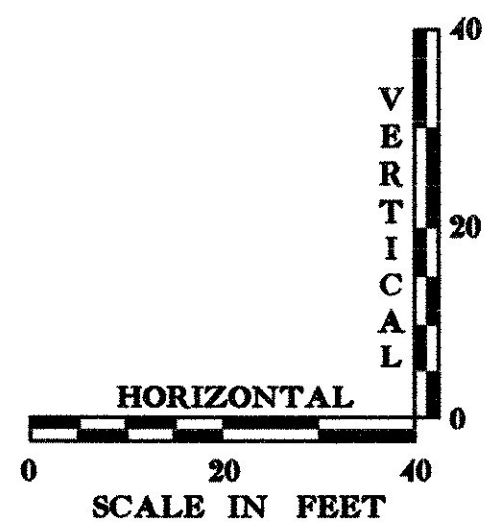

URS
URS CORPORATION
28 CORPORATE DRIVE, SUITE 200
CLIFTON PARK, NY 12065
PH# (518) 688-0015

SHEET NAME: CHANNEL CROSS SECTION - SHEET 3

PROJECT NAME: SWANTON
PROJECT NUMBER: STP ST MHTB(I)

FILE NAME: zd024scs3.dgn
PROJECT LEADER: M. K. CHEVALIER
DESIGNED BY: B. ERNST

PLOT DATE: 2/13/2008
DRAWN BY: M. MCINTOSH
CHECKED BY: M. K. CHEVALIER
SHEET 63 OF 63