


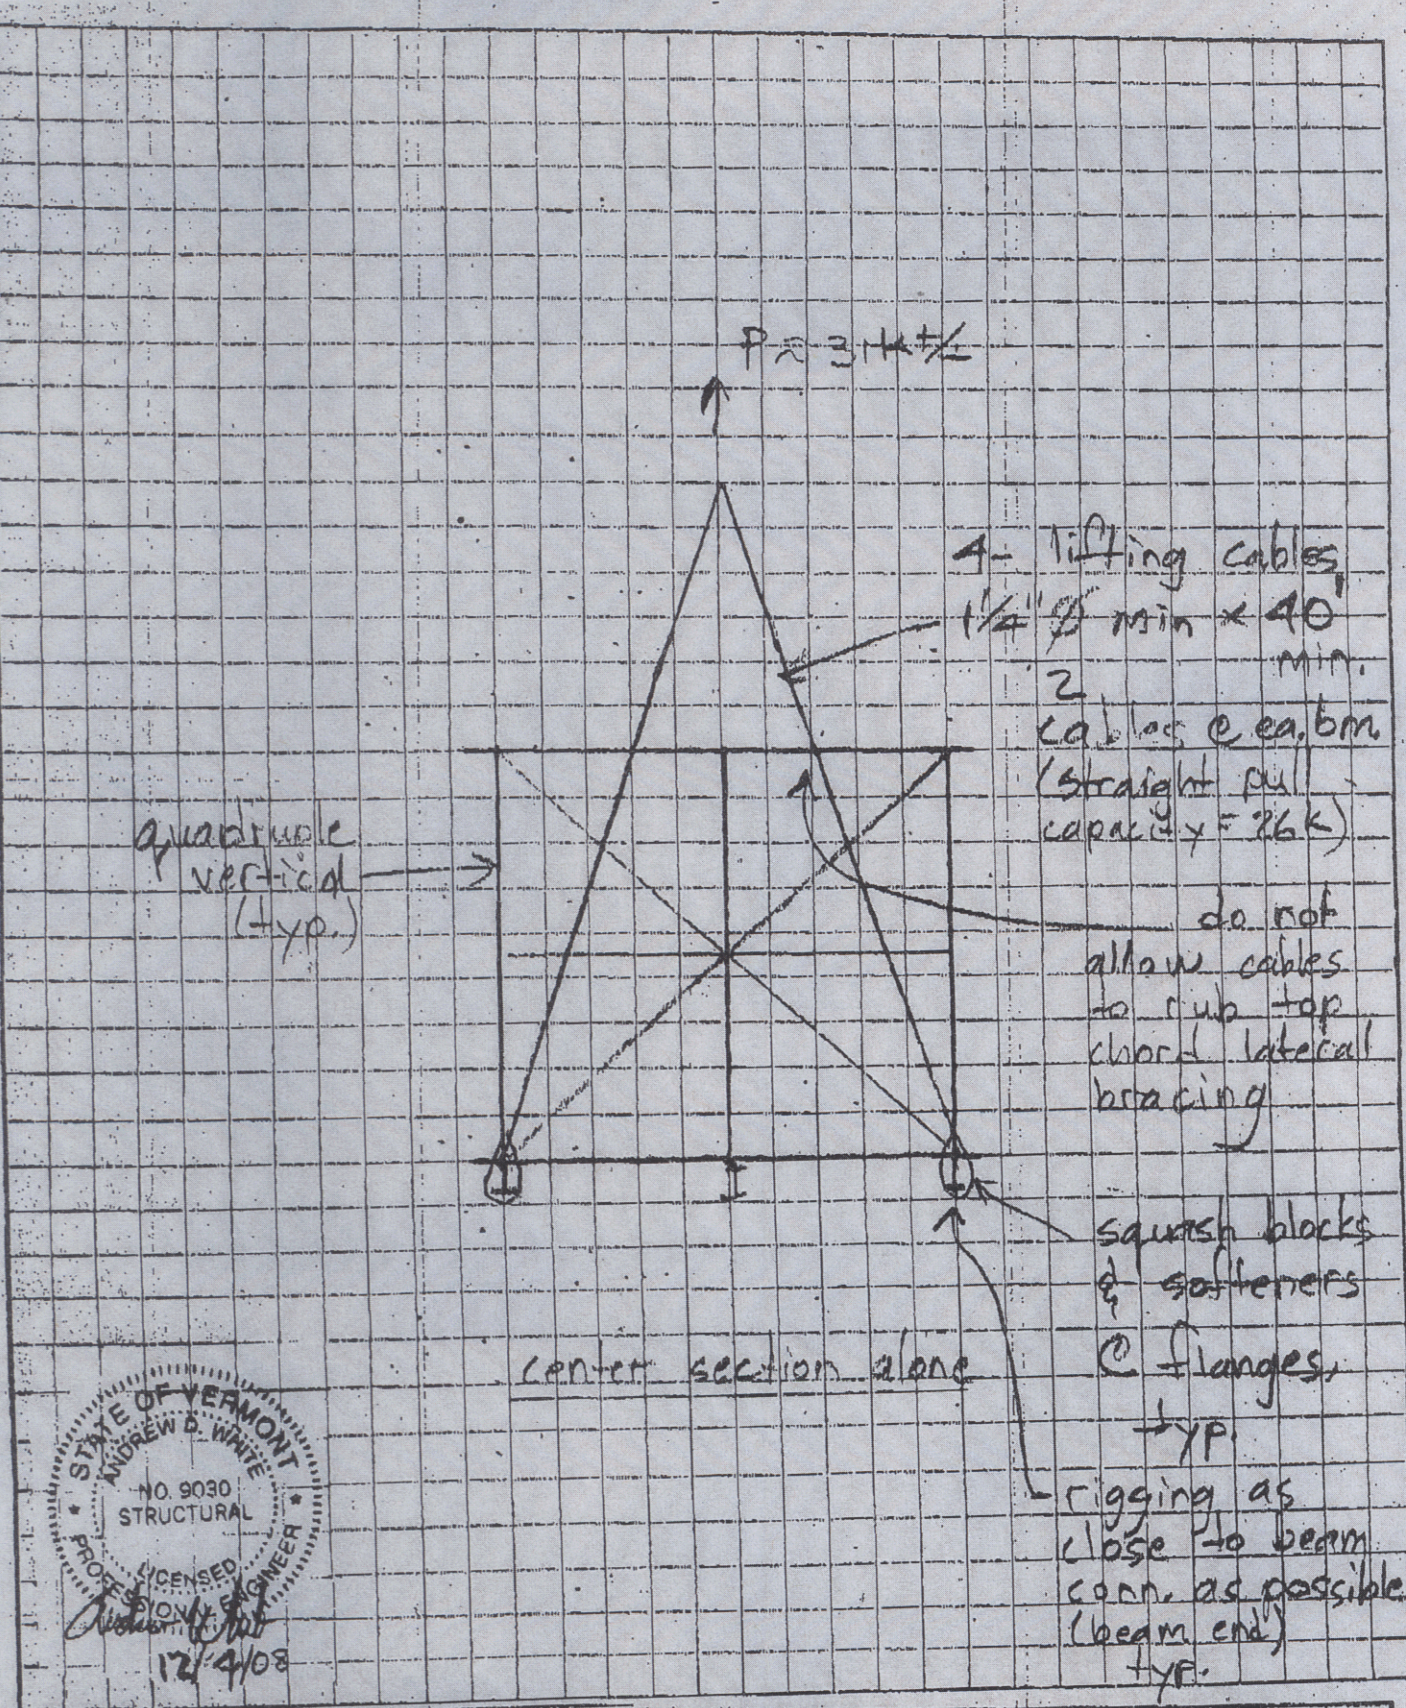

CCS CONSTRUCTORS, LLC
138 MUNSON AVE.
MORRISVILLE, VT 05661
PH. 802-888-7701
FX. 802-888-4746

PROJECT NAME	PROJECT NO.
Swanton	STP ST MMB(1)
Alt. Pick	DRAWING NO.
SCALE	R1-3 Alt.