


Town of Swanton, Vermont  
Franklin County  
123'-2" x 12'-0" Pedestrian Bridge



37.0 K Total Bridge  
Lifting weight - Does not  
include deck or rails

Total of  
4 places  
- lifting cables  
and rigging by others

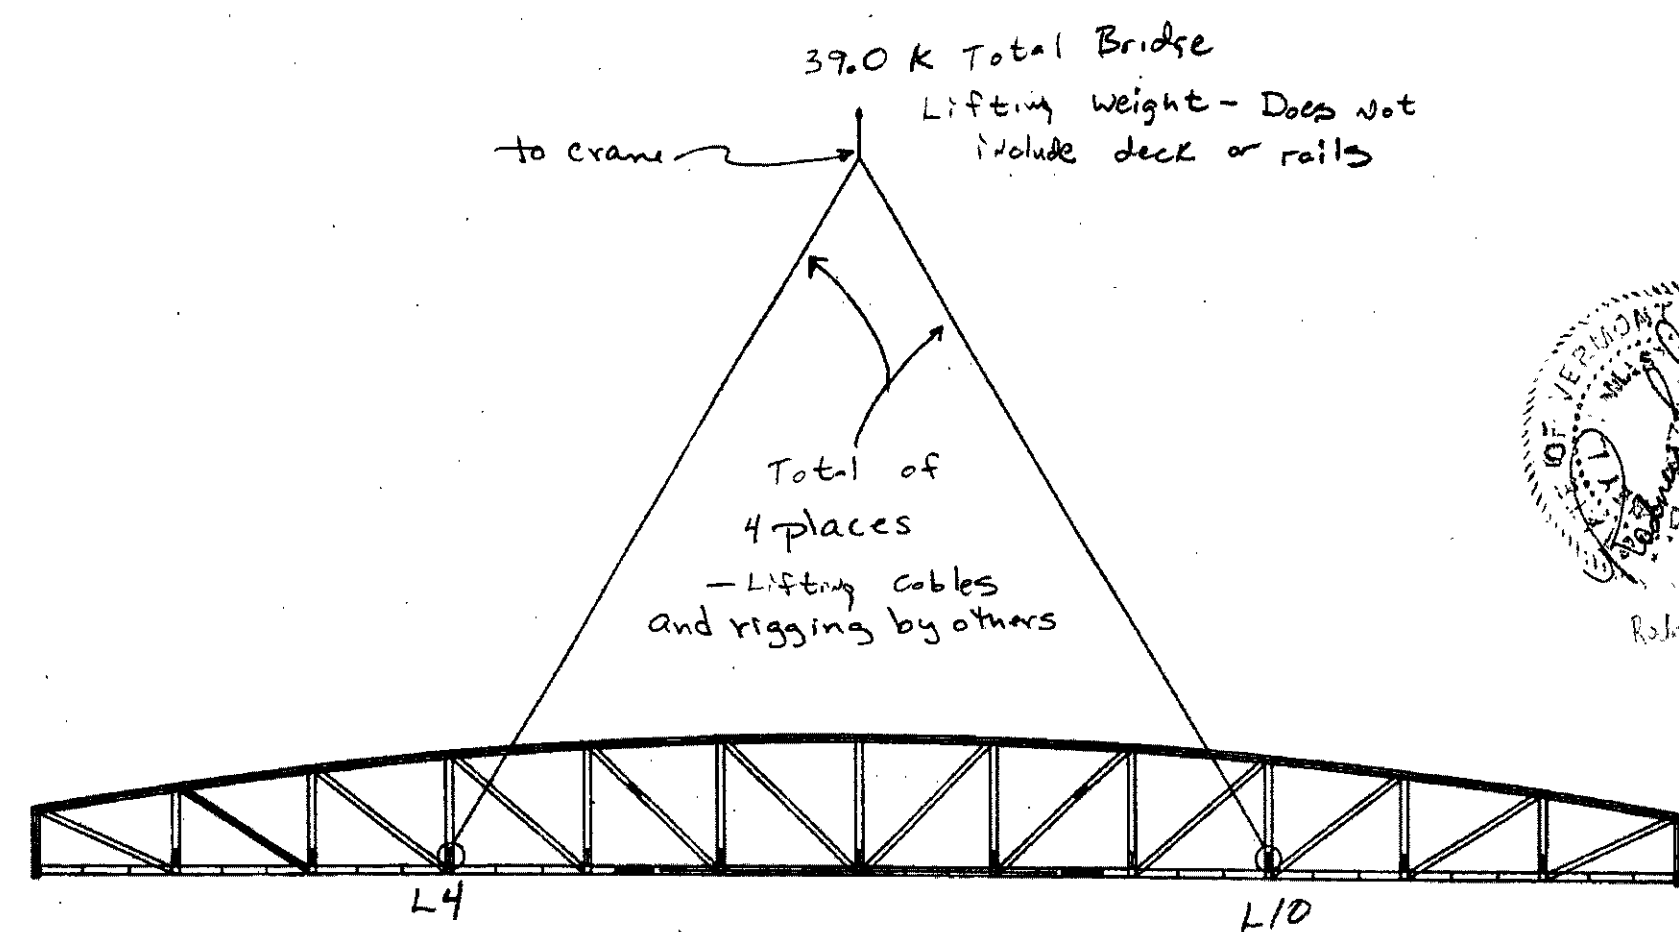

Robby Lee Lemasters  
# 6179