



**SPAN 1**

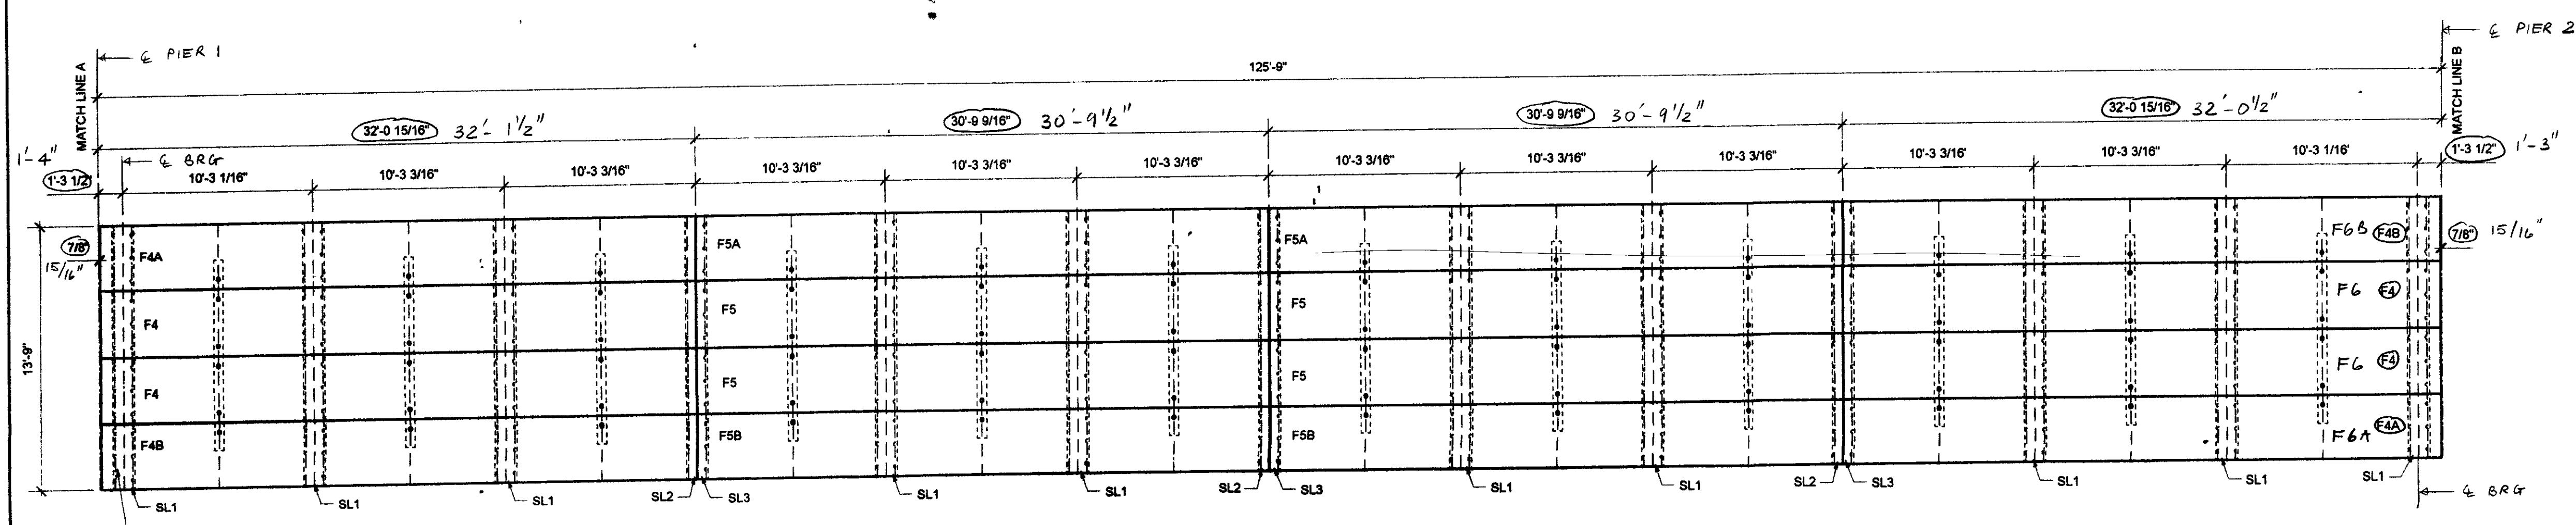

**SPAN 2**

ALL DIMENSIONS FOR THE HISTORIC TRUSS ARE BASED ON LIMITED FIELD MEASUREMENTS. THE CONTRACTOR SHALL FIELD VERIFY THESE DIMENSIONS FOR PROPER FIT.

END DECK PANELS ON SPAN 2 WILL REQUIRE SOME CUTTINGS TO AVOID CONFLICT WITH PRE FAB TRUSS END POSTS.

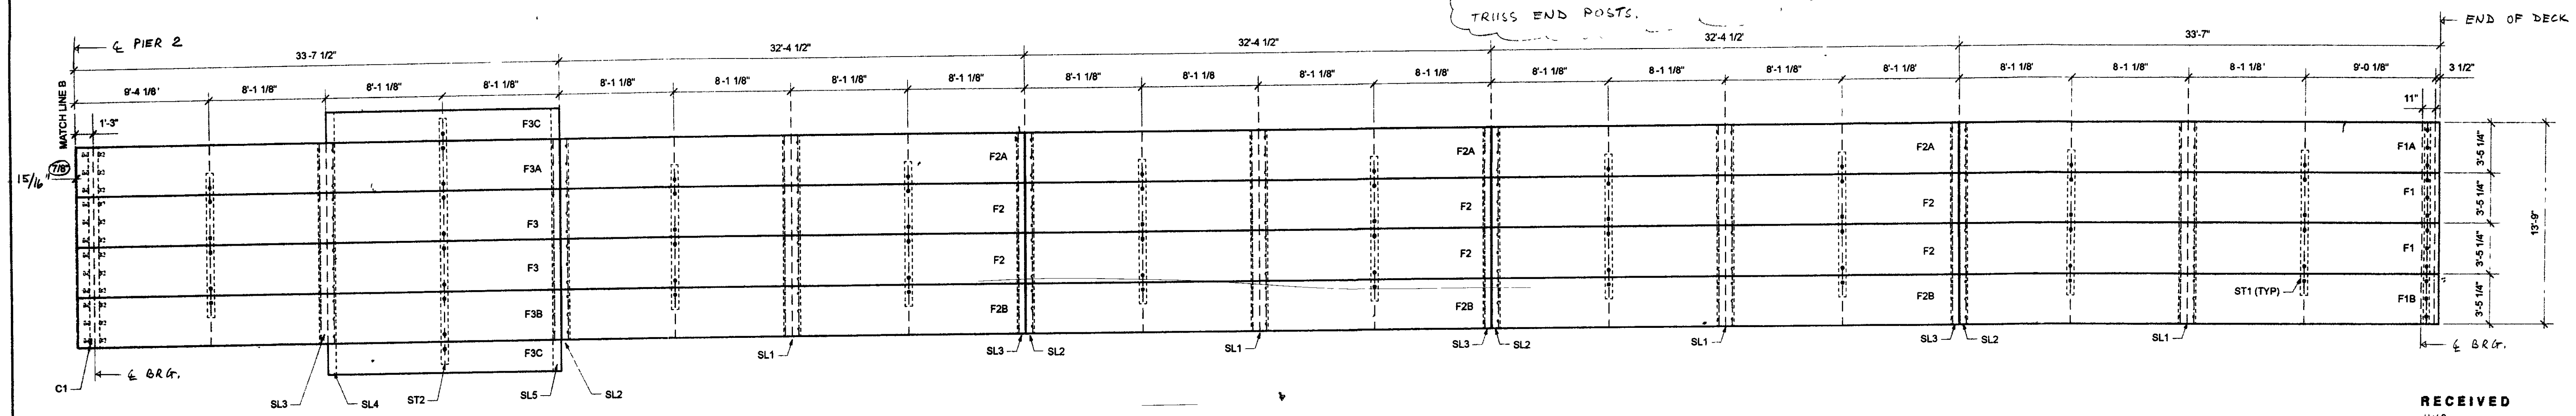

**SPAN 3**

**RECEIVED**  
 CKD BY HKS OK'D BY \_\_\_\_\_  
 JUL 31 2003  
 RESUBMIT \_\_\_\_\_ APPROVED   
 BY RGS DATE 8/6/03

**CCS Constructors LLC**  
 138 Munson Avenue  
 Morrisville, VT 05661  
 Ph: 802-888-7701 | 802-888-4746



P.O. BOX 369  
 3310 STATE RTE 352  
 BIG FLATS, NEW YORK 14814  
 PHONE 607 562 8110  
 FAX 607 562 8105

DRAWN	MSS	DATE	REVISIONS			
			NO	DATE	BY	REVISIONS
CHKD		6/3/08	1	7/21/08	SS	REVISE PANELS
APPD						
SCALE						

PROJECT NAME	STP ST MHTB(I) BRIDGE NO 18 TOWN OF SWANTON COUNTY OF FRANKLIN, VERMONT	PROJECT JOB NO	1008-460-LT
PREPARED FOR	CCS CONSTRUCTORS, LLC, MORRISVILLE, VT	SHEET NO	1 OF 3