
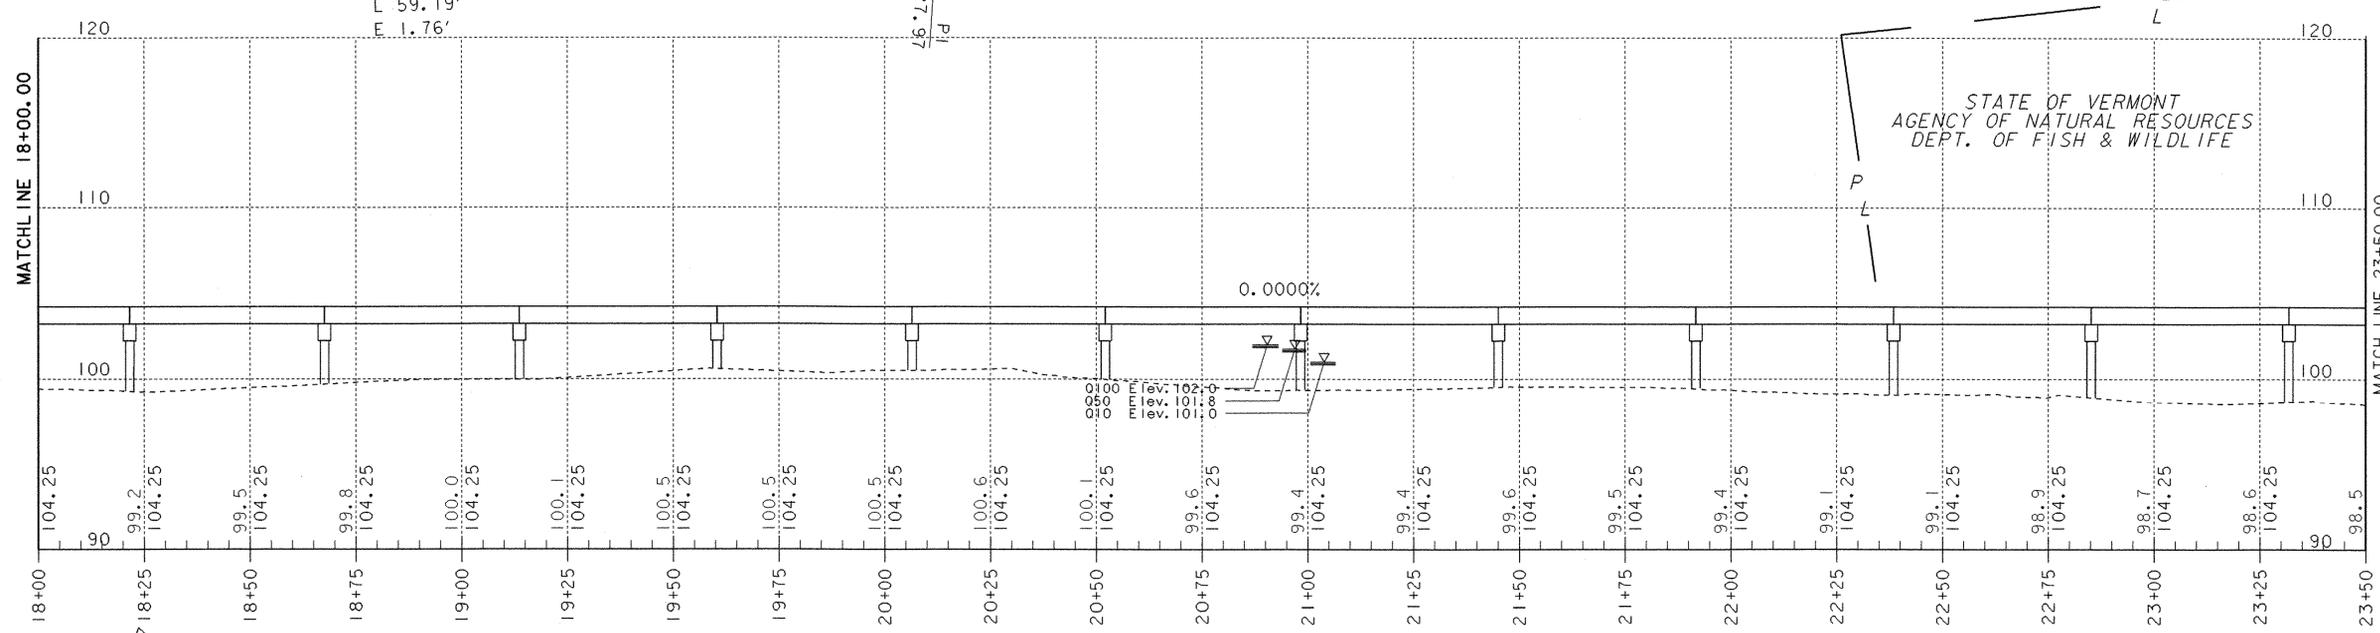
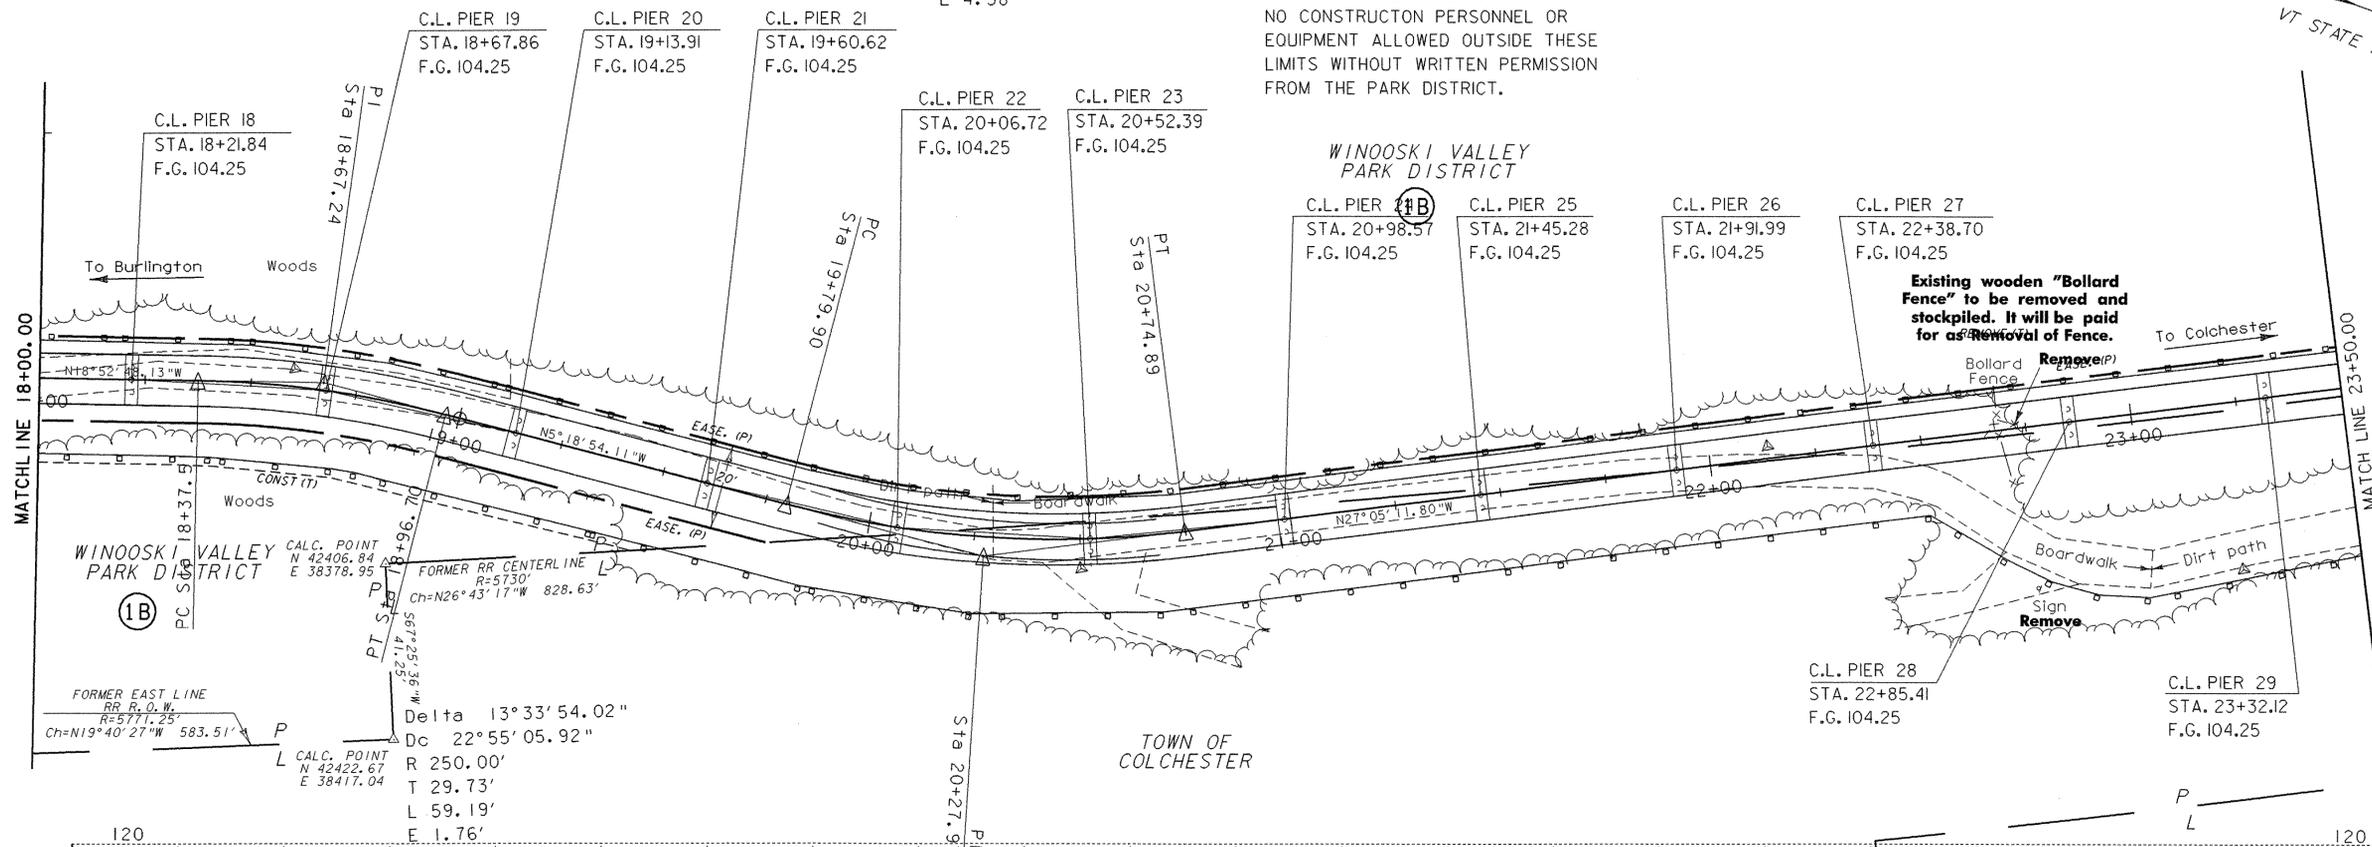


Delta 21°46'17.69"
 Dc 22°55'05.92"
 R 250.00'
 T 48.08'
 L 95.00'
 E 4.58'


WET LAND LIMITS
 SILT FENCE
 SNOW FENCE
 NO CONSTRUCTION PERSONNEL OR EQUIPMENT ALLOWED OUTSIDE THESE LIMITS WITHOUT WRITTEN PERMISSION FROM THE PARK DISTRICT.

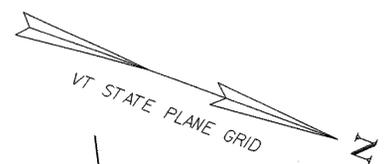

FOR R.O.W. USE ONLY

STATE OF VERMONT
 AGENCY OF NATURAL RESOURCES
 DEPT. OF FISH & WILDLIFE

LINES SHOWN ON THIS PLAN AS EXISTING PROPERTY LINES P/L ARE BELIEVED TO BE ACCURATE BUT SHOULD NOT BE RELIED UPON FOR PURPOSES UNRELATED TO THE CITY OF BURLINGTON AND TOWN OF COLCHESTER'S ACQUISITION OF LAND AND RIGHTS FOR THIS PROJECT.

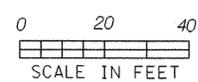

PROJECT NAME: Burlington - Colchester
 PROJECT NUMBER: STP Bike(45)
 FILE NAME: \str5\01f132\sf132bdr.dgn PLOT DATE: 05-AUG-2003
 PROJECT LEADER: C. Keller DRAWN BY: G. Shangraw
 DESIGNED BY: M. Evans-Mongeon CHECKED BY:
 R.O.W. SHEET 8 OF 9 SHEETS SHEET 19 OF 87