


WET LAND LIMITS  
 X SILT FENCE  
 SNOW FENCE  
 NO CONSTRUCTION PERSONNEL OR EQUIPMENT ALLOWED OUTSIDE THESE LIMITS WITHOUT WRITTEN PERMISSION FROM THE PARK DISTRICT.

STATE OF VERMONT  
 AGENCY OF NATURAL RESOURCES  
 DEPT. OF FISH & WILDLIFE


Existing wooden "Bollard Fence" to be removed and stockpiled. It will be paid for as Removal of Fence.

**28+62.00**  
**END PROJECT**  
**COLCHESTER**  
**STP BIKE(48)**

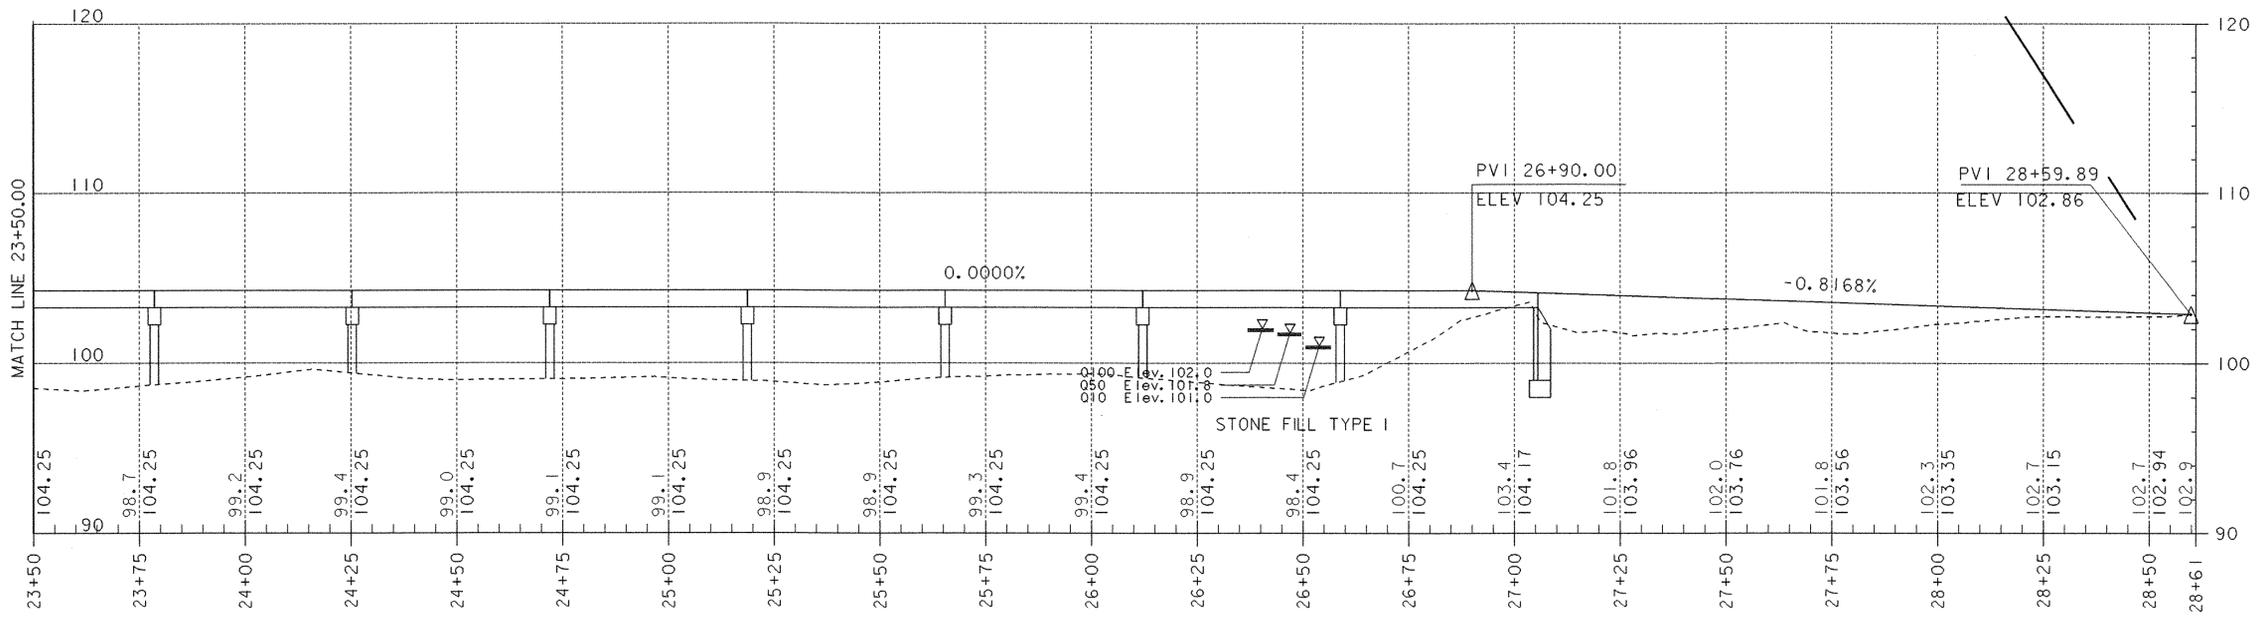

**FOR R.O.W.**  
**USE ONLY**

LINES SHOWN ON THIS PLAN AS EXISTING PROPERTY LINES P/L ARE BELIEVED TO BE ACCURATE BUT SHOULD NOT BE RELIED UPON FOR PURPOSES UNRELATED TO THE CITY OF BURLINGTON AND TOWN OF COLCHESTER'S ACQUISITION OF LAND AND RIGHTS FOR THIS PROJECT.

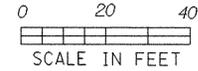

PROJECT NAME:	Burlington - Colchester
PROJECT NUMBER:	STP Bike(45)
FILE NAME:	\\str5\01f132\sf132bdr.dgn
DESIGNED BY:	M. Evans-Mongeon
PROJECT LEADER:	C. Keller
DRAWN BY:	G. Shangraw
R. O. W. SHEET 9 OF 9 SHEETS	SHEET 20 OF 87
PLLOT DATE:	05-AUG-2003
CHECKED BY:	