

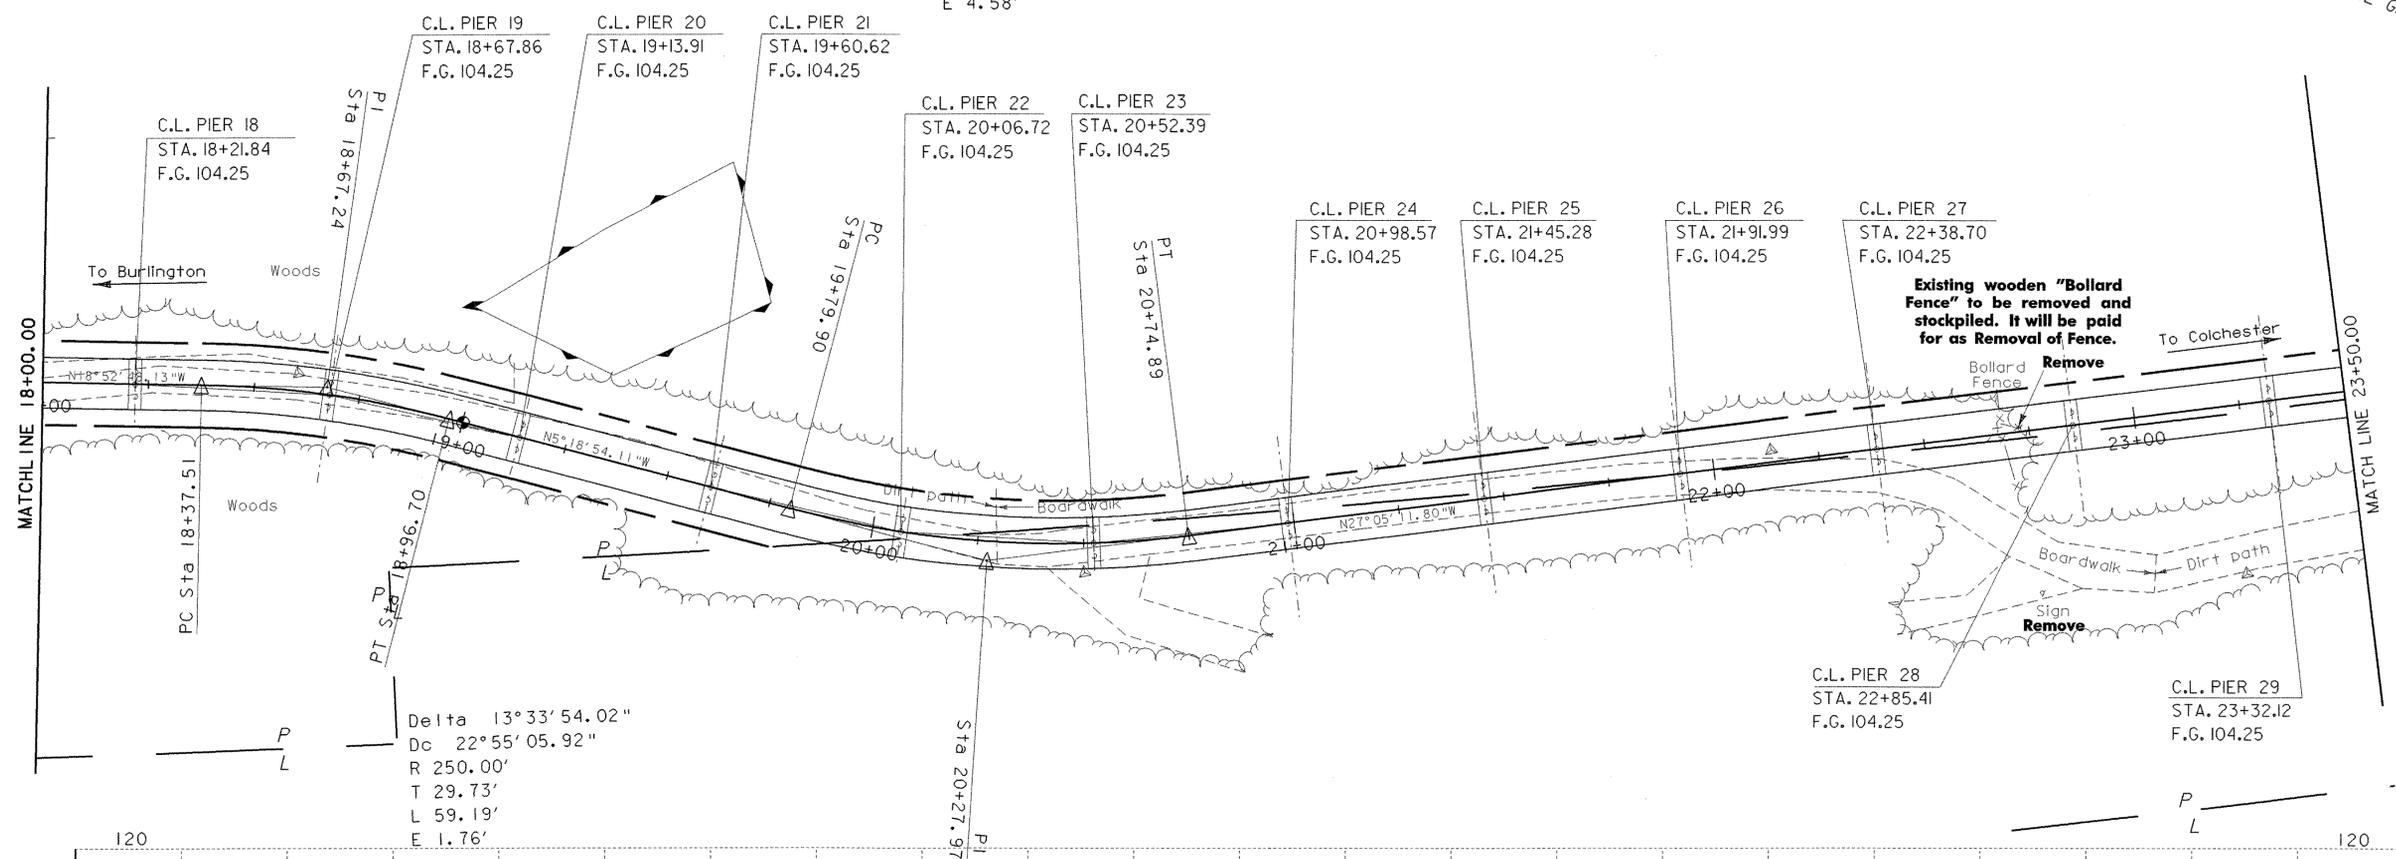


Delta 21°46'17.69"
 Dc 22°55'05.92"
 R 250.00'
 T 48.08'
 L 95.00'
 E 4.58'

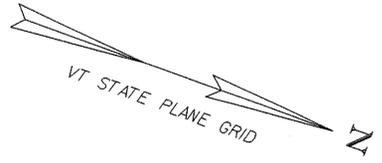

Delta 13°33'54.02"
 Dc 22°55'05.92"
 R 250.00'
 T 29.73'
 L 59.19'
 E 1.76'

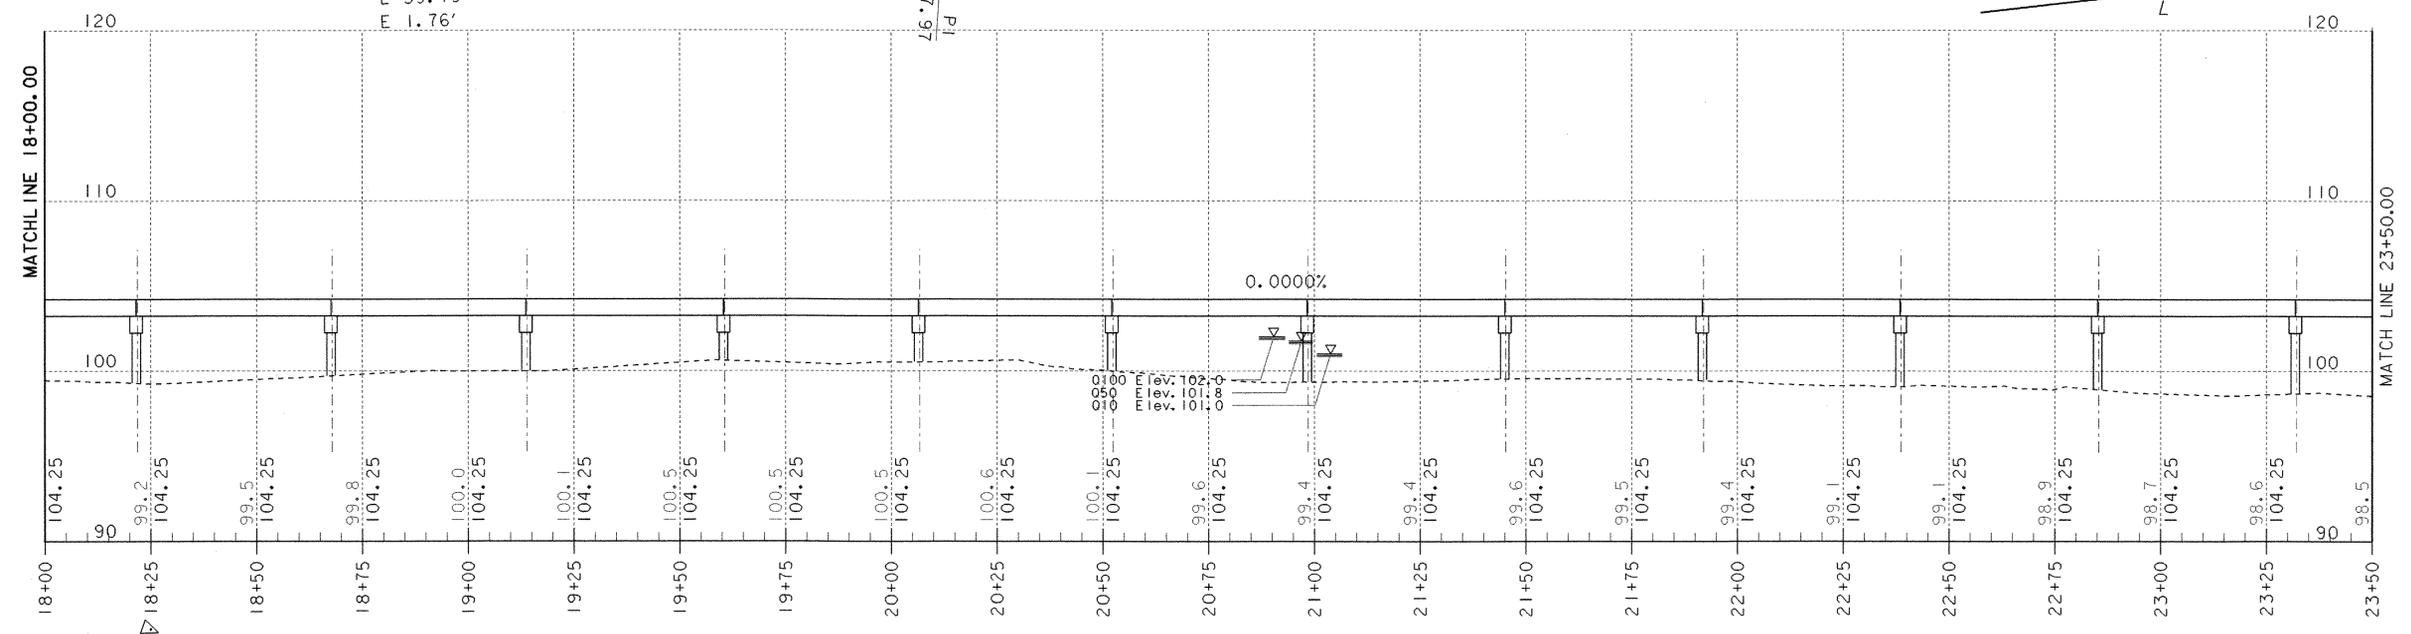

PROJECT NAME: Colchester
 PROJECT NUMBER: STP Bike(48)
 FILE NAME: /str5/03f038/sf038bdr.dgn PLOT DATE: 05-AUG-2003
 PROJECT LEADER: C. Keller DRAWN BY: G. Shangraw
 DESIGNED BY: M. Evans-Mongeon CHECKED BY:
 sf038L3.I SHEET 24 OF 87

