
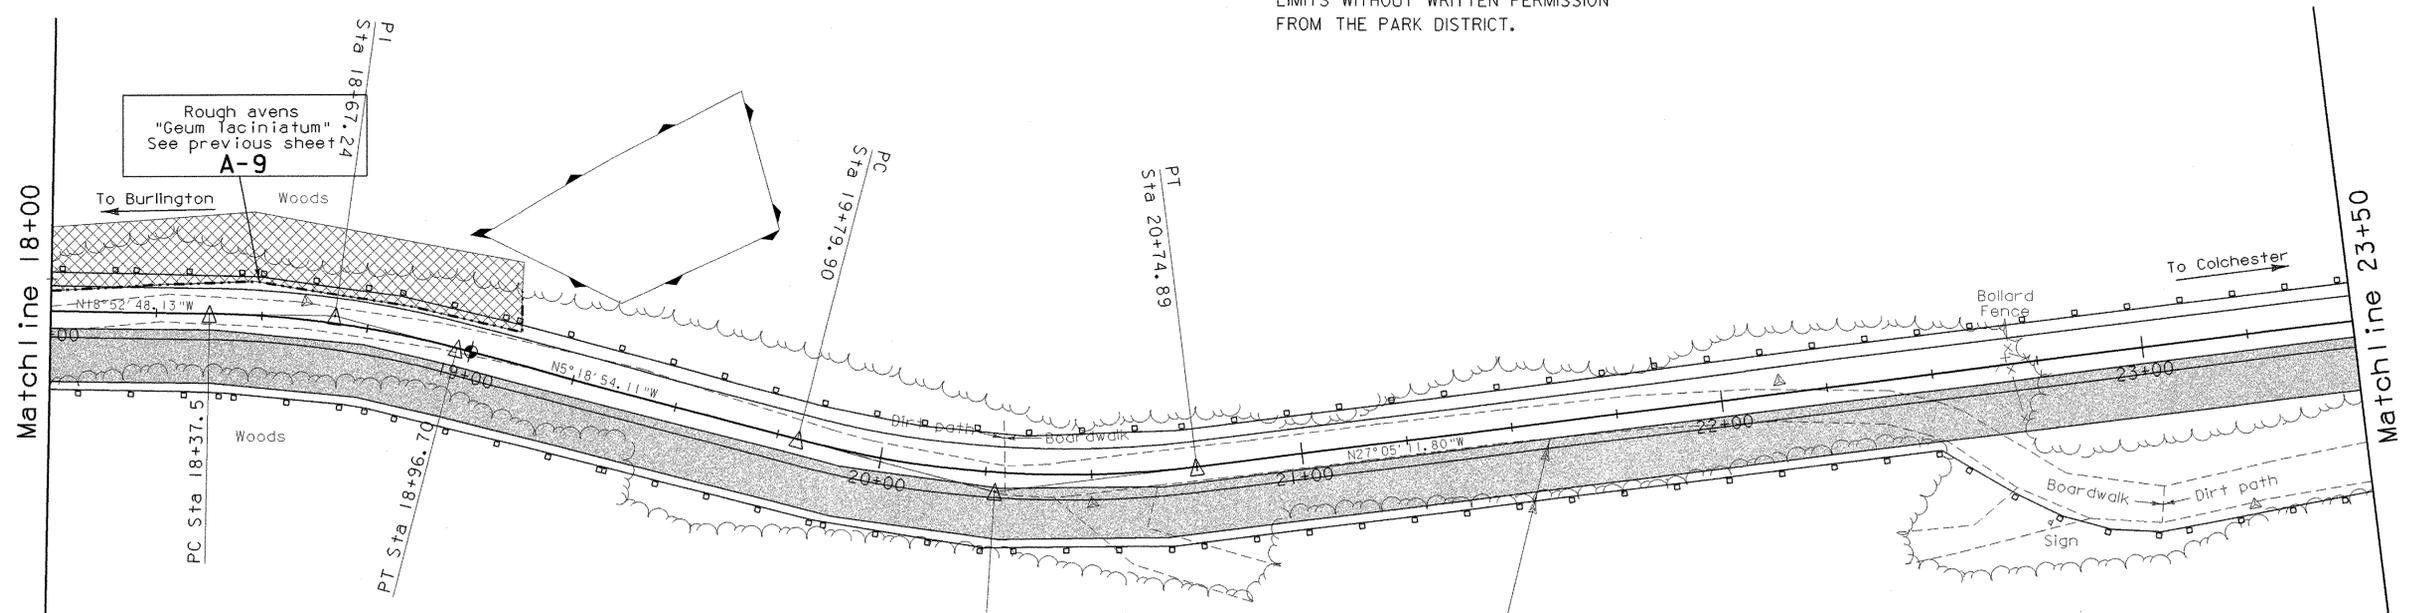



Dc 22°55'05.92"
 R 250.00'
 T 48.08'
 L 95.00'
 E 4.58'

WET LAND LIMITS
 X SILT FENCE
 SNOW FENCE
 NO CONSTRUCTION PERSONNEL OR
 EQUIPMENT ALLOWED OUTSIDE THESE
 LIMITS WITHOUT WRITTEN PERMISSION
 FROM THE PARK DISTRICT.

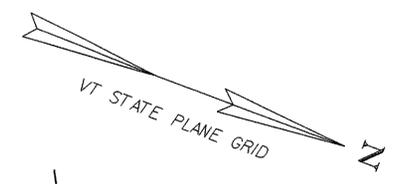

Delta 13°33'54.02"
 Dc 22°55'05.92"
 R 250.00'
 T 29.73'
 L 59.19'
 E 1.76'

PROPOSED AREA
 FOR CONSTRUCTION
 VEHICLE ACCESS

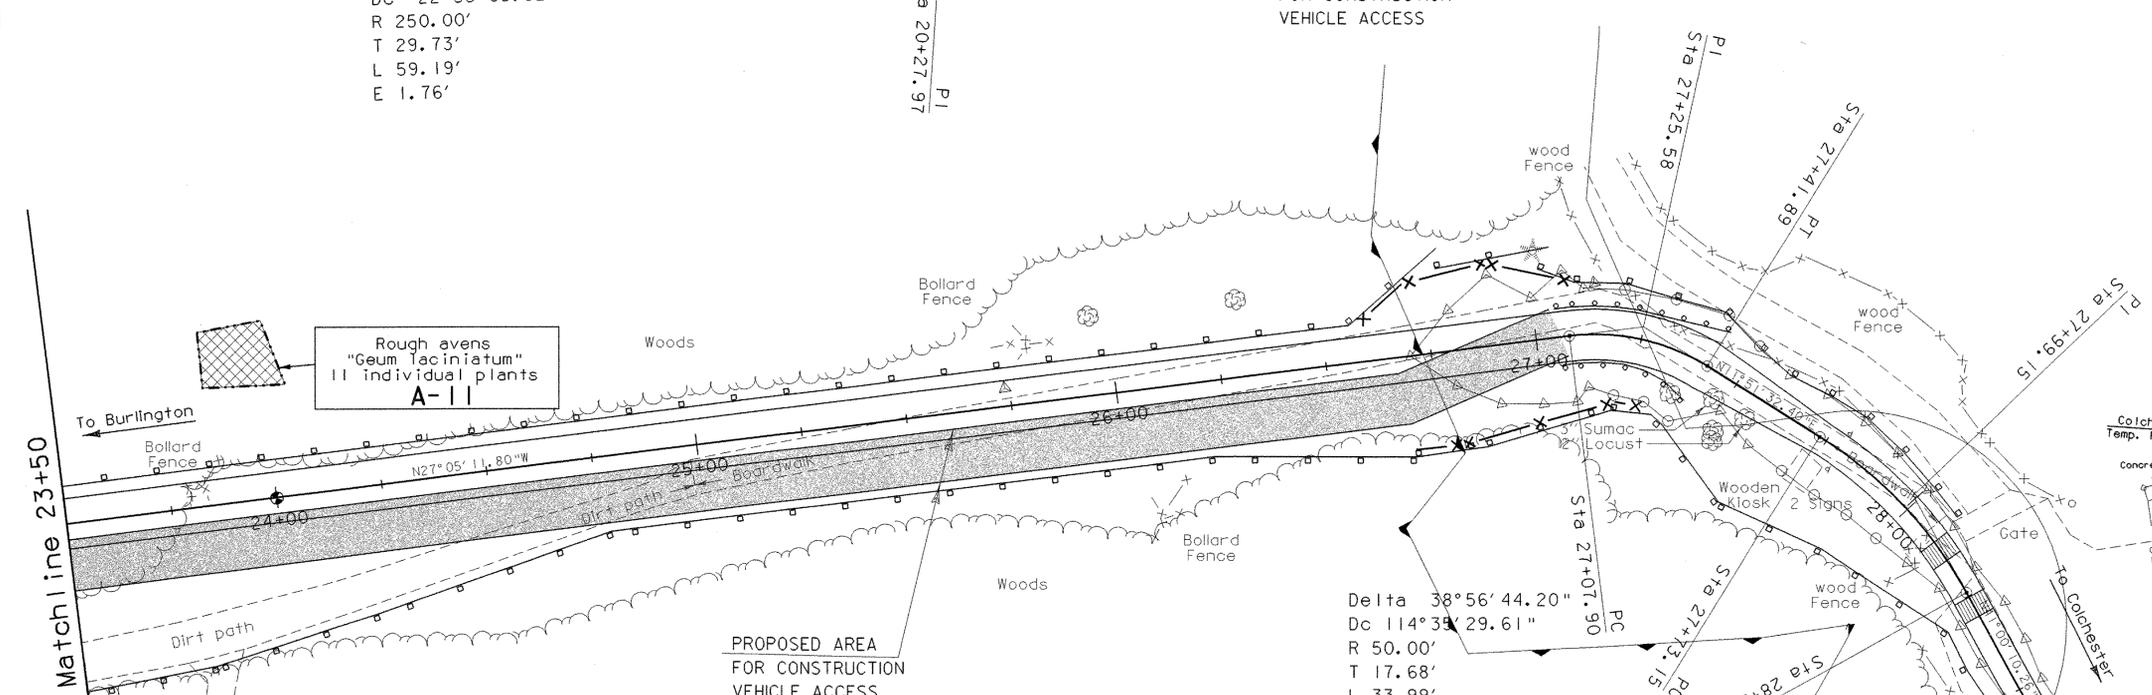

Delta 38°56'44.20"
 Dc 114°35'29.61"
 R 50.00'
 T 17.68'
 L 33.99'
 E 3.03'

Delta 29°08'37.86"
 Dc 57°17'44.81"
 R 100.00'
 T 26.00'
 L 50.87'
 E 3.32'

WET LAND LIMITS
 X SILT FENCE
 SNOW FENCE
 NO CONSTRUCTION PERSONNEL OR
 EQUIPMENT ALLOWED OUTSIDE THESE
 LIMITS WITHOUT WRITTEN PERMISSION
 FROM THE PARK DISTRICT.

Resource Layout & Erosion Control

PROJECT NAME:	Colchester	FILE NAME:	/str5/03f038/resourcebdr.dgn	PLOT DATE:	05-AUG-2003
PROJECT NUMBER:	STP Bike(48)	PROJECT LEADER:	C. Keller	DRAWN BY:	G. Shangraw
		DESIGNED BY:	M. Evans-Mongeon	CHECKED BY:	
			sf038res2.1		SHEET 28 OF 87

