


SIGN	DIMENSIONS (INCHES)													
	A	B	C	D	E	F	G	H	J	K	L	M	N	P
PATH	18	3/8	5/8	5 3/8	5 1/2	6	4 3/4	3 3/8	1 3/4	1 1/4	2	2 5/8	6 1/4	1 1/2

SEE STANDARD E-144 FOR ARROW HEAD DETAILS

SIGN	DIMENSIONS (INCHES)					
	A	B	C	D	E	F
PATH	18	3/8	5/8	5	5/8	1 1/2

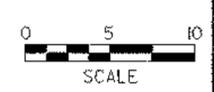

Signs & Markings

PROJECT NAME: **Colchester**

PROJECT NUMBER: **STP Bike(48)**

FILE NAME: str5/03f038/sf038signs.dgn PLOT DATE: 05-AUG-2003

PROJECT LEADER: C. Keller DRAWN BY: G. Shangraw

DESIGNED BY: G. Shangraw CHECKED BY:

sf038signs.i SHEET 33 OF 87