



PLAN

SCALE 1/4" = 1'-0"
 1 0 2 4 6

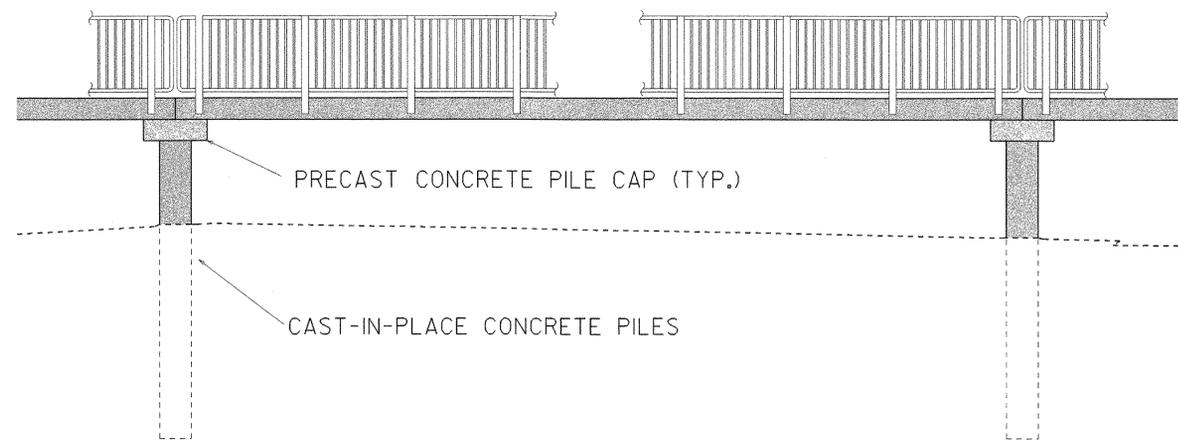

ELEVATION

SCALE 1/4" = 1'-0"
 1 0 2 4 6

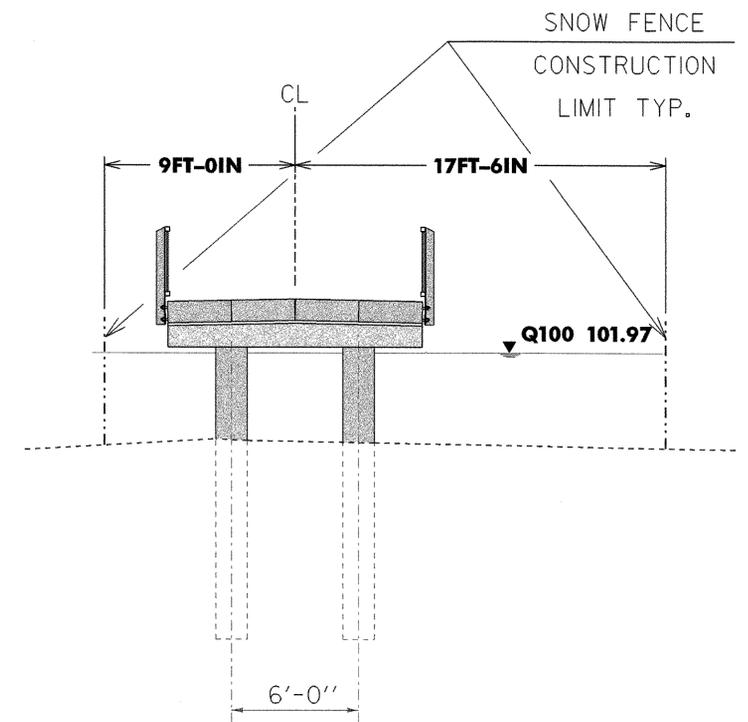

SECTION

SCALE 1/4" = 1'-0"
 1 0 2 4 6

PLAN & ELEVATION

PROJECT NAME: COLCHESTER	PLOT DATE: 05-AUG-2003
PROJECT NUMBER: STP BIKE(48)	DRAWN BY: J. GEORGE
FILE NAME: sr+5/03f038/sf038pe.dgn	DESIGNED BY: M.E.M.
PROJECT LEADER: C. KELLER	CHECKED BY: M.E.M.
DESIGNED BY: sf038pe.i	SHEET 38 OF 87