



CONNECTION DETAIL @ PILE (TYP.)
SCALE 1" = 1'-0"

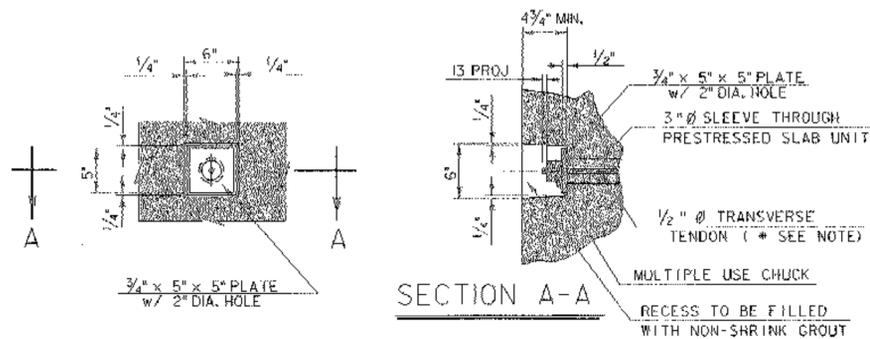

1/2" Ø TRANSVERSE TENDON DETAIL

NTS

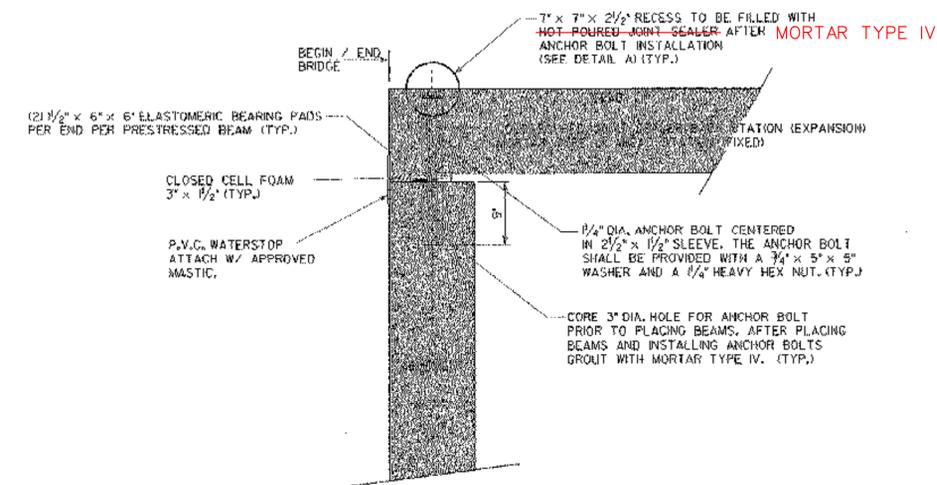


CONNECTION DETAIL @ ABUTMENT (TYP.)

SCALE 1" = 1'-0"




P.V.C. WATERSTOP

THE COSTS FOR P.V.C. WATERSTOP SHALL BE INCLUDED IN THE UNIT BID PRICE FOR CONCRETE. OTHER CONFIGURATIONS MAY BE USED UPON APPROVAL OF THE STRUCTURES ENGINEER.

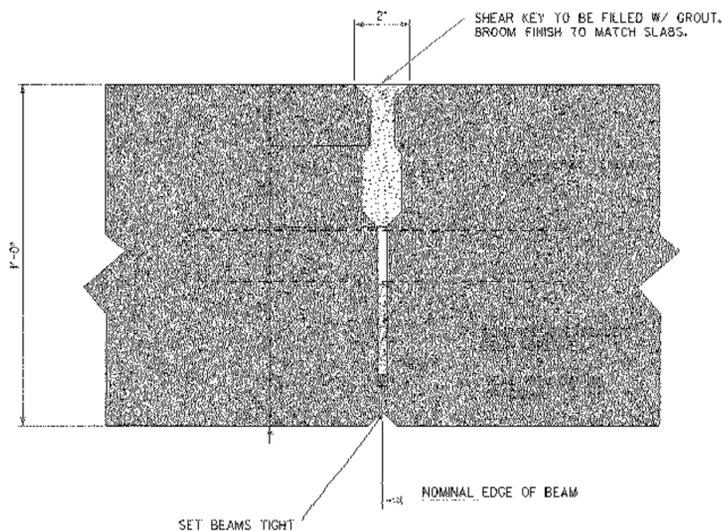


SHEAR KEY DETAIL

NTS

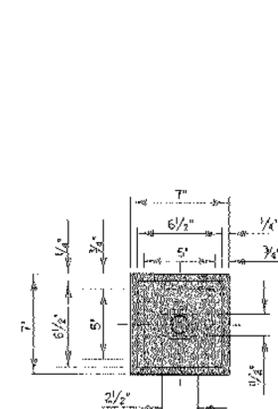


SECTION A-A

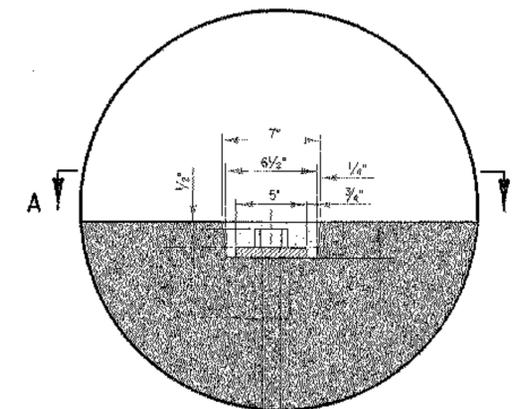

DETAIL "A"

SCALE 1/2" = 1'-0"

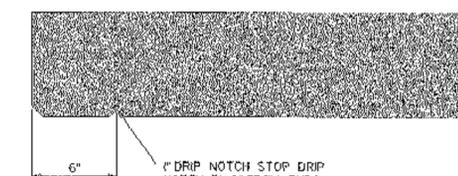

DRIP NOTCH DETAIL

SCALE 1/2" = 1'-0"



FIELD CONNECTION DETAILS

PROJECT NAME: COLCHESTER
PROJECT NUMBER: STP BIK048

FILE NAME: /str5/03f038/sf038pstdet.dgn PLOT DATE: 05-AUG-2003
PROJECT LEADER: C. KELLER DRAWN BY: J. GEORGE
DESIGNED BY: J. GEORGE CHECKED BY: M.E.M.
sf038pstdet4.l SHEET 42 OF 87