 


PRESTRESSED SLAB LAYOUT

SPAN 22

SCALE 1/2" = 1'-0"



**SLAB DETAILS
SPAN 22**

THE TOPS OF THE PRESTRESSED SLABS SHALL BE SCREEDED AND GIVEN A BROOMED OR WIRE BROOM FINISH.
THE GROOVES SHALL BE IN THE TRANSVERSE DIRECTION AND PENETRATE THE SURFACE APPROXIMATELY 1/4"

PROJECT NAME: COLCHESTER
PROJECT NUMBER: STP Bike(48)

FILE NAME: /str5/03f038/sf038pstdet.dgn PLOT DATE: 05-AUG-2003
PROJECT LEADER: C. KELLER DRAWN BY: J. GEORGE
DESIGNED BY: J. GEORGE CHECKED BY: M.E.M.
sf038pstdet12.i SHEET 50 OF 87