
 
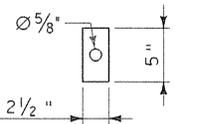


BOLTING DETAIL "A"

SCALE 3" = 1'-0"


 


GALV. STEEL PLATE WASHER

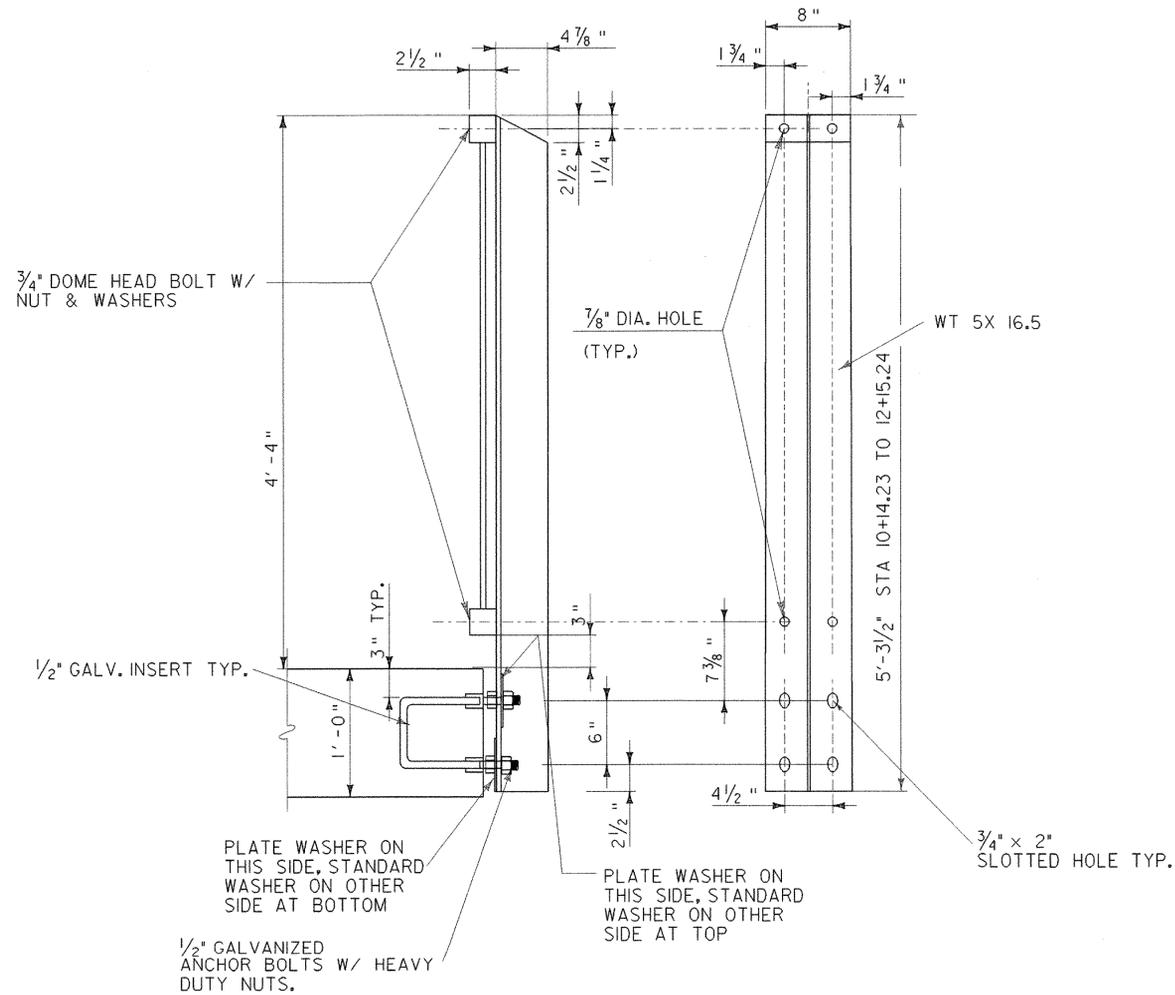


SECTION FASCIA MOUNTED 52" RAIL

SCALE 1 1/2" = 1'-0"

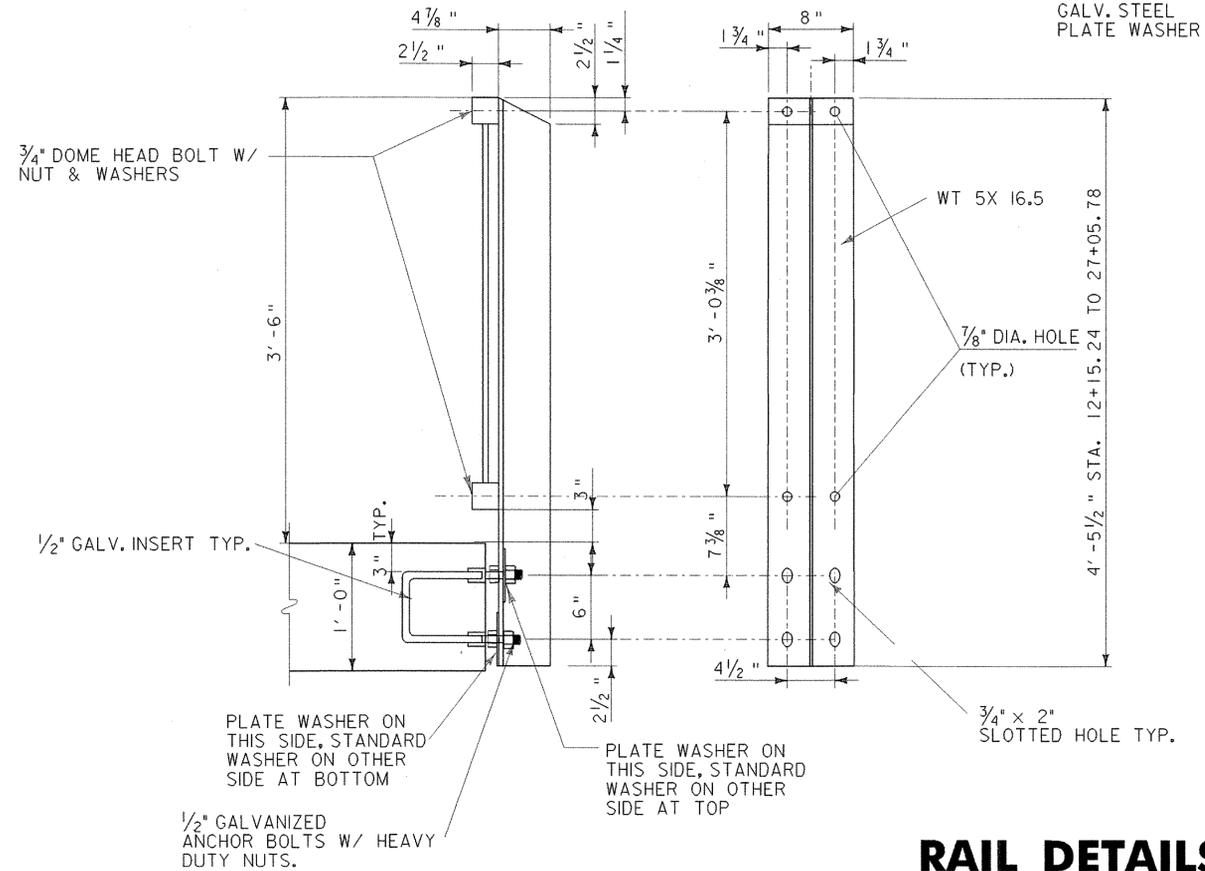

SECTION FASCIA MOUNTED 42" RAIL

 SCALE 1 1/2" = 1'-0"



**RAIL DETAILS
ALTERNATE 1**

PROJECT NAME: COLCHESTER	PLOT DATE: 05-AUG-2003
PROJECT NUMBER: STP BIKE(48)	DRAWN BY: J. GEORGE
FILE NAME: /str5/03f038/sf038bdr.dgn	CHECKED BY: M.E.M.
PROJECT LEADER: C. KELLER	SHEET 54 OF 87
DESIGNED BY: J. GEORGE	
sf038r012.i	