


SIDE ELEVATION

BACK ELEVATION


SECTION
DRIVEN POST MOUNTED FENCE

SCALE 1 1/2" = 1'-0"
1 9 6 3 0

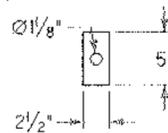

GALV. STEEL PLATE WASHER
FOR 1/8" x 2"
SLOTTED HOLE TYP.

NOT DONE

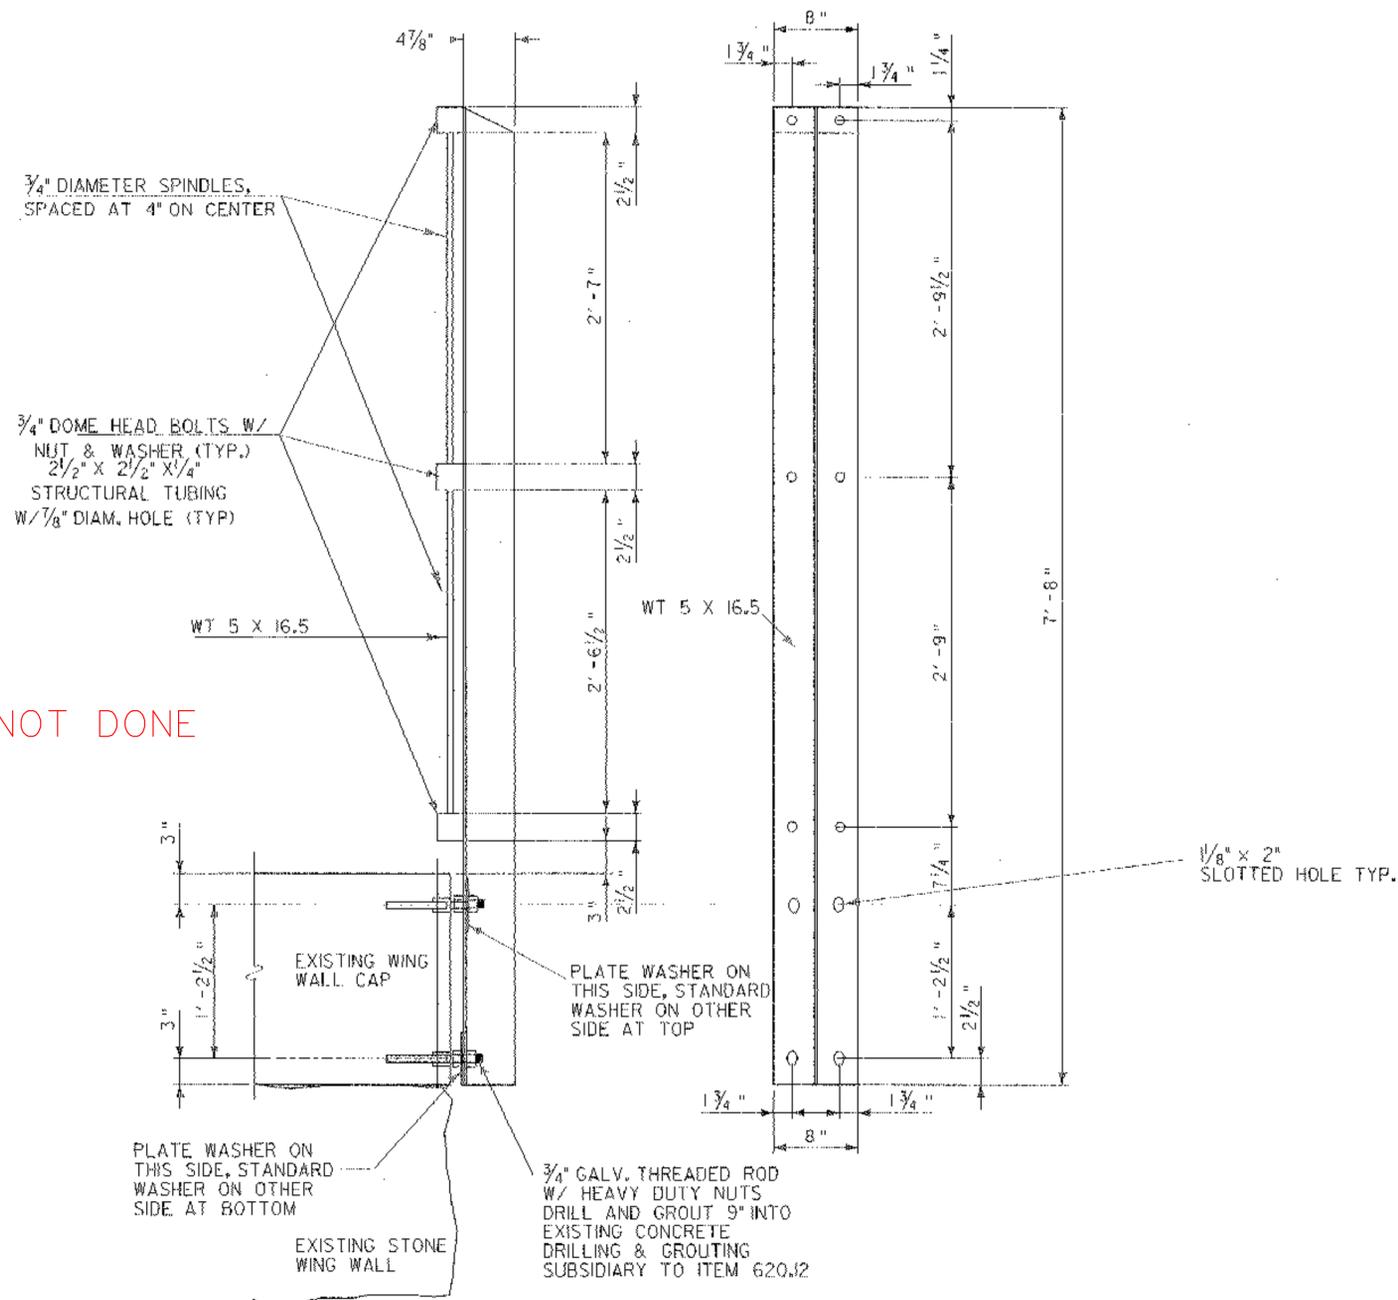

SECTION
FASCIA MOUNTED FENCE

SCALE 1 1/2" = 1'-0"
1 9 6 3 0

FENCE DETAILS
ALTERNATE 1

PROJECT NAME: COLCHESTER	PLOT DATE: 05-AUG-2003
PROJECT NUMBER: STP BIKE(48)	DRAWN BY: J. GEORGE
FILE NAME: /str5/03f038/sf038bdr.dgn	CHECKED BY: M.E.M.
PROJECT LEADER: C. KELLER	SHEET 56 OF 87
DESIGNED BY: J. GEORGE	
sf038r0114.1	