


END BRIDGE #3
STA 8+76

1" MIN. 3" MAX

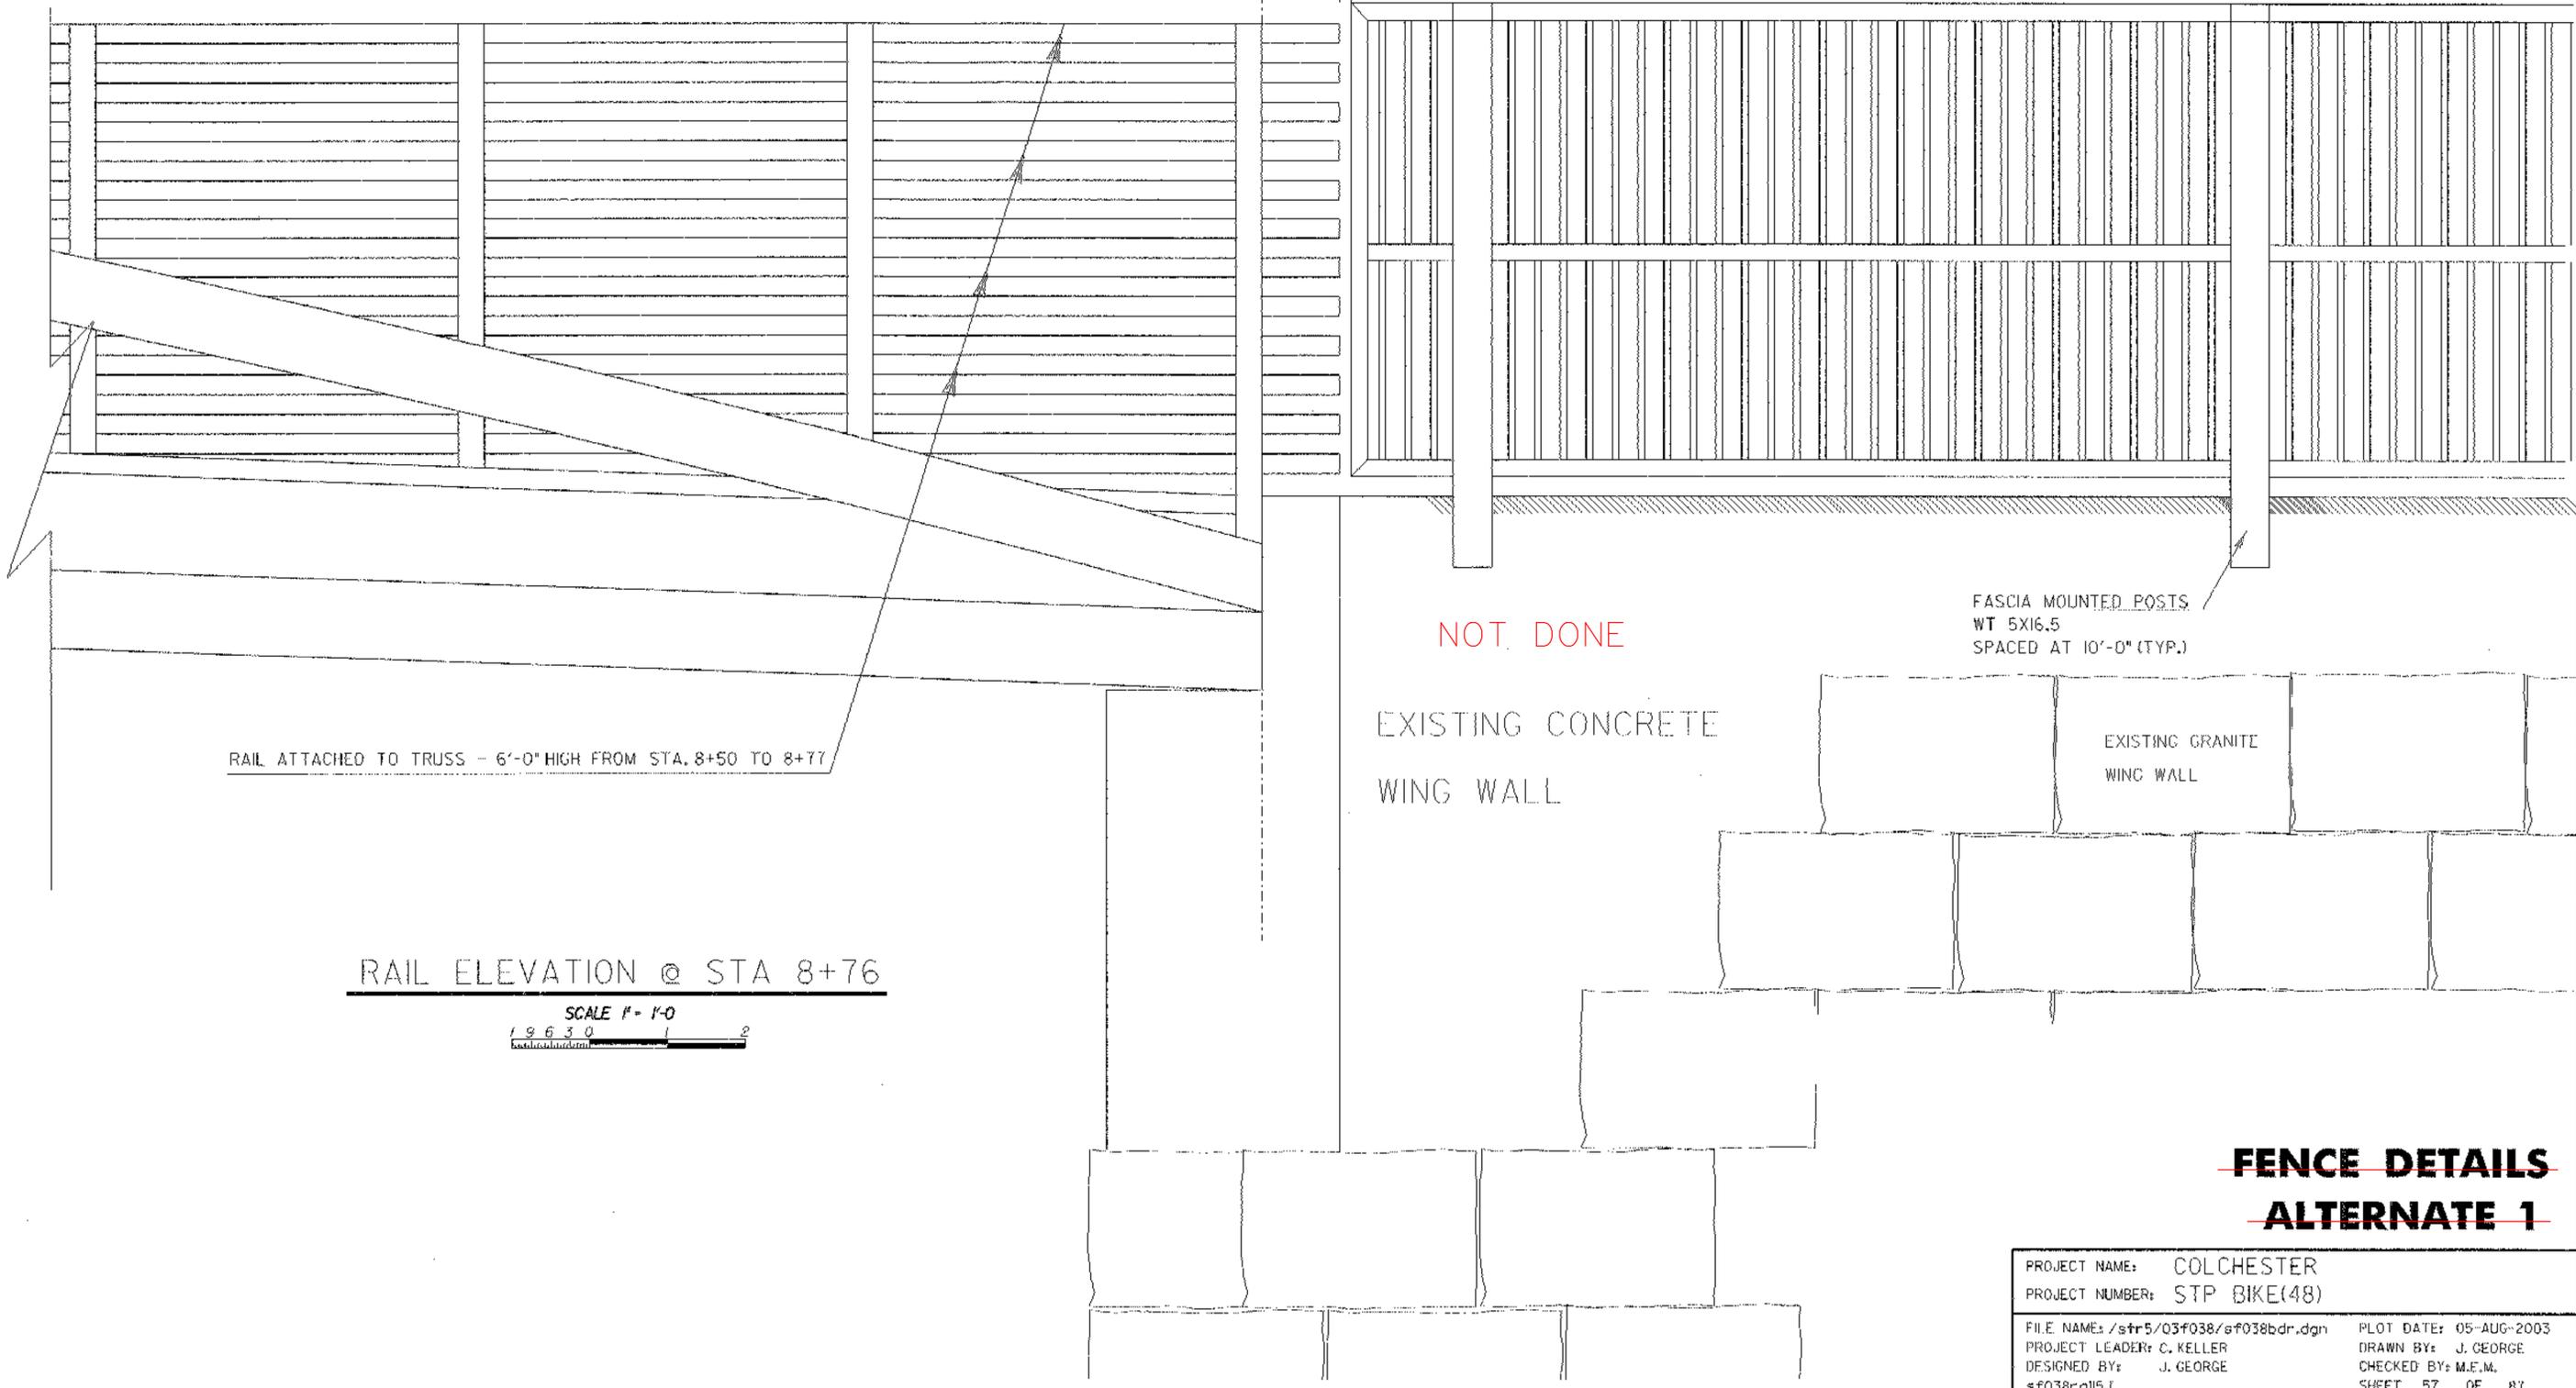

RAIL ATTACHED TO TRUSS - 6'-0" HIGH FROM STA. 8+50 TO 8+77

NOT DONE

EXISTING CONCRETE
WING WALL

FASCIA MOUNTED POSTS
WT 5X16.5
SPACED AT 10'-0" (TYP.)

EXISTING GRANITE
WING WALL

RAIL ELEVATION @ STA 8+76

SCALE 1" = 1'-0"
1 9 6 3 0 1 2

~~FENCE DETAILS~~
~~ALTERNATE 1~~

PROJECT NAME: COLCHESTER
PROJECT NUMBER: STP BIKE(48)

FILE NAME: /str5/03f038/sf038bdr.dgn
PROJECT LEADER: C. KELLER
DESIGNED BY: J. GEORGE
sf038r015.r

PLOT DATE: 05-AUG-2003
DRAWN BY: J. GEORGE
CHECKED BY: M.E.M.
SHEET 57 OF 87