



PATH ABUTMENT #1
PLAN

SCALE 1/2" = 1'-0"
1 0 1 2

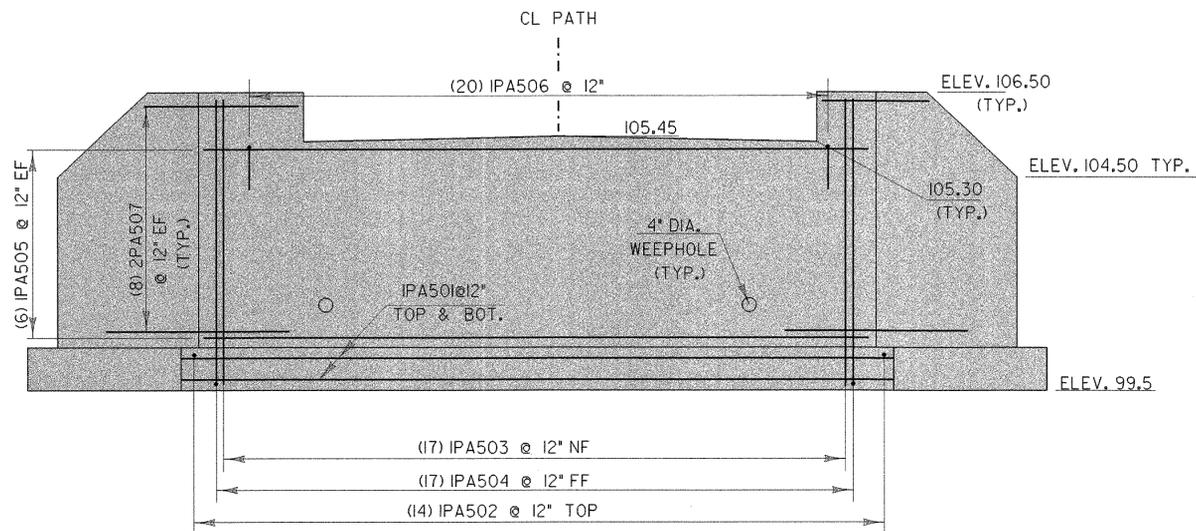


PATH ABUTMENT #1
ELEVATION

SCALE 1/2" = 1'-0"
1 0 1 2

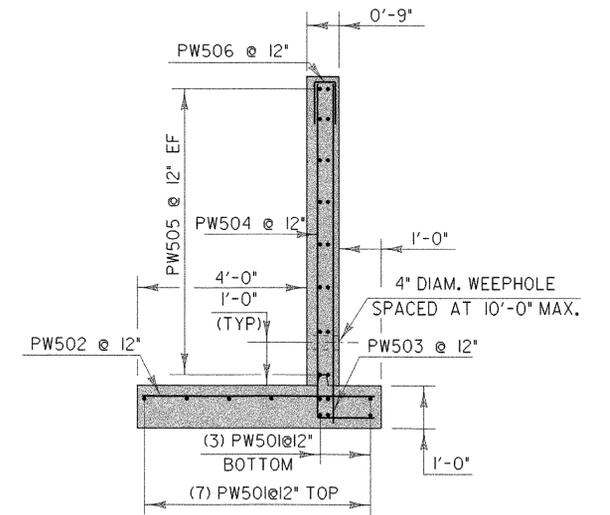

PATH WINGWALL TYPICAL

SCALE 1/2" = 1'-0"
1 0 1 2

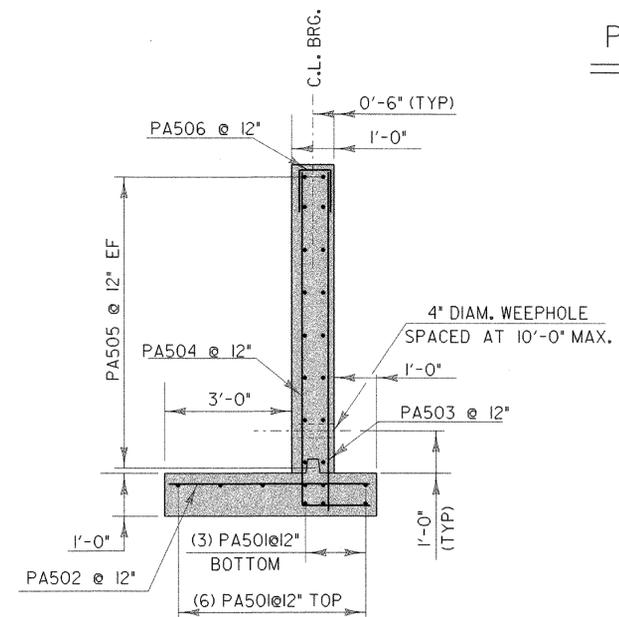

PATH ABUTMENT TYPICAL

SCALE 1/2" = 1'-0"
1 0 1 2

NOTE:

- NF = NEAR FACE
- FF = FAR FACE
- EF = EACH FACE
- ▲ = CUT TO FIT IN FIELD
- 3" CLR. UNLESS OTHERWISE SPECIFIED ON THE PLANS.

**STATE OF VERMONT
AGENCY OF TRANSPORTATION**

Town Of	COLCHESTER	Bridge No.	sf038pa2J
Highway No.	BIKE PATH	Log Sta.	
		Surv. Sta.	
PATH ABUTMENT #1 (STA 10+14)			
LAYOUT AND REINFORCING			
Designed By	M. EVANS-MONGEON	Drawn By	M. EVANS-MONGEON
Checked By	Date	Bridge Design Supervisor	Date
		C.S. KELLER	
PROJECT	COLCHESTER	PROJECT NO.	STP BIKE(48)
I.G.:\w\acadd\11\ngcabl\net\03f038\Structures\sf038bdr.dgn		sf038pa1J	
Bridge Sheet No.		Sheet	66 of 87