



PATH ABUTMENT #2
PLAN

SCALE 1/2" = 1'-0"
1 0 1 2

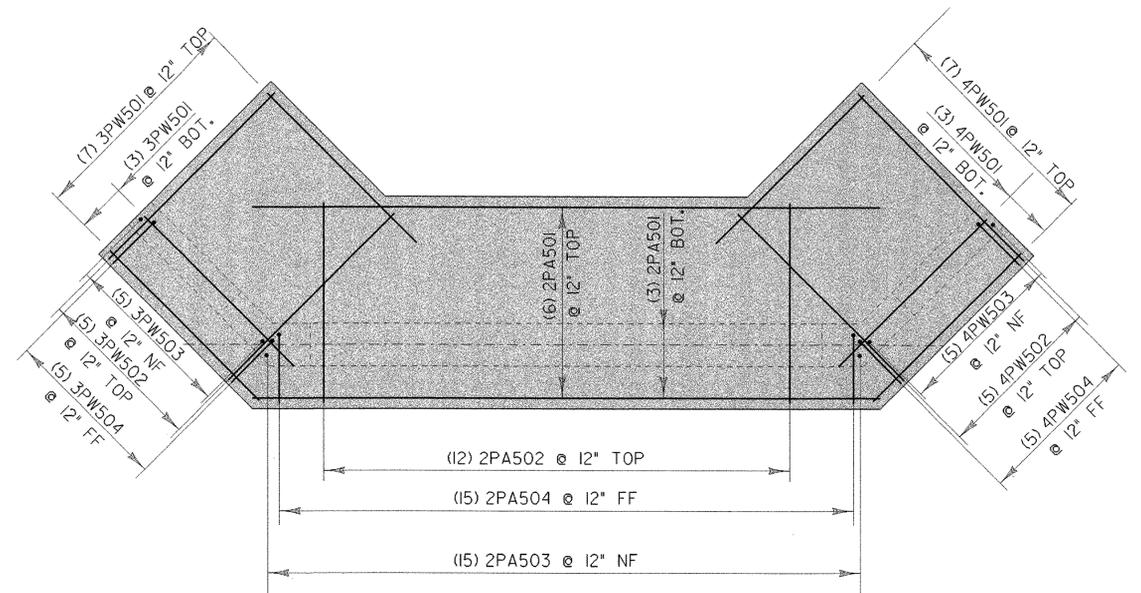

PATH ABUTMENT #2
FOOTING REINFORCING

SCALE 1/2" = 1'-0"
1 0 1 2

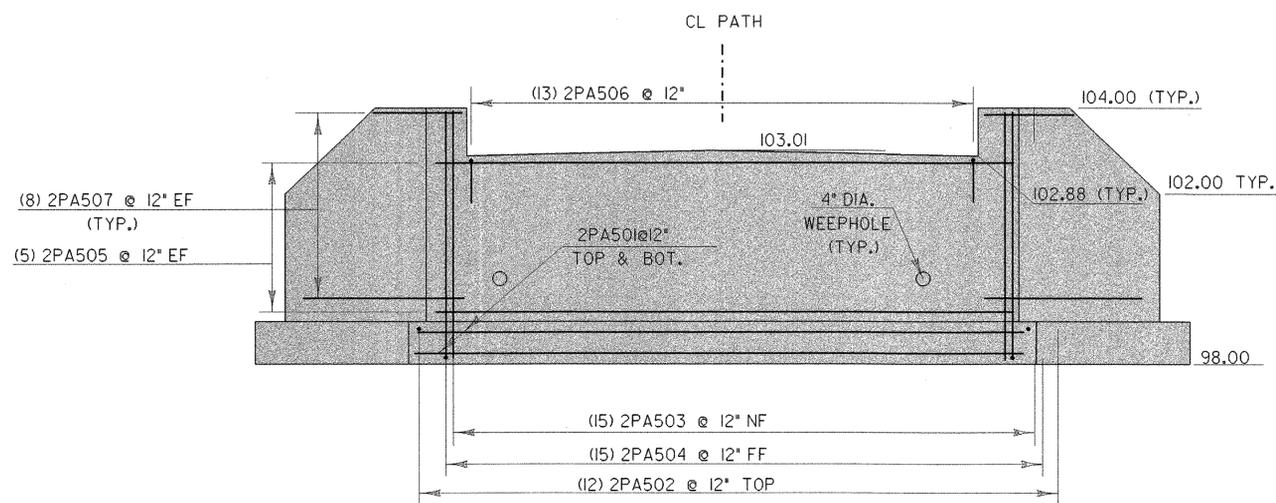

PATH ABUTMENT #2
ELEVATION

SCALE 1/2" = 1'-0"
1 0 1 2

NOTE:
NF - NEAR FACE
FF - FAR FACE
EF - EACH FACE
▲ - CUT TO FIT IN FIELD
3" CLR. UNLESS OTHERWISE
SPECIFIED ON THE PLANS.

STATE OF VERMONT
AGENCY OF TRANSPORTATION

Town Of	COLCHESTER	Bridge No.	sf132pa21
Highway No.	BIKE PATH	Log Sta.	
		Surv. Sta.	
PATH ABUTMENT #2 (STA 27+05)			
LAYOUT AND REINFORCING			
Designed By	M.EVANS-MONGEON	Drawn By	M.EVANS-MONGEON
Checked By	Date	Bridge Design Supervisor	Date
		C.S.KELLER	
PROJECT	COLCHESTER	PROJECT NO.	STP BIKE(48)
I.G.C:\road\ocadd\11\ingcablnet\1031038\Structures\sf038bdr.dgn		sf132pa21	
Bridge Sheet No.		Sheet	67 of 87