




9+50 9+50  
End 22' Wide Path  
Begin Taper 22' to 12' wide

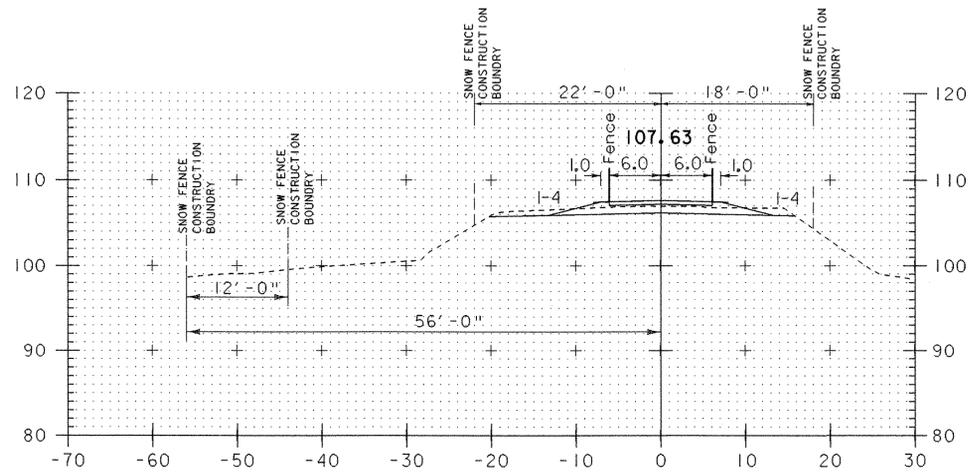


9+80

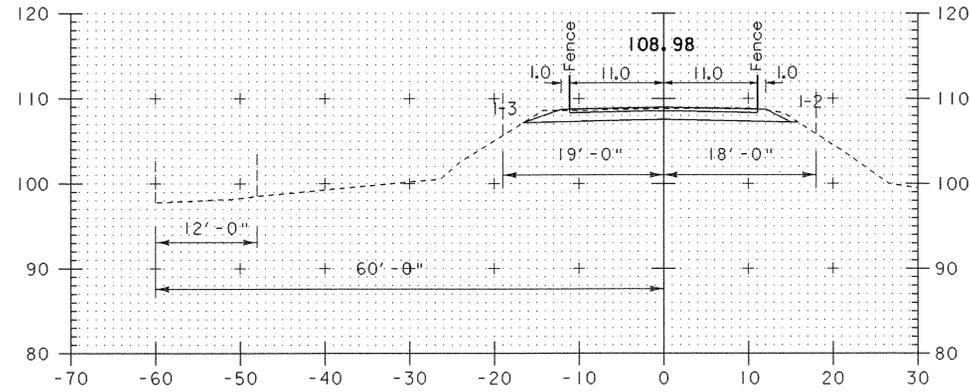


9+40

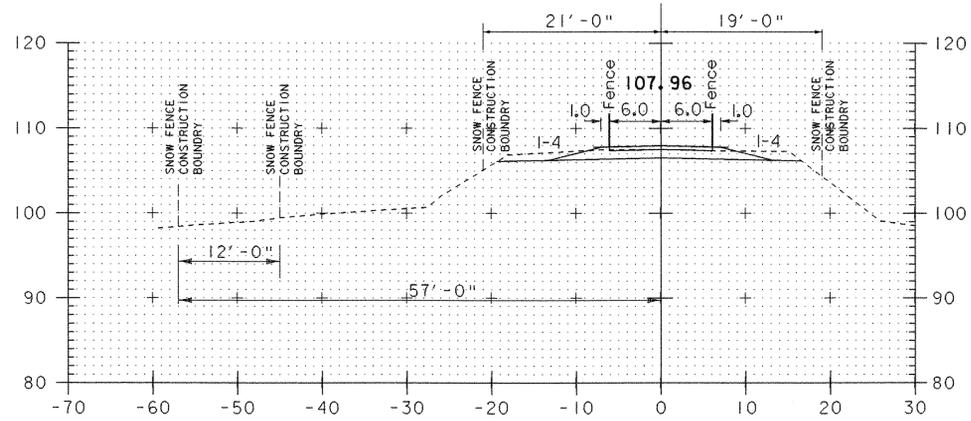

9+70

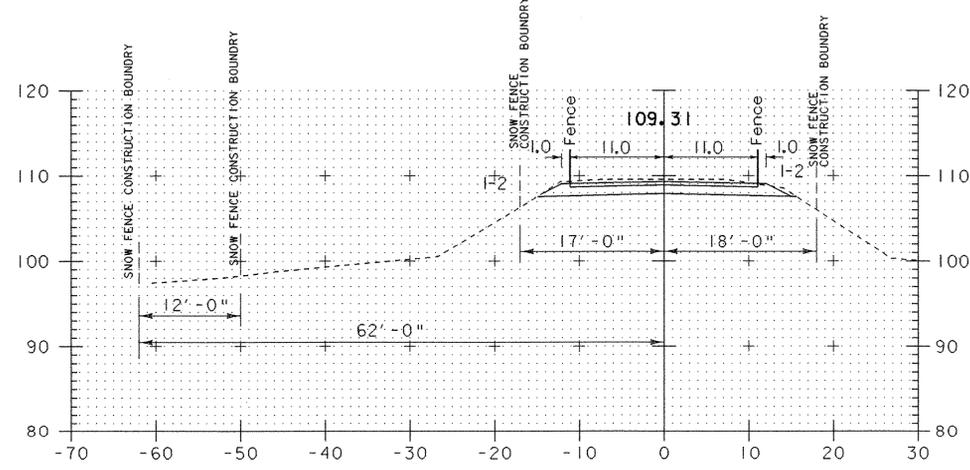

9+30

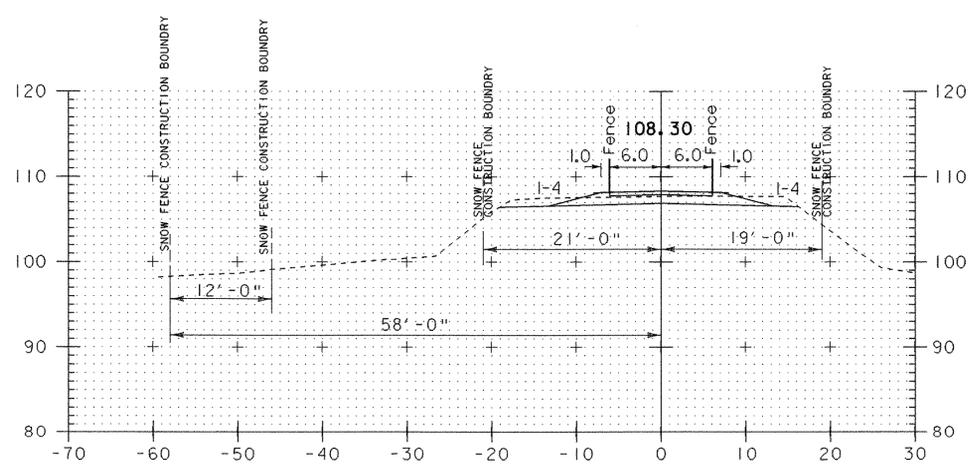

9+60 9+60  
End Width Taper  
Resume 12' Wide Path

**CROSS SECTIONS  
9+30 - 9+80**

|                 |                          |
|-----------------|--------------------------|
| PROJECT NAME:   | Colchester               |
| PROJECT NUMBER: | STP Bike(48)             |
| FILE NAME:      | str5/03f038/sf038xsl.dgn |
| PROJECT LEADER: | C. Keller                |
| DESIGNED BY:    | G. Shangraw              |
| PLLOT DATE:     | 05-AUG-2003              |
| DRAWN BY:       | G. Shangraw              |
| CHECKED BY:     |                          |
| SHEET           | 72 OF 87                 |