




10+10

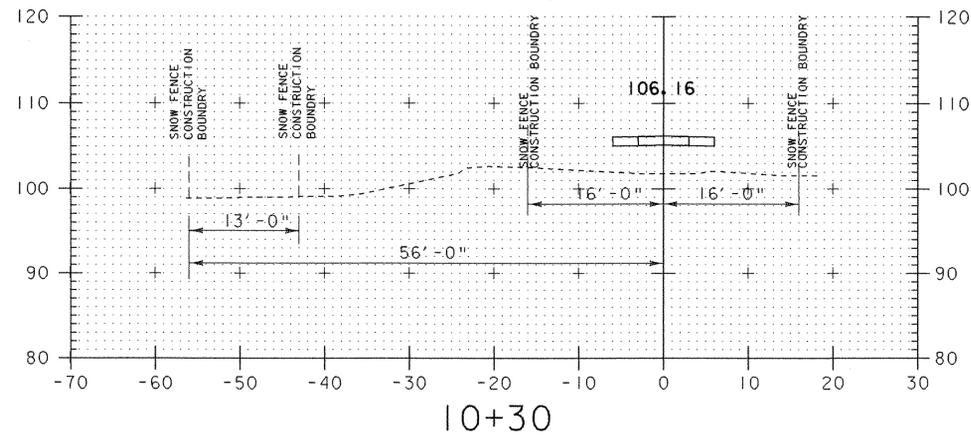


10+30

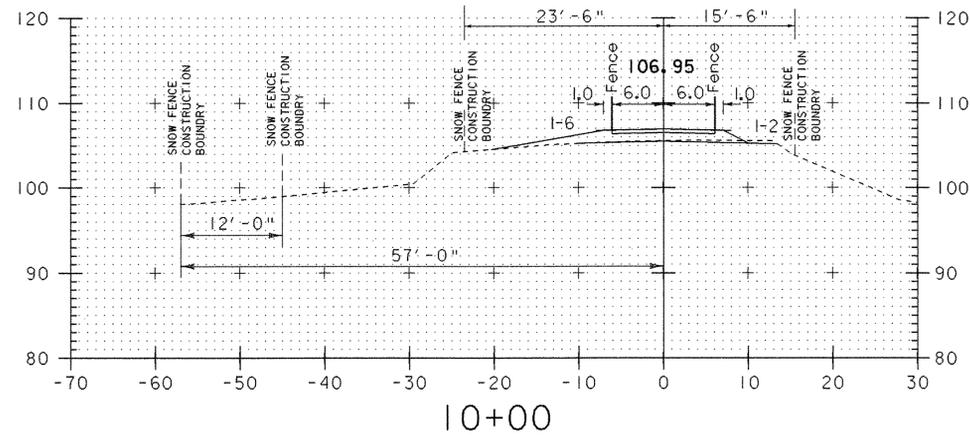


10+00

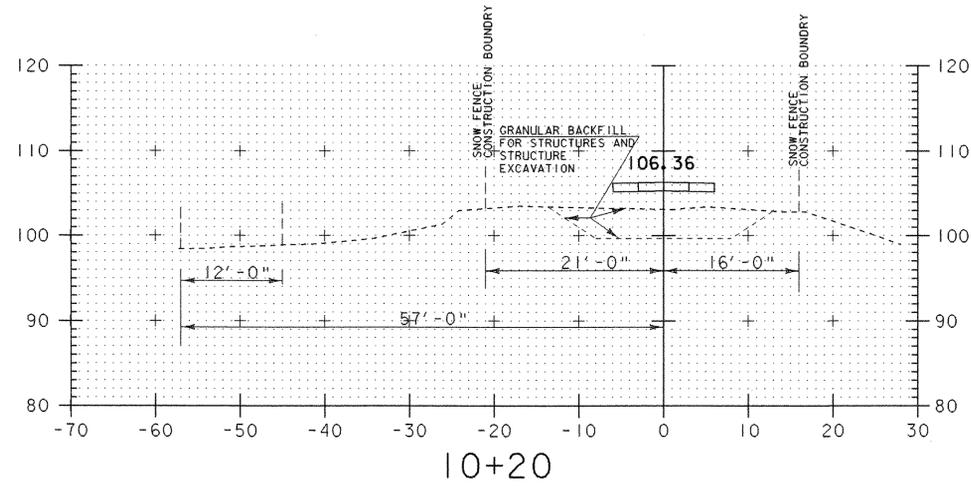

10+20

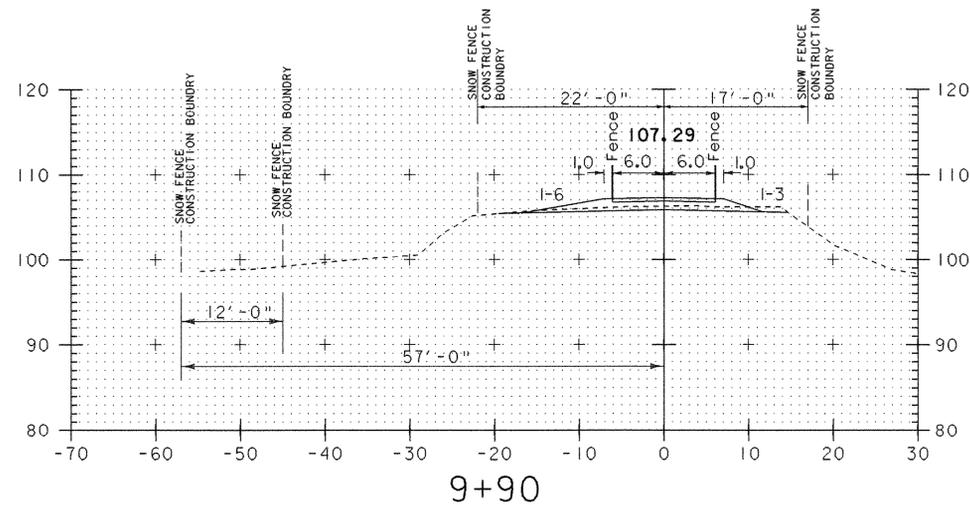

9+90

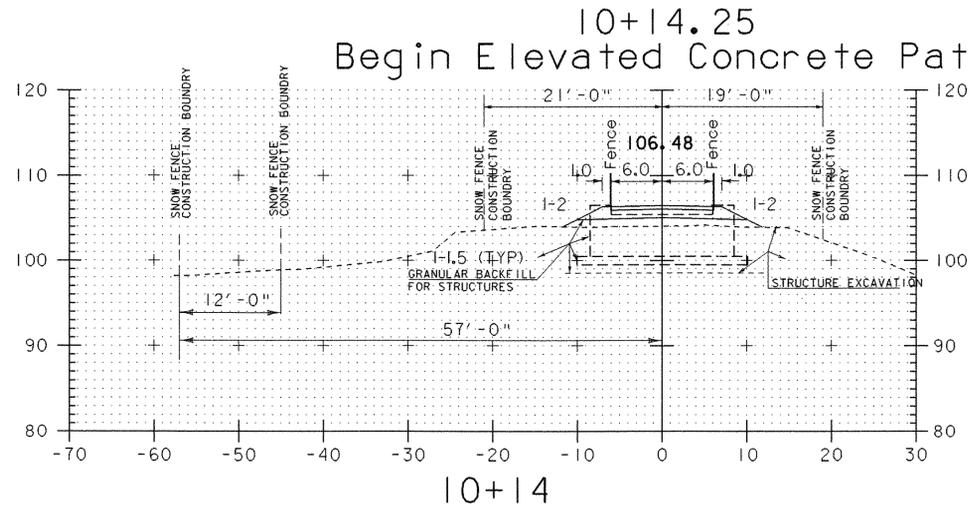

10+14

10+14.25
Begin Elevated Concrete Path

CROSS SECTIONS 9+90 - 10+30

PROJECT NAME:	Colchester
PROJECT NUMBER:	STP Bike(48)
FILE NAME: str5\03f038\sf038xsl.dgn	PLOT DATE: 05-AUG-2003
PROJECT LEADER: C. Keller	DRAWN BY: G. Shangraw
DESIGNED BY: G. Shangraw	CHECKED BY:
sf038xs4.i	SHEET 73 OF 87