
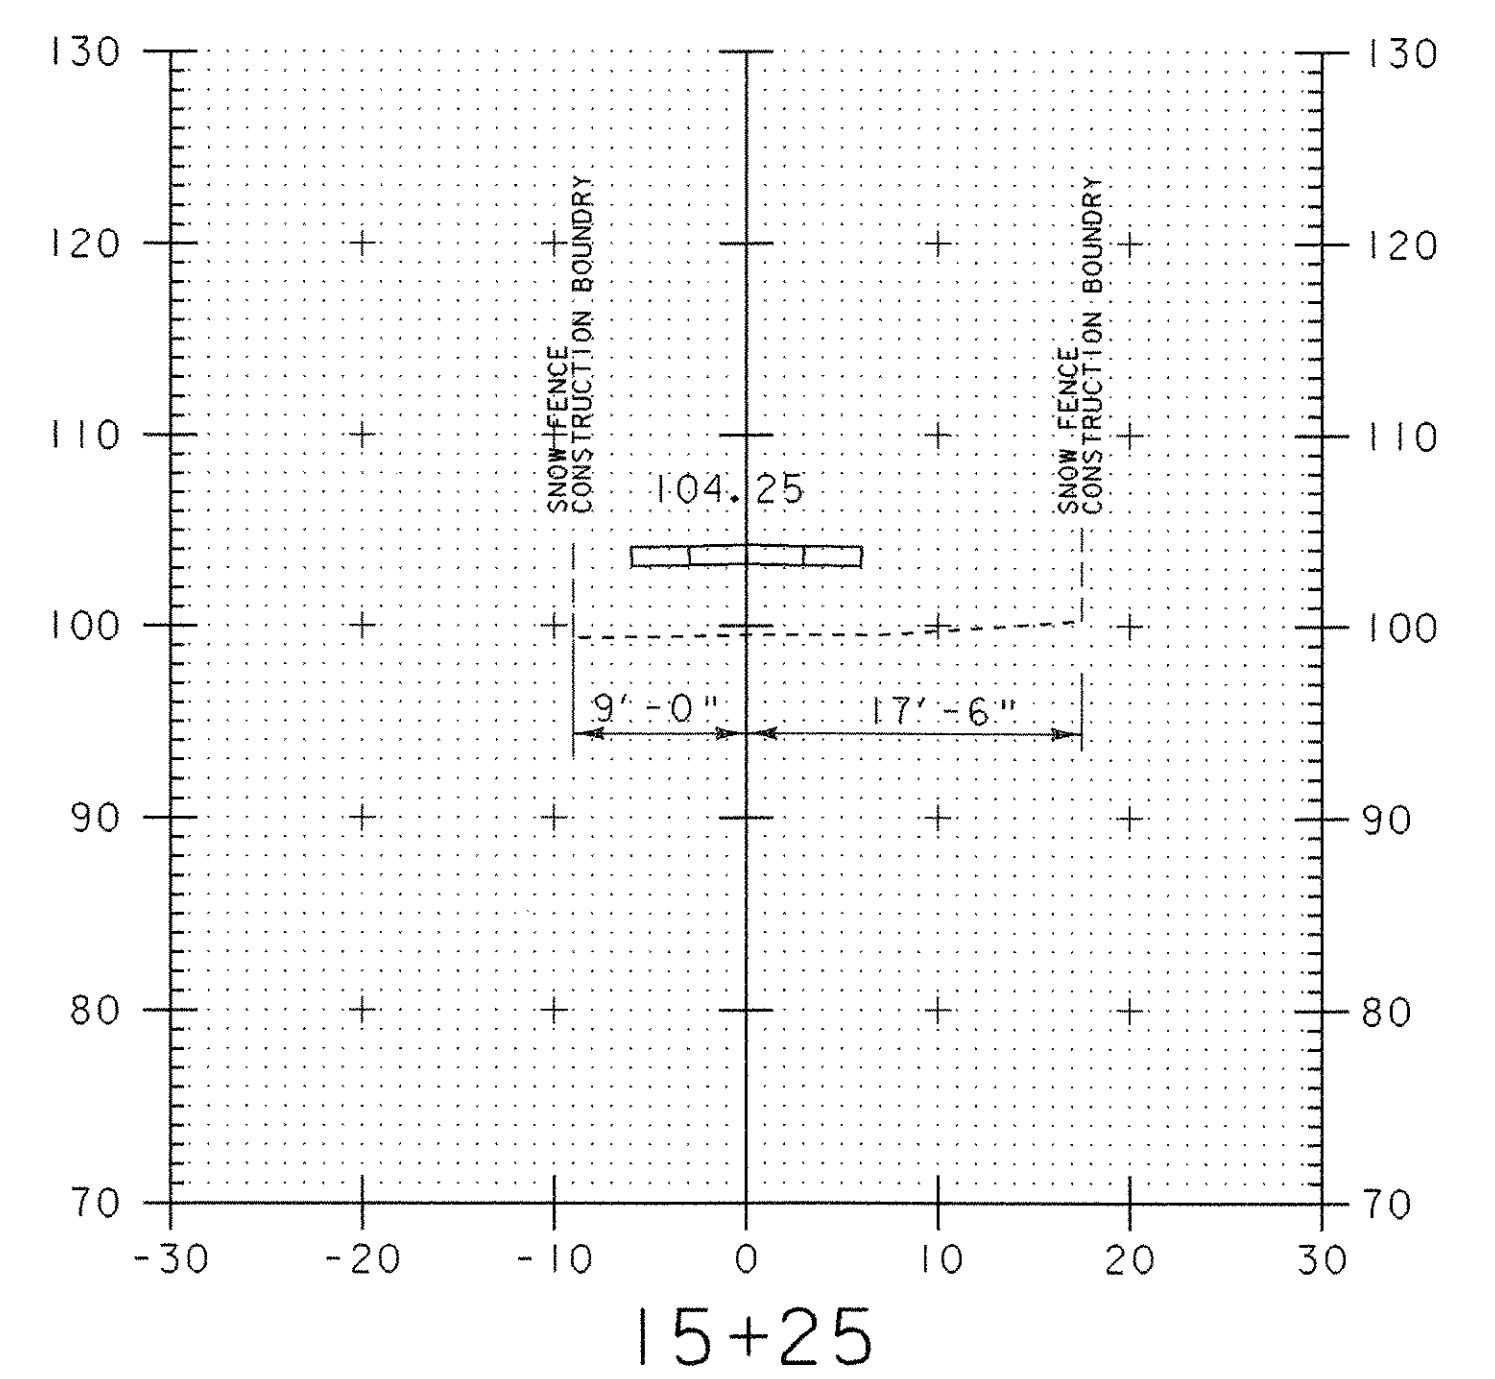
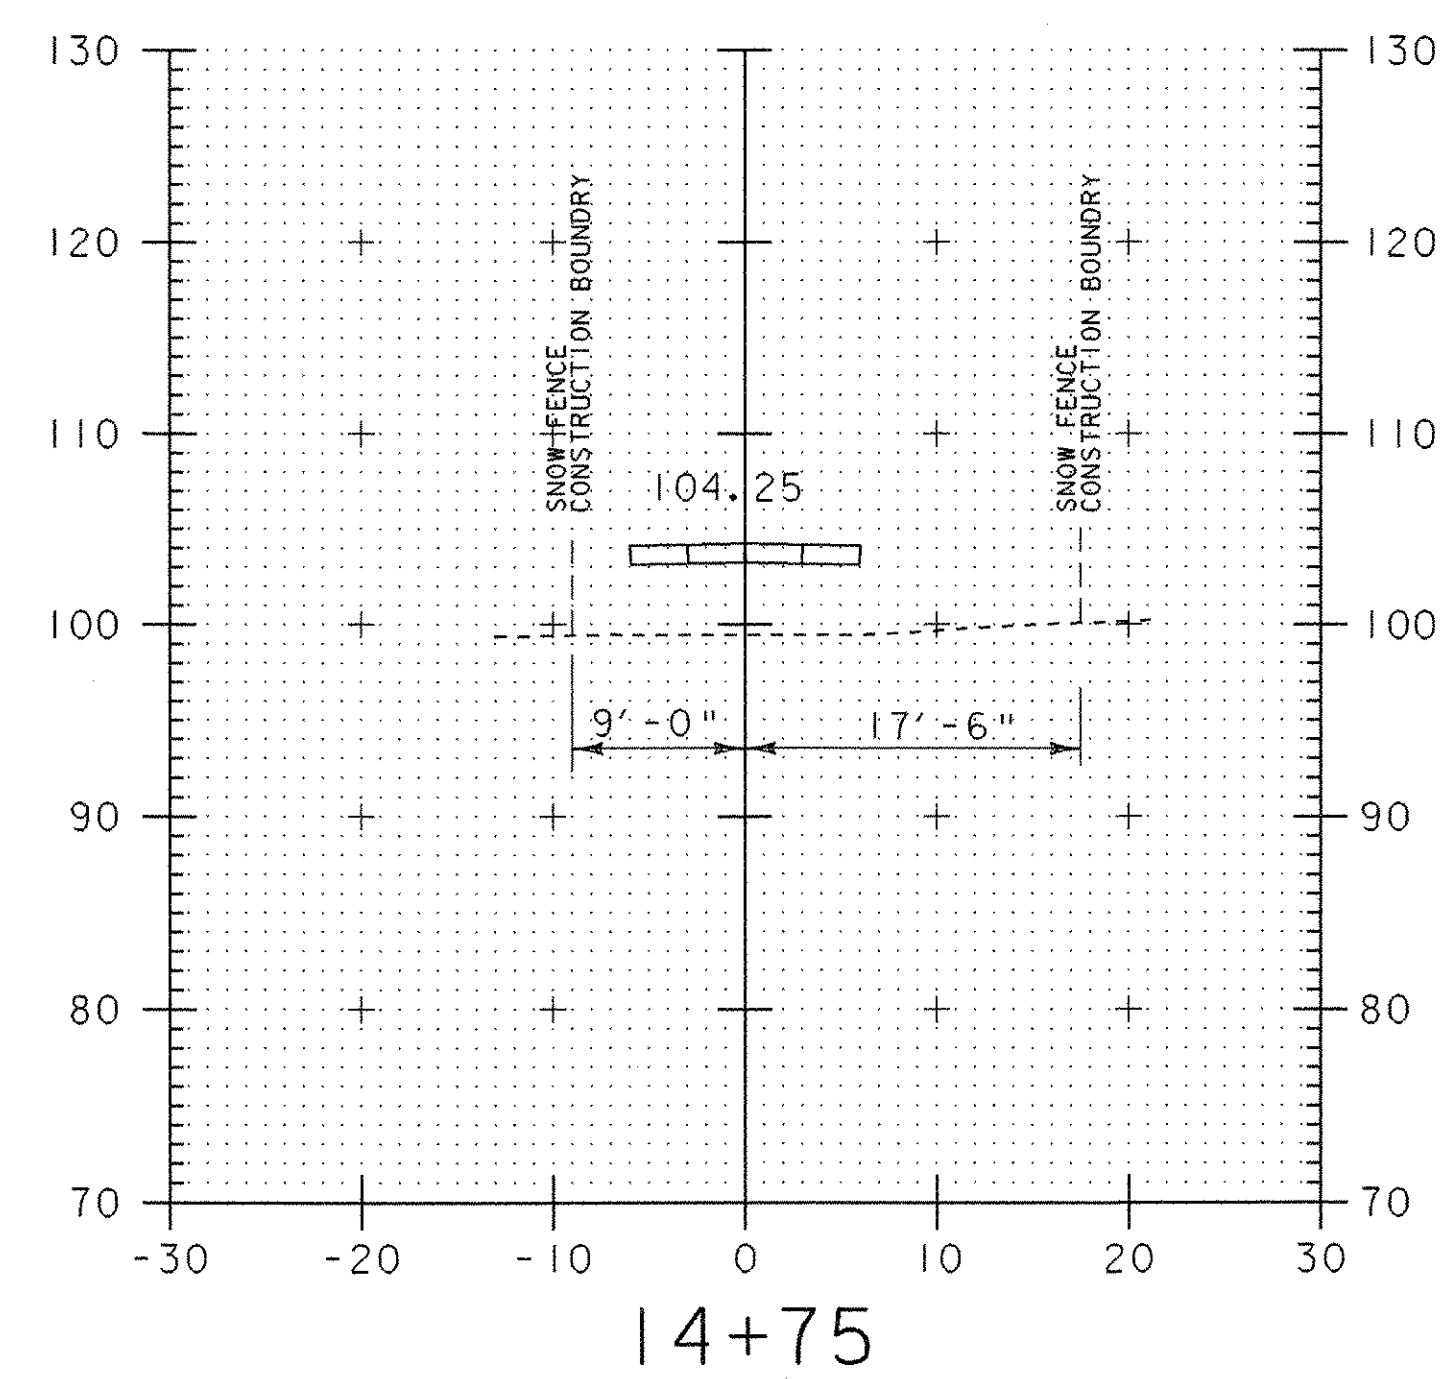
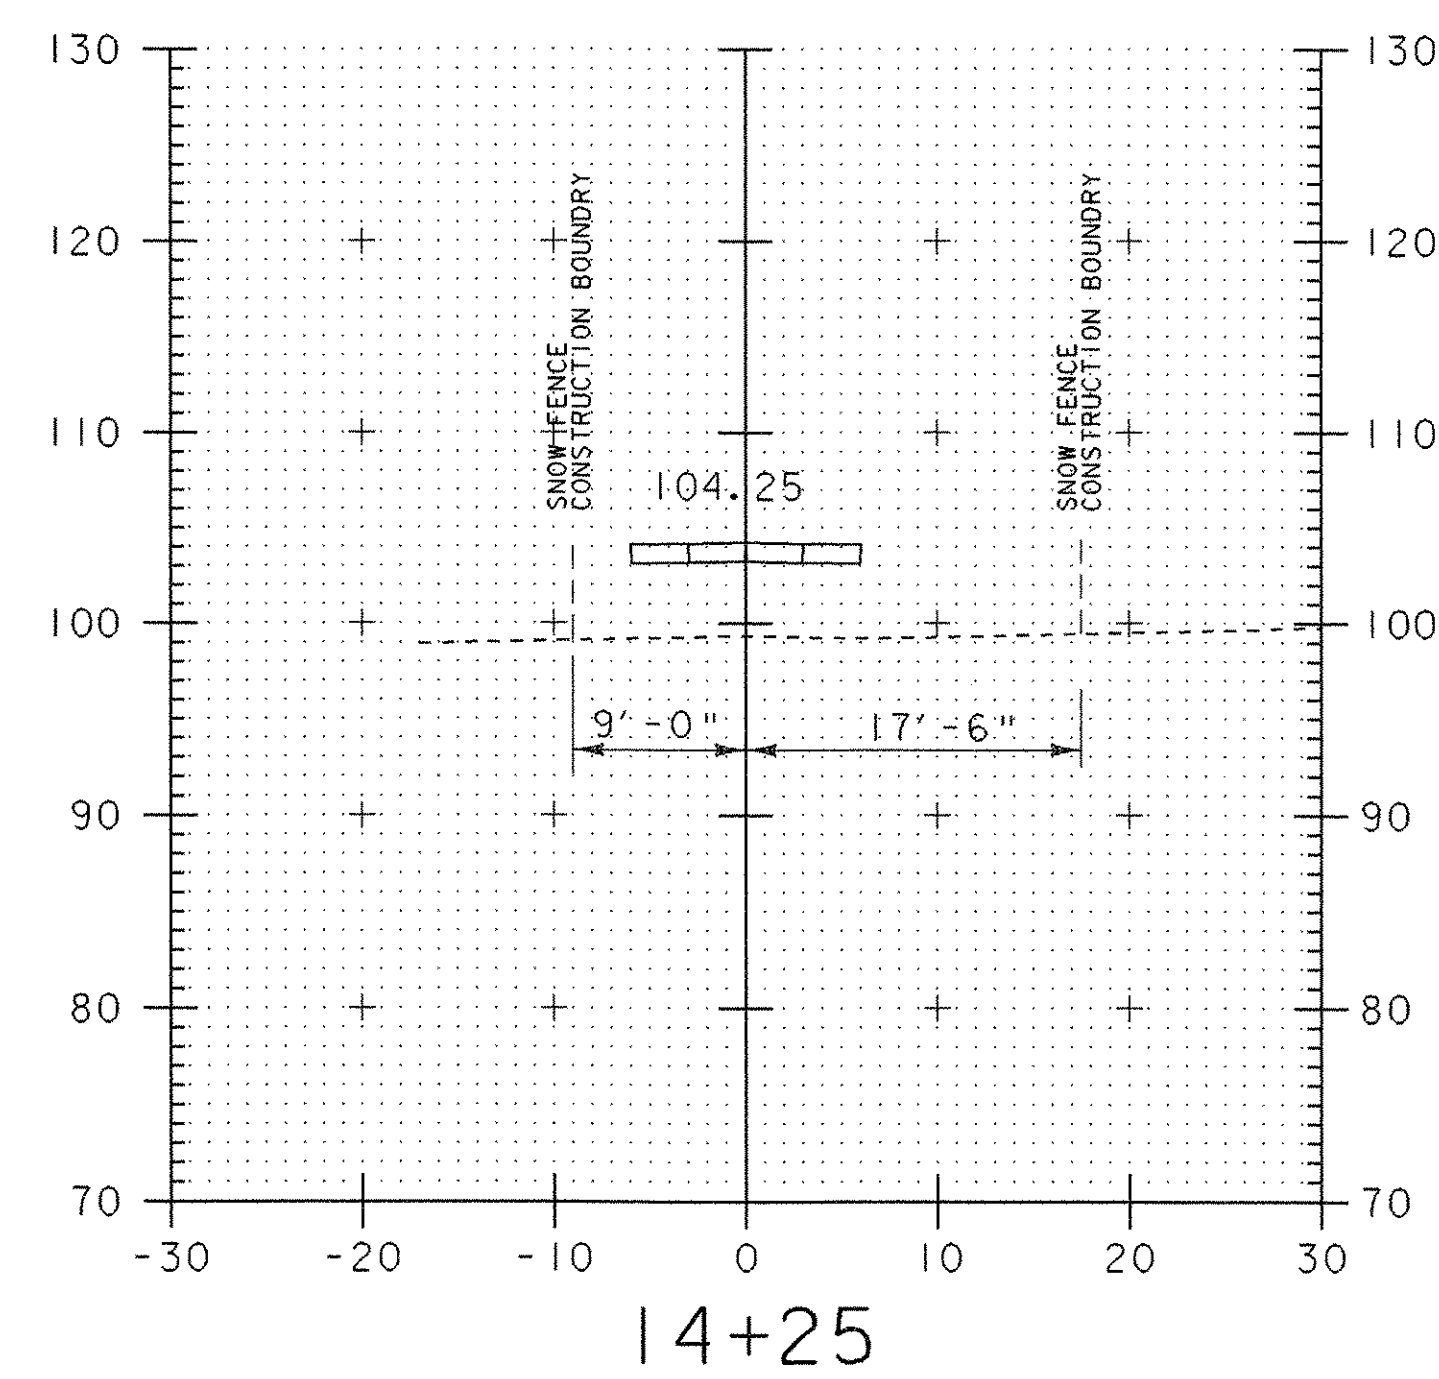
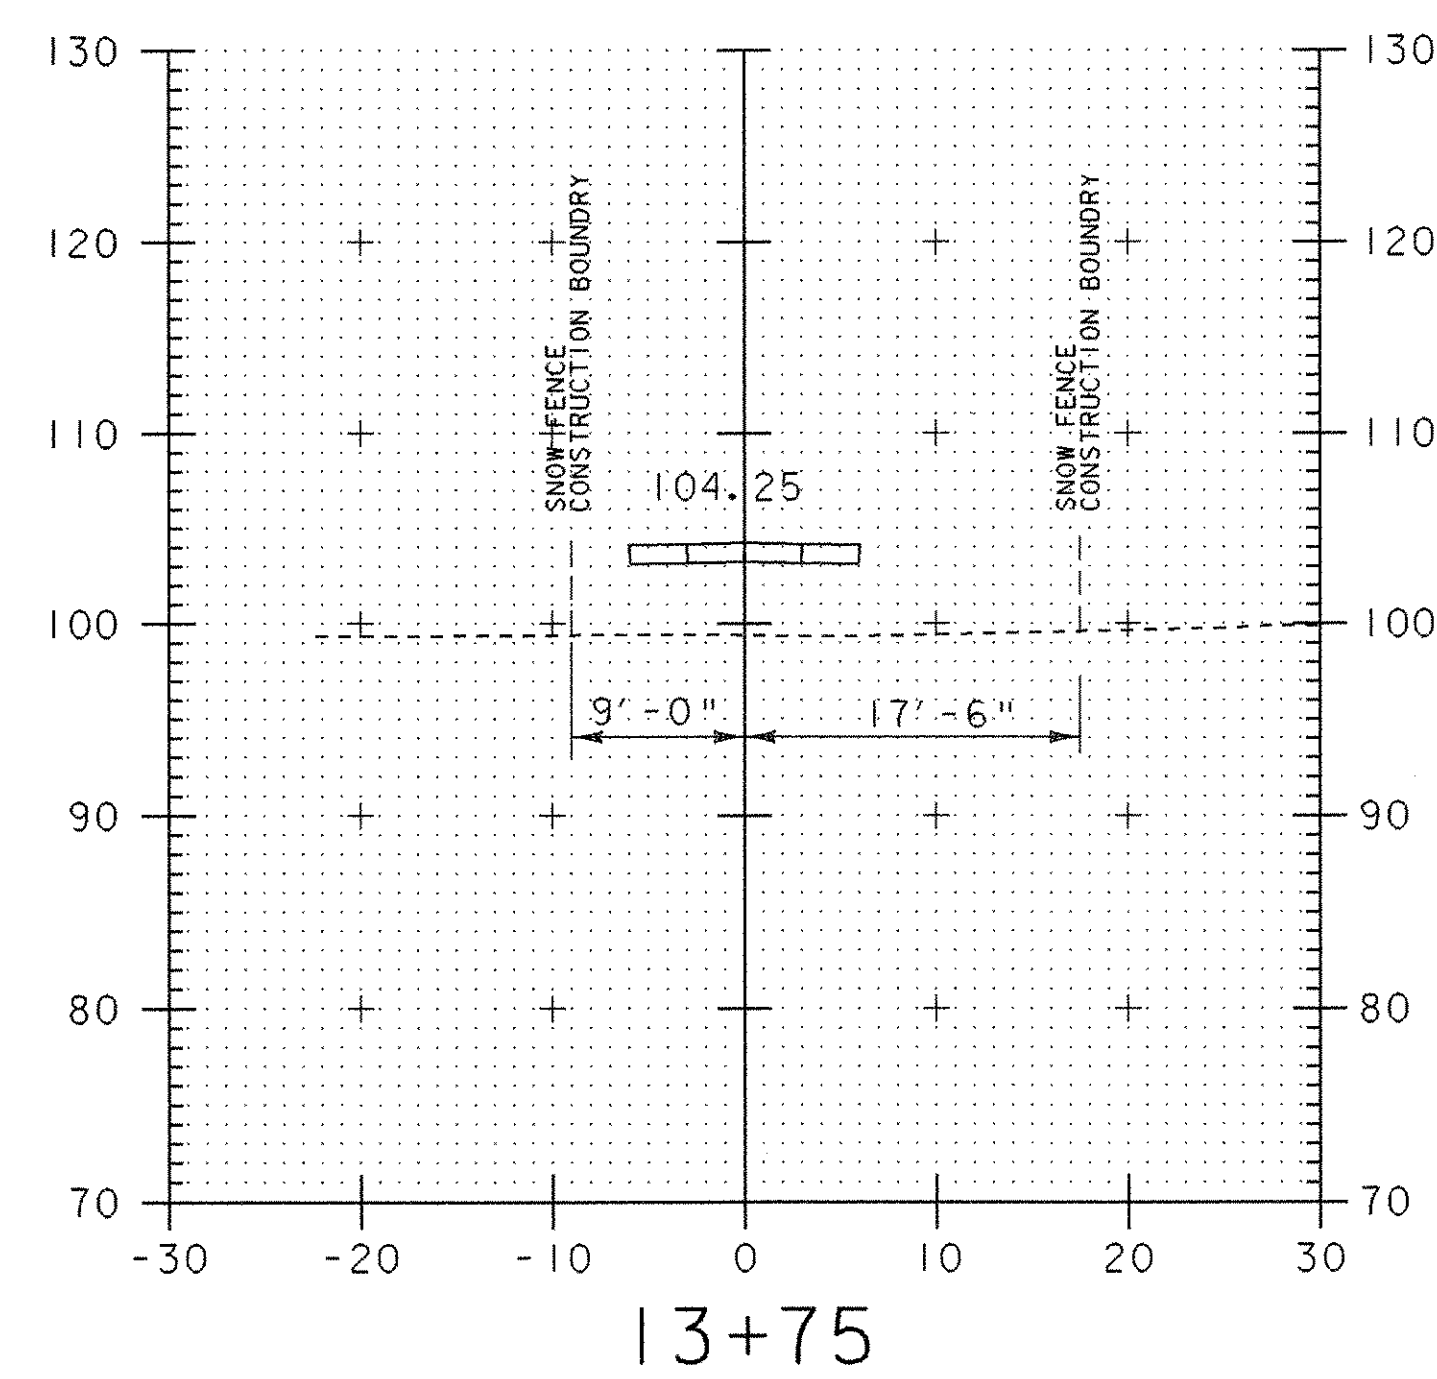
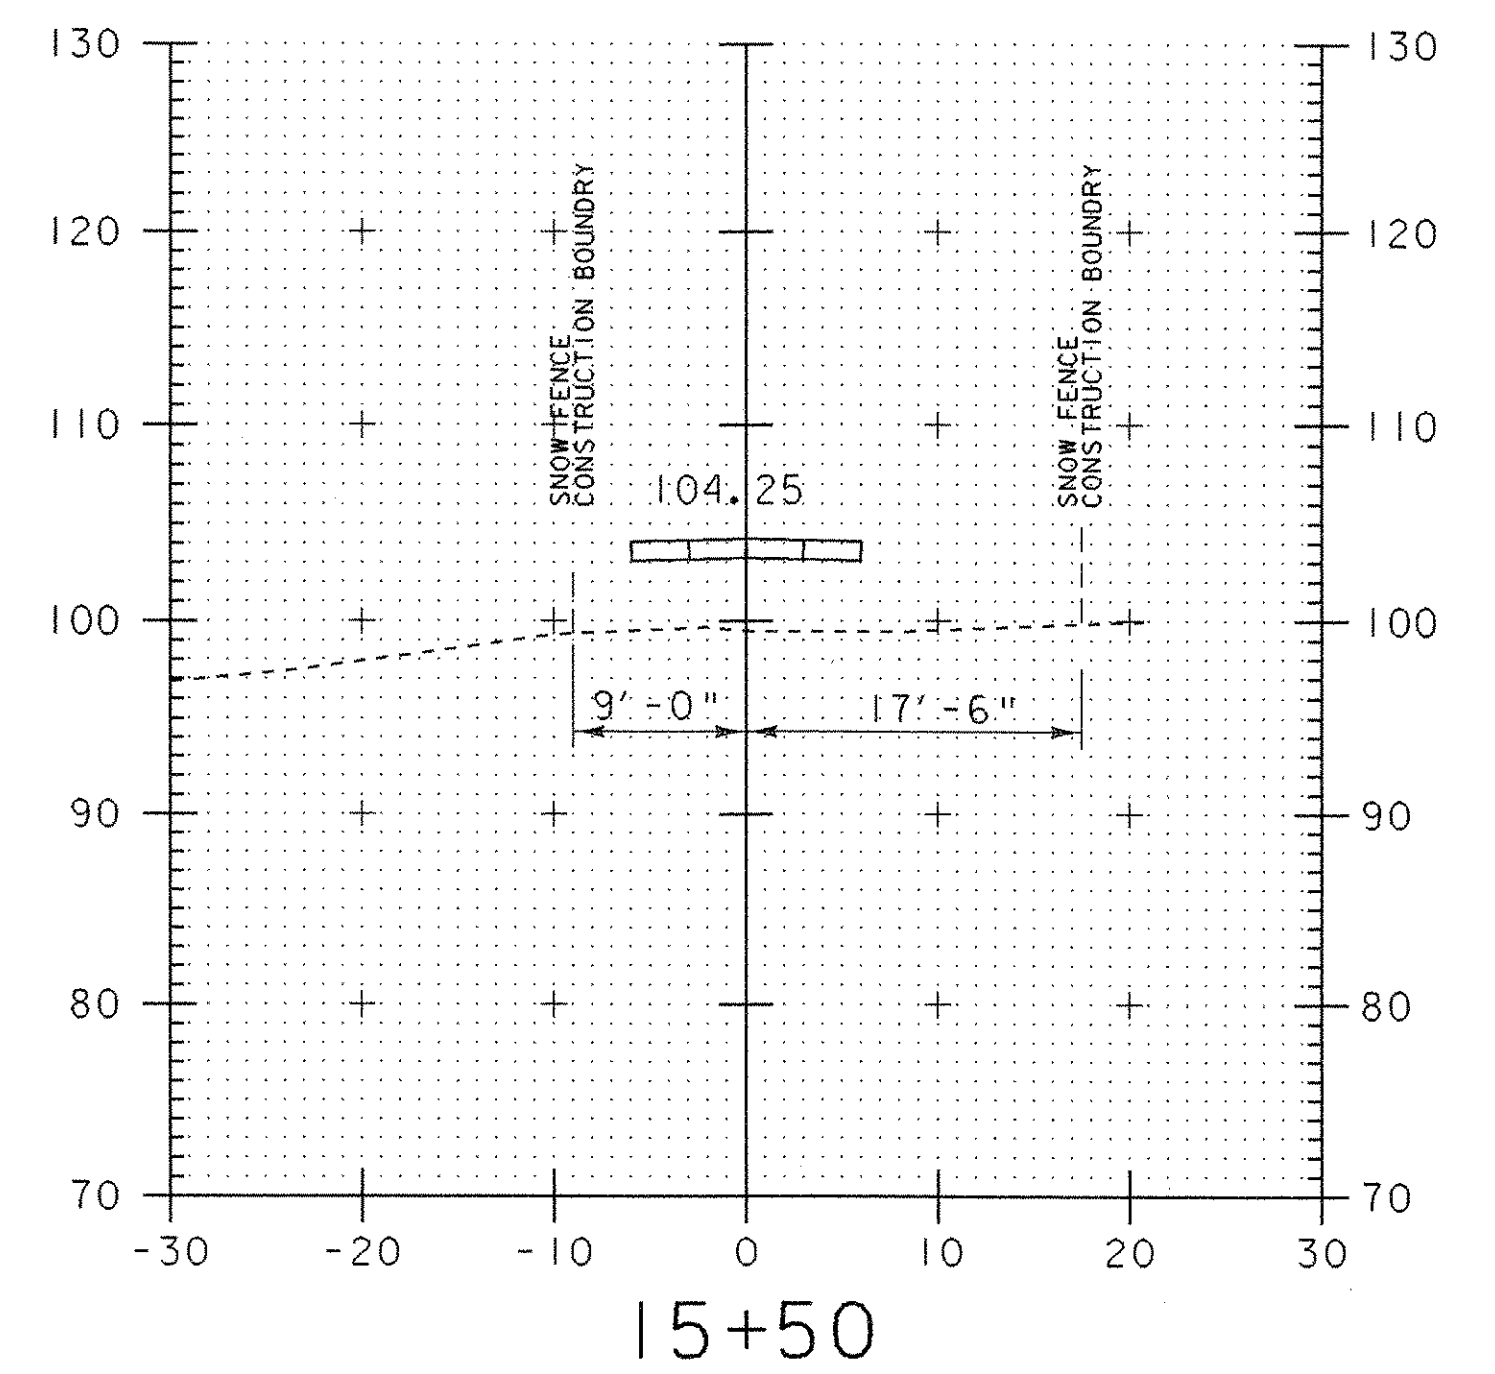
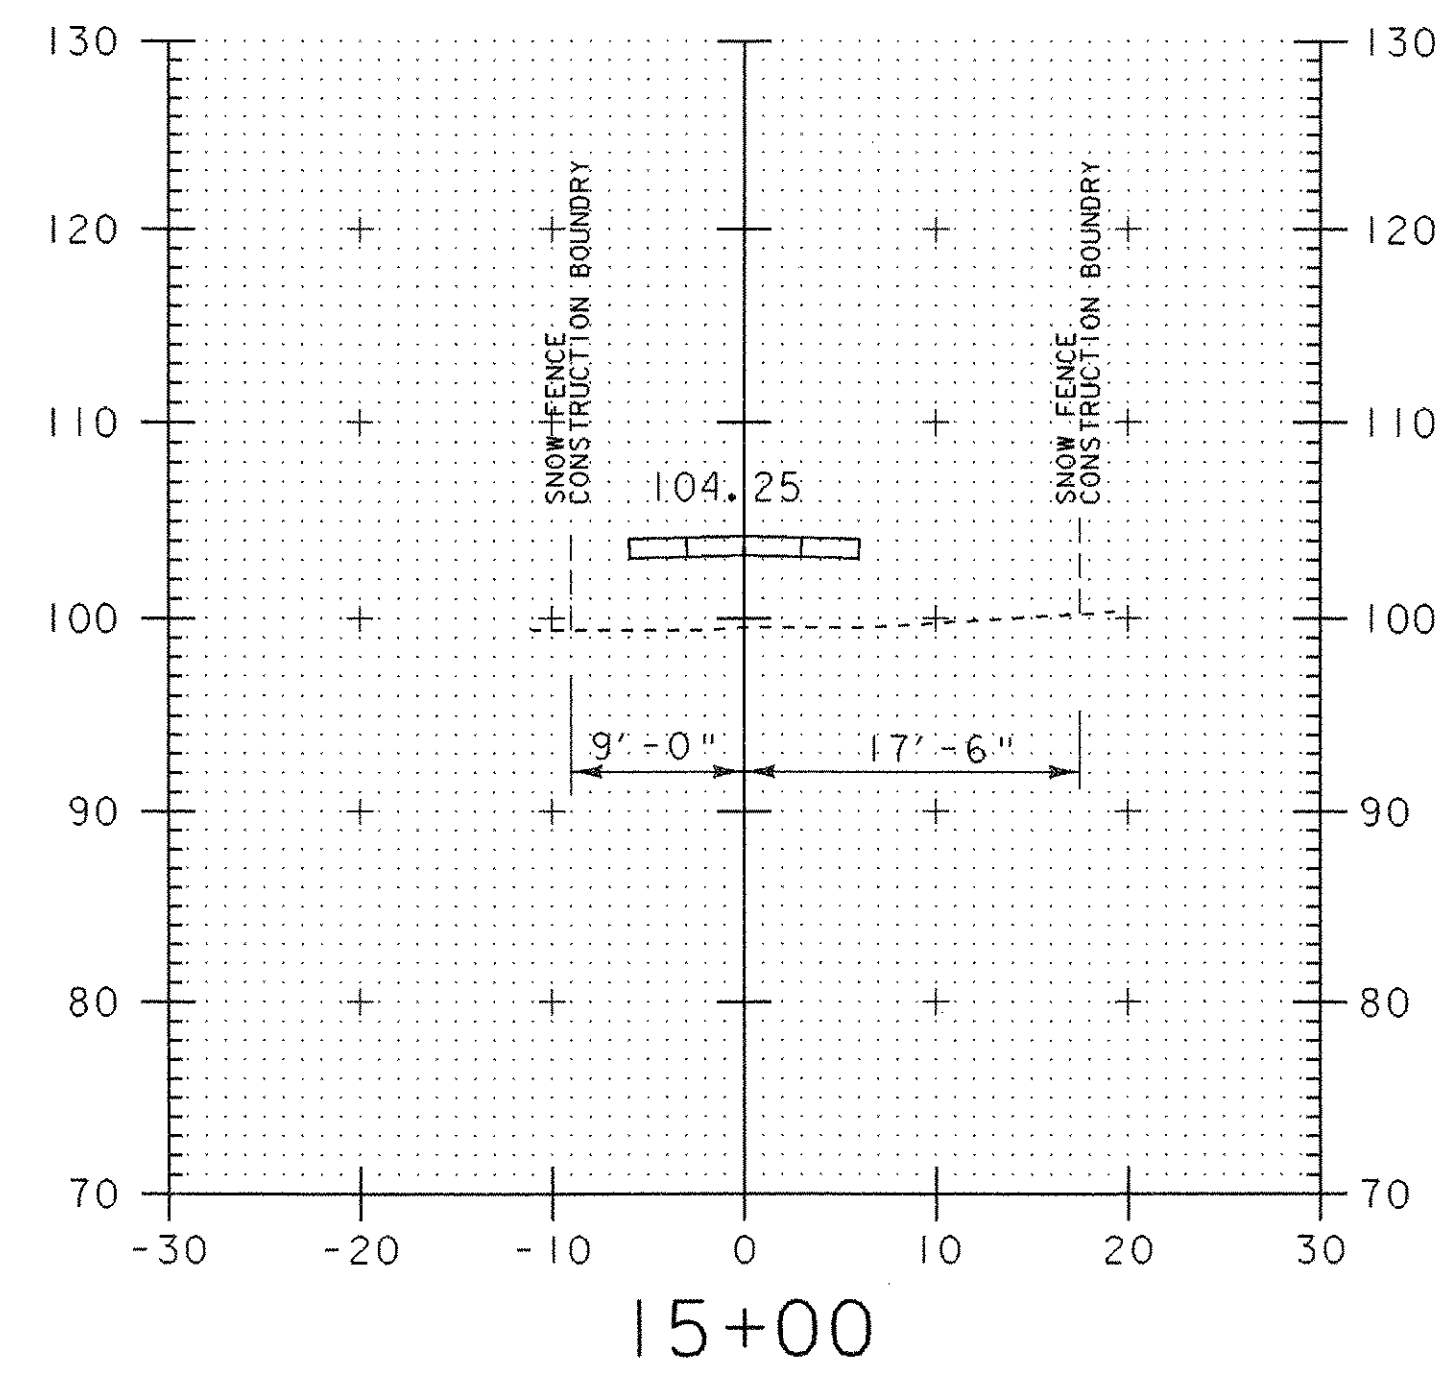
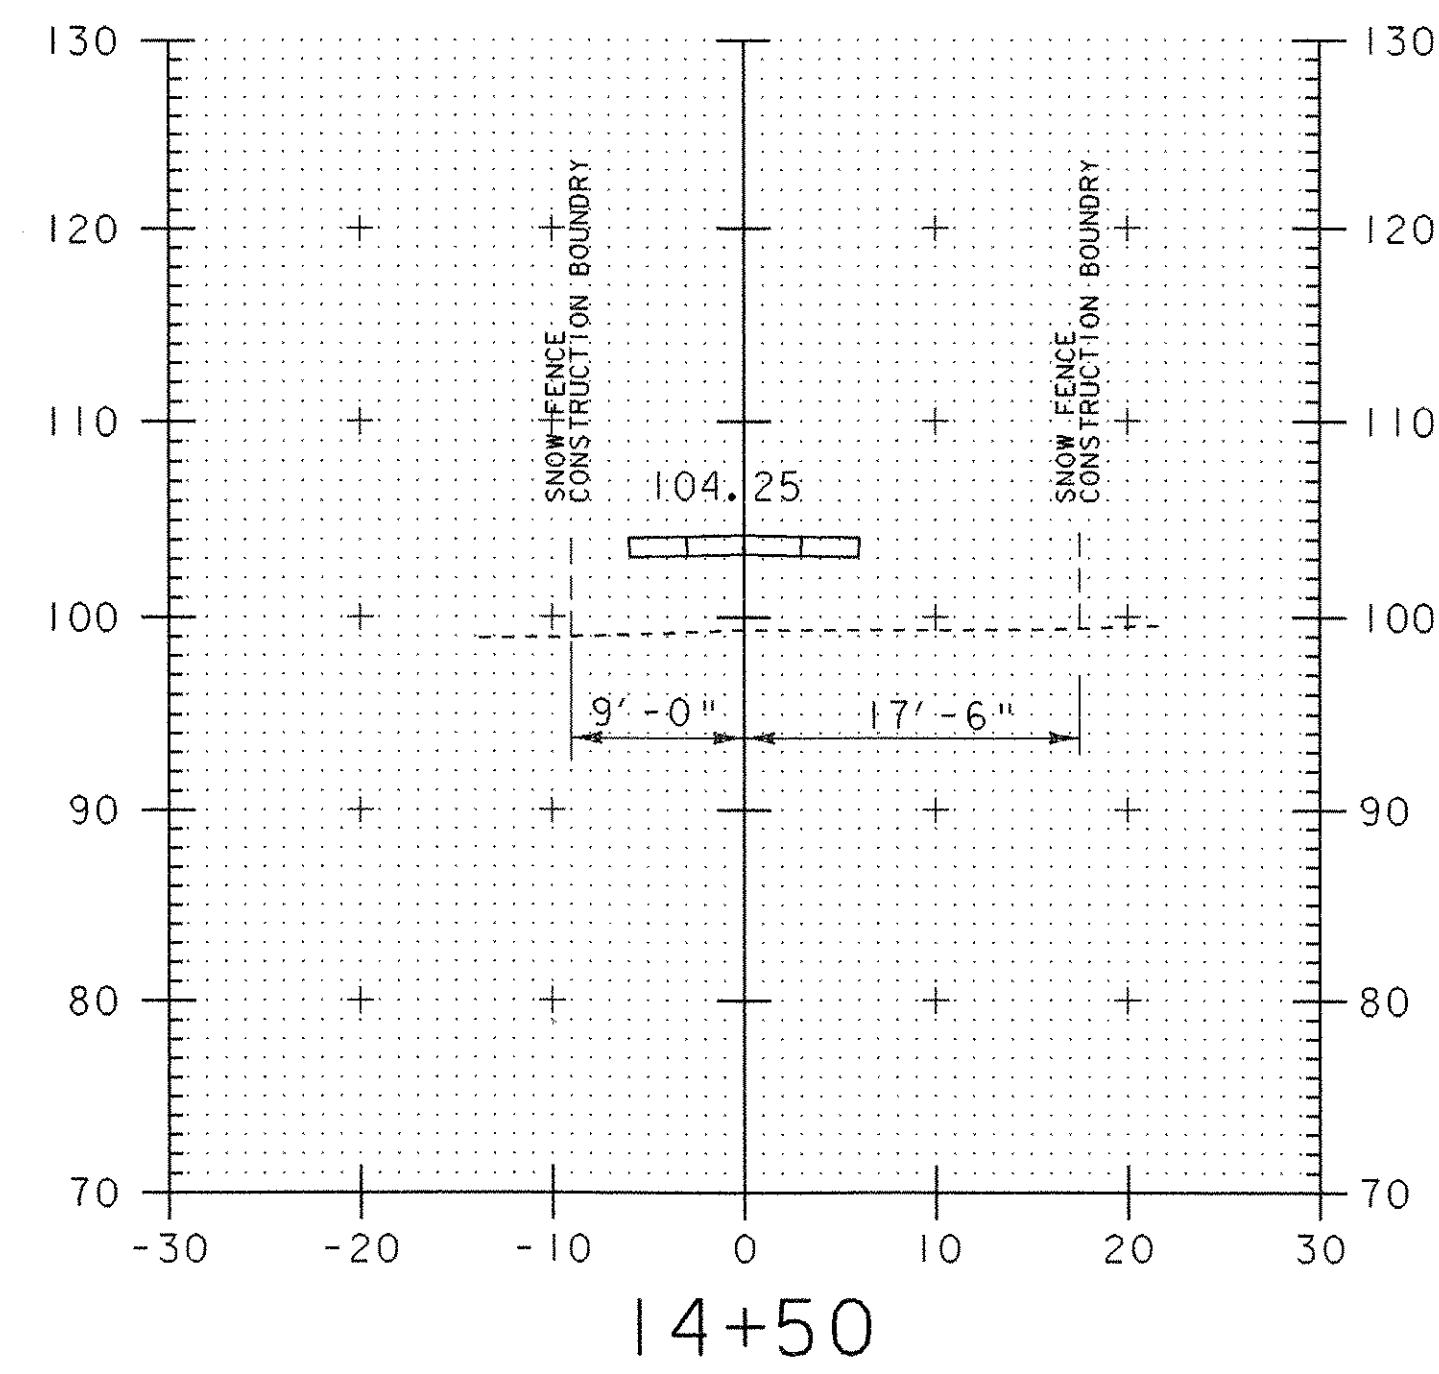


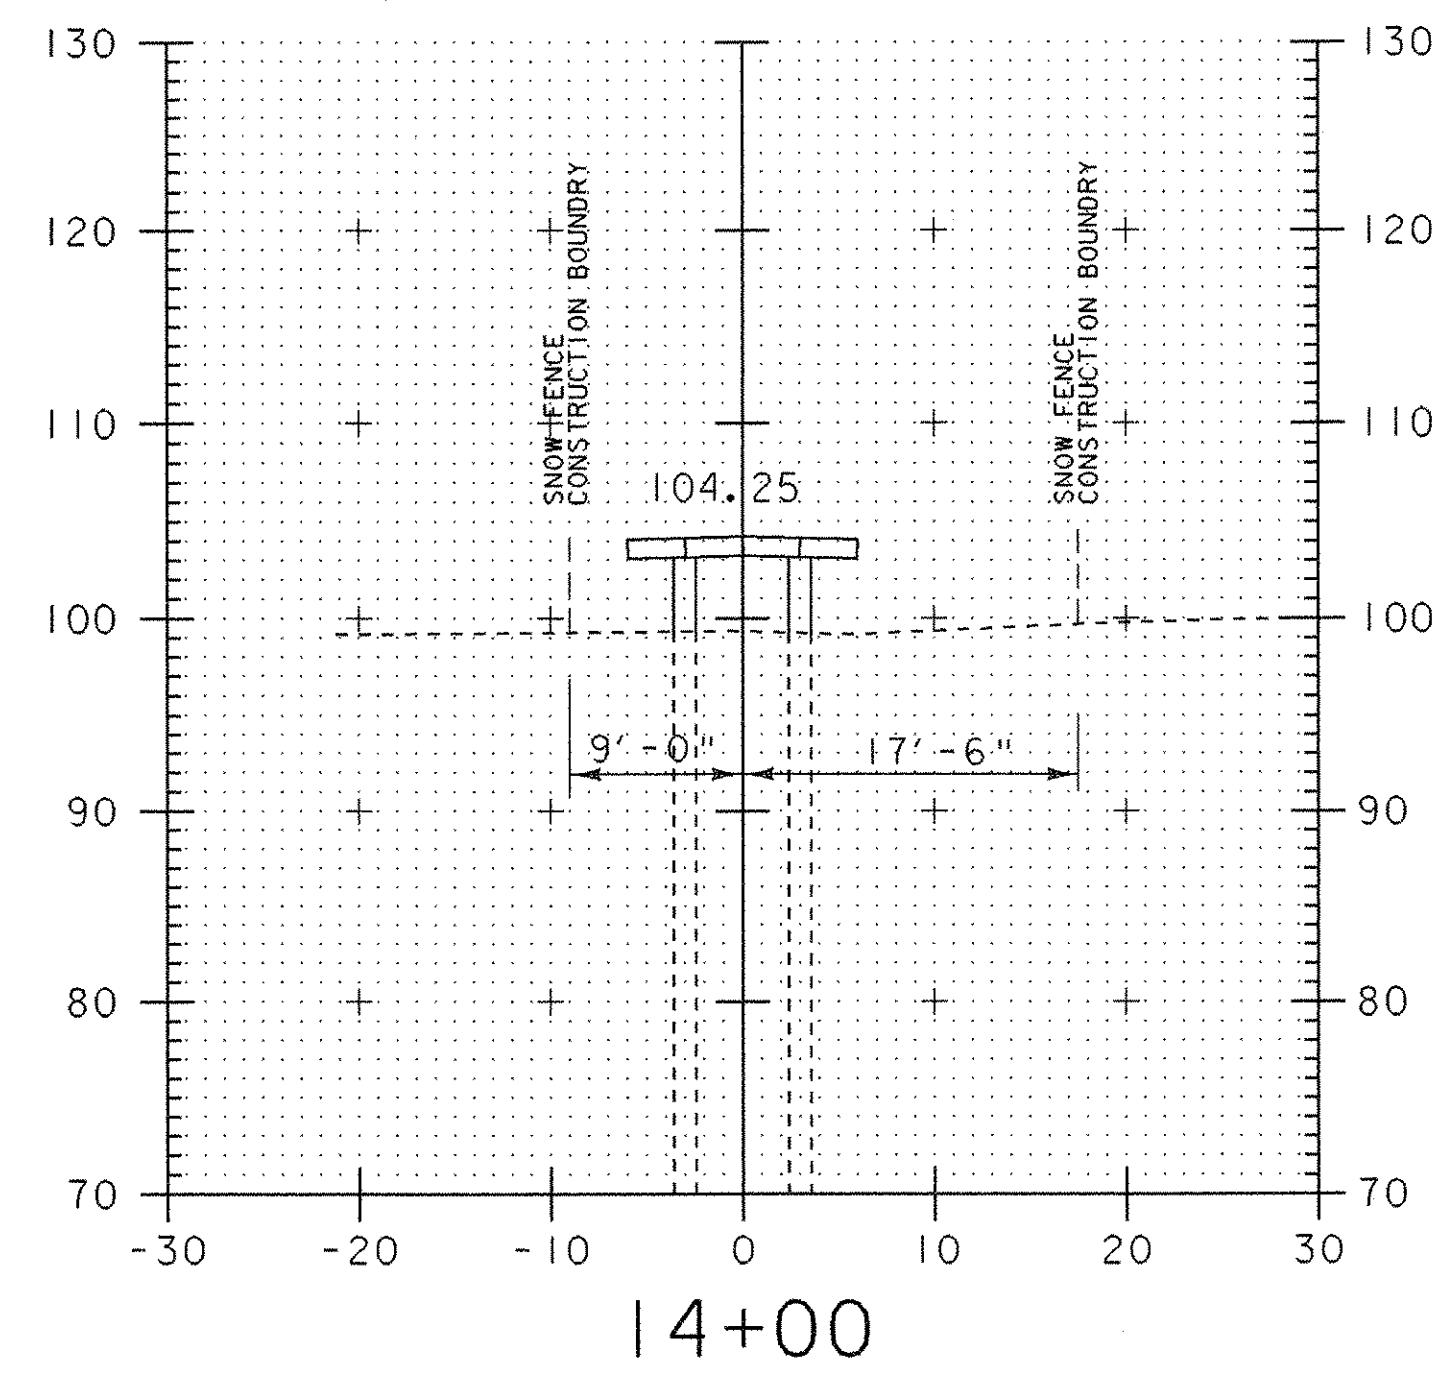

CROSS SECTIONS
13+75 - 15+50

PROJECT NAME:	Colchester
PROJECT NUMBER:	STP Bike(48)
FILE NAME:s\tr5\03f038\s\038xsl.dgn	PLOT DATE: 05-AUG-2003
PROJECT LEADER: C. Keller	DRAWN BY: G. Shangraw
DESIGNED BY: G. Shangraw	CHECKED BY:
s\038xsl.i	SHEET 77 OF 87