




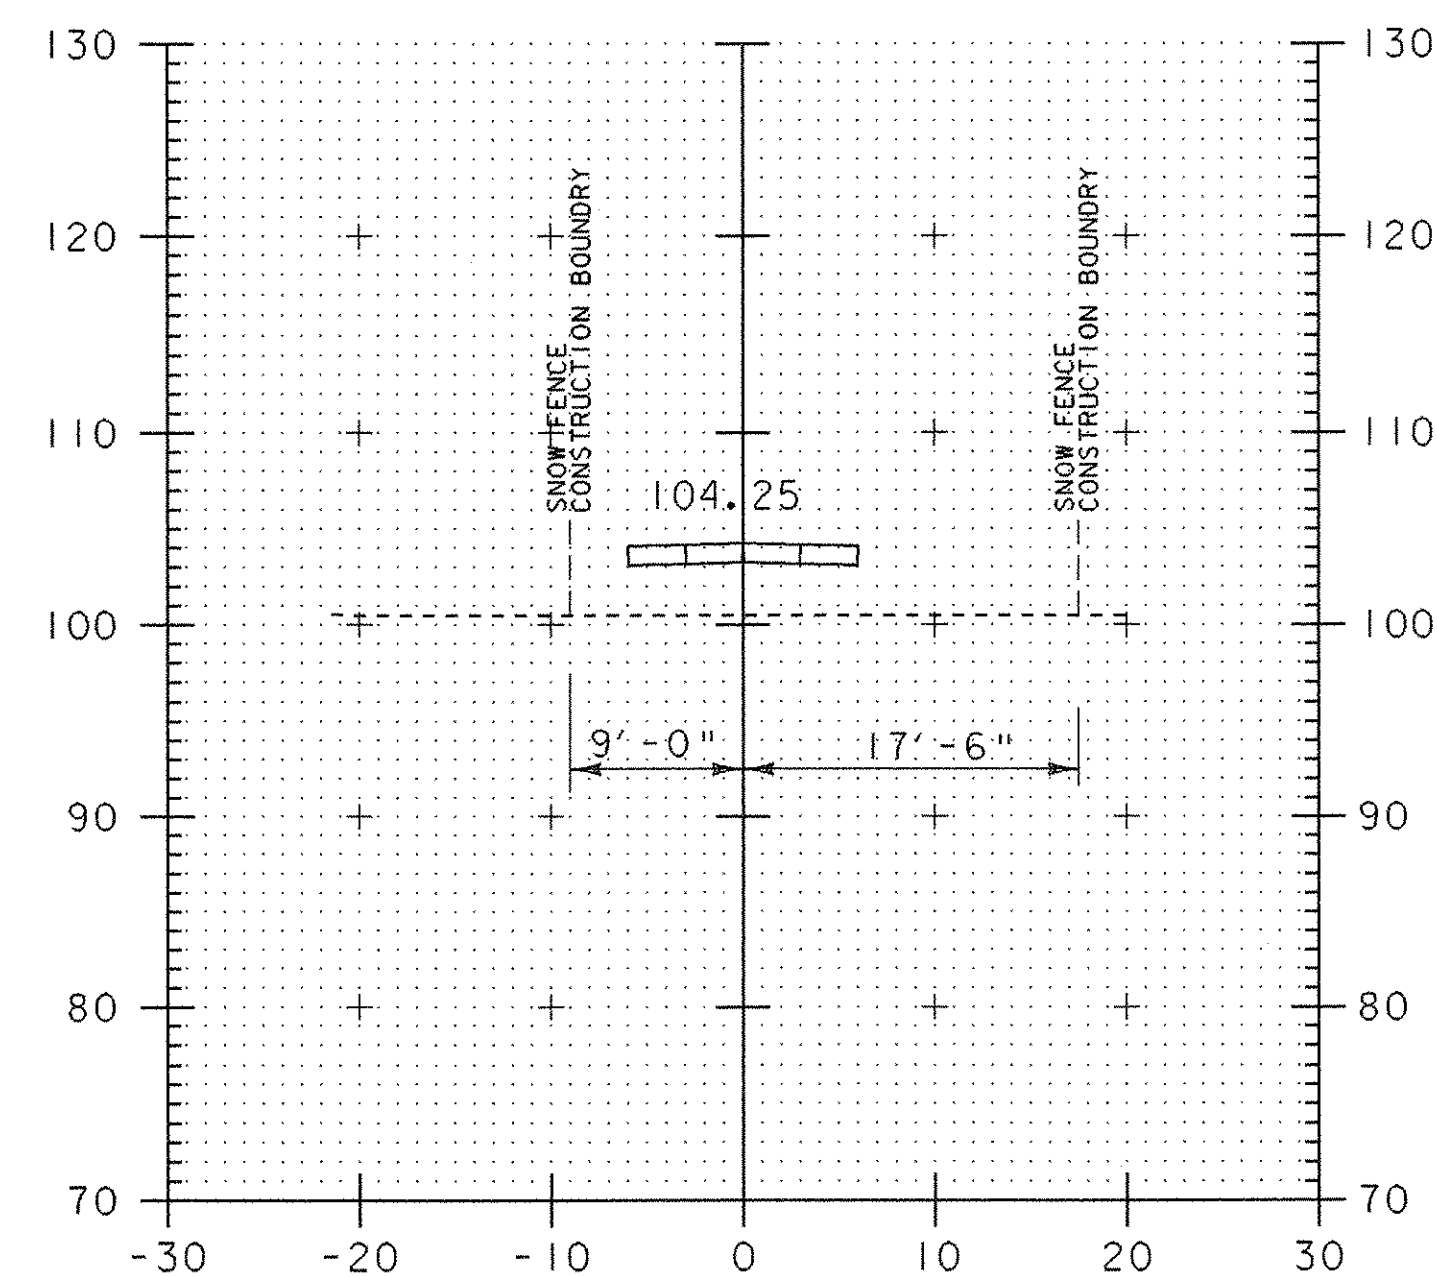


20+00

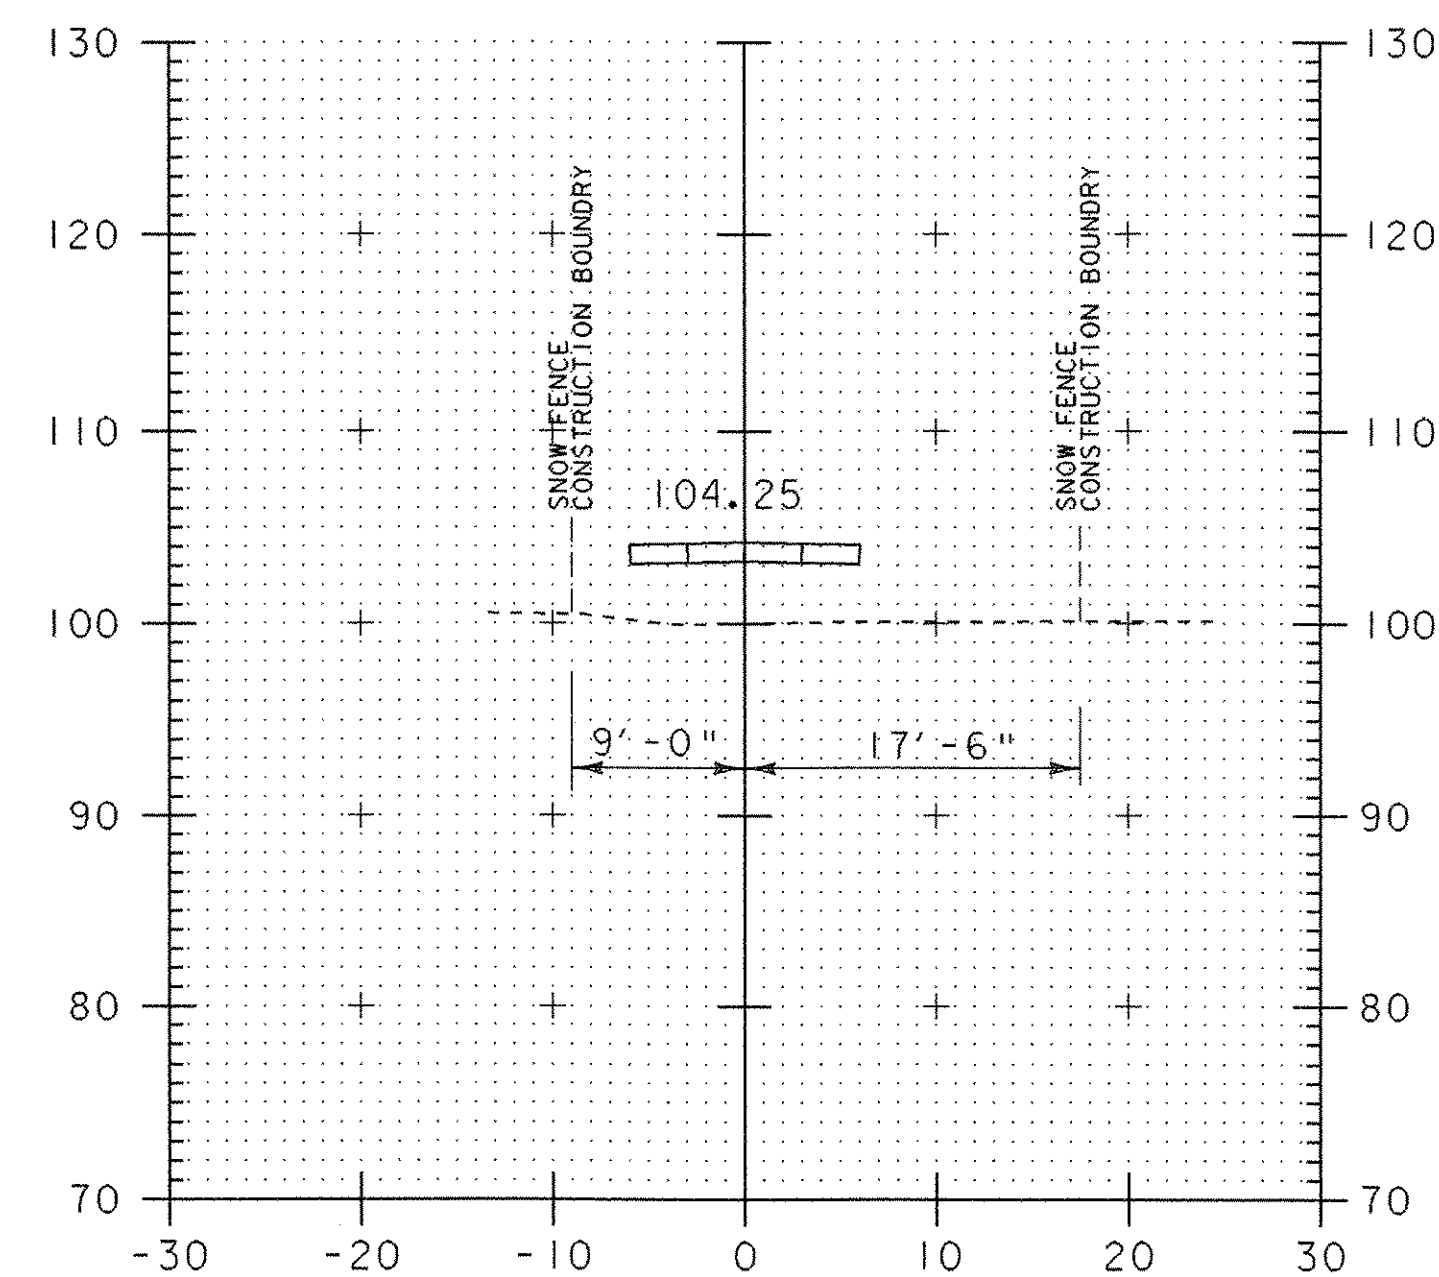


20+50

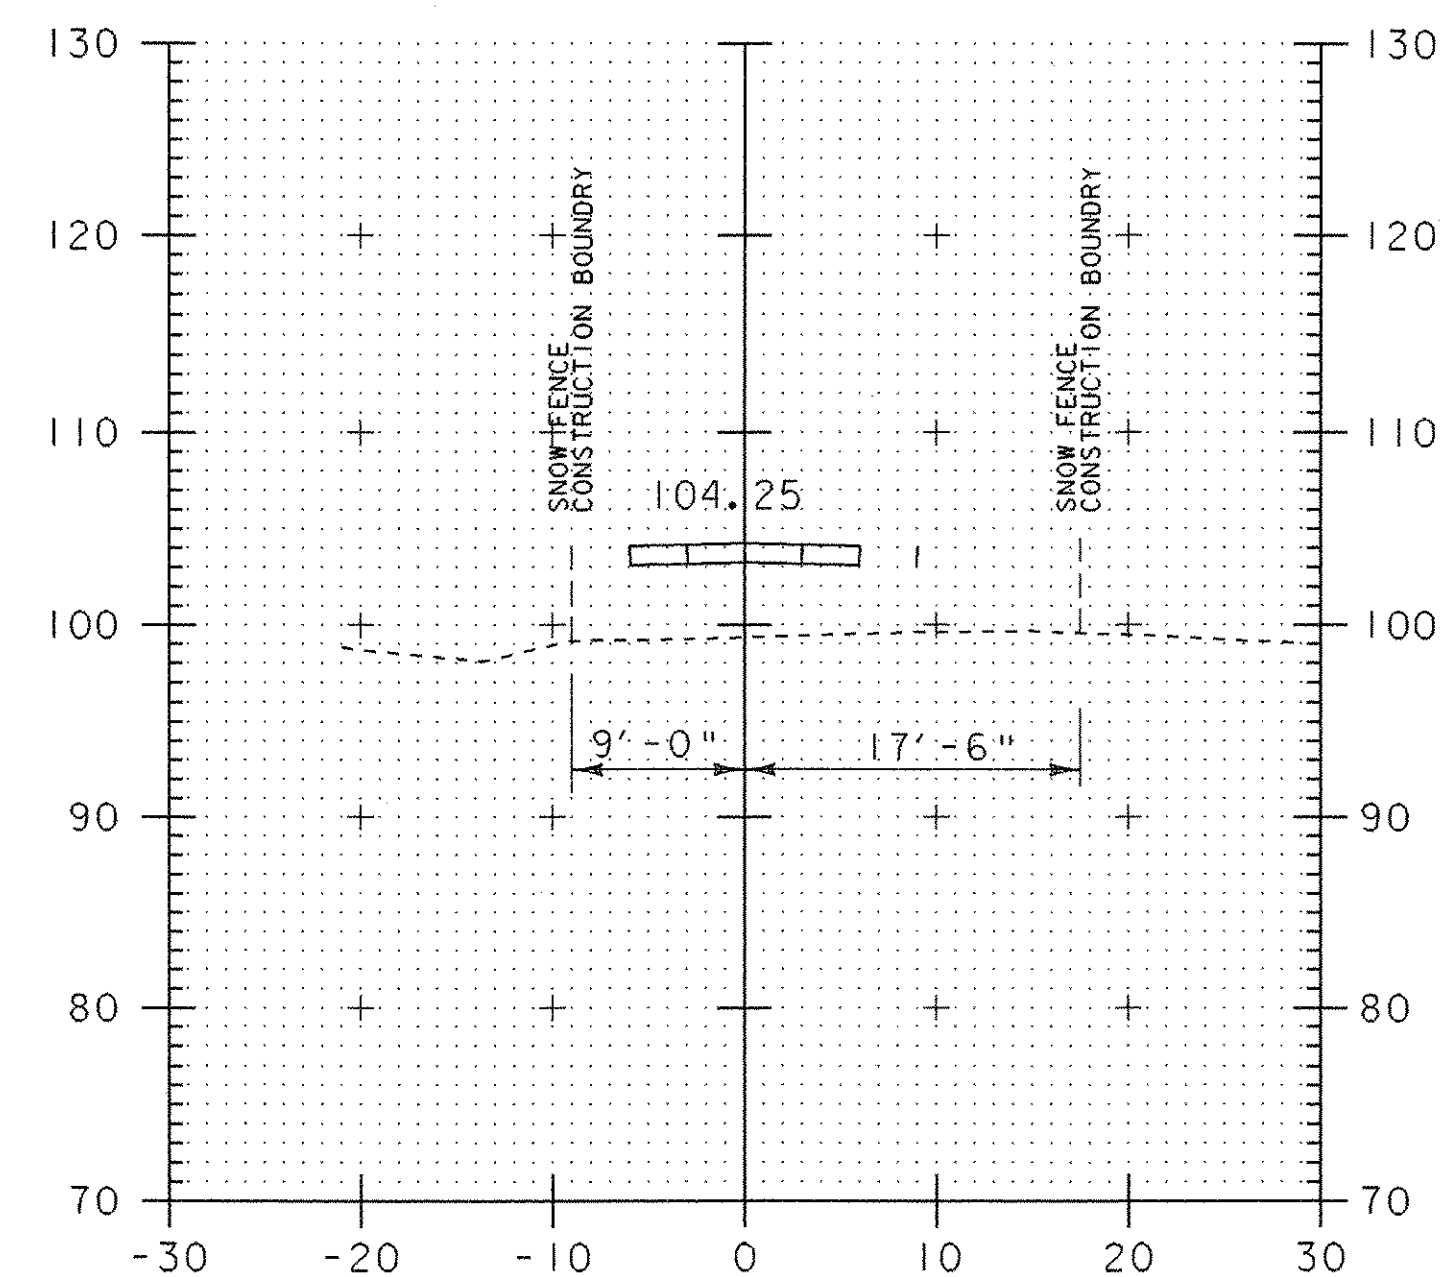


21+00

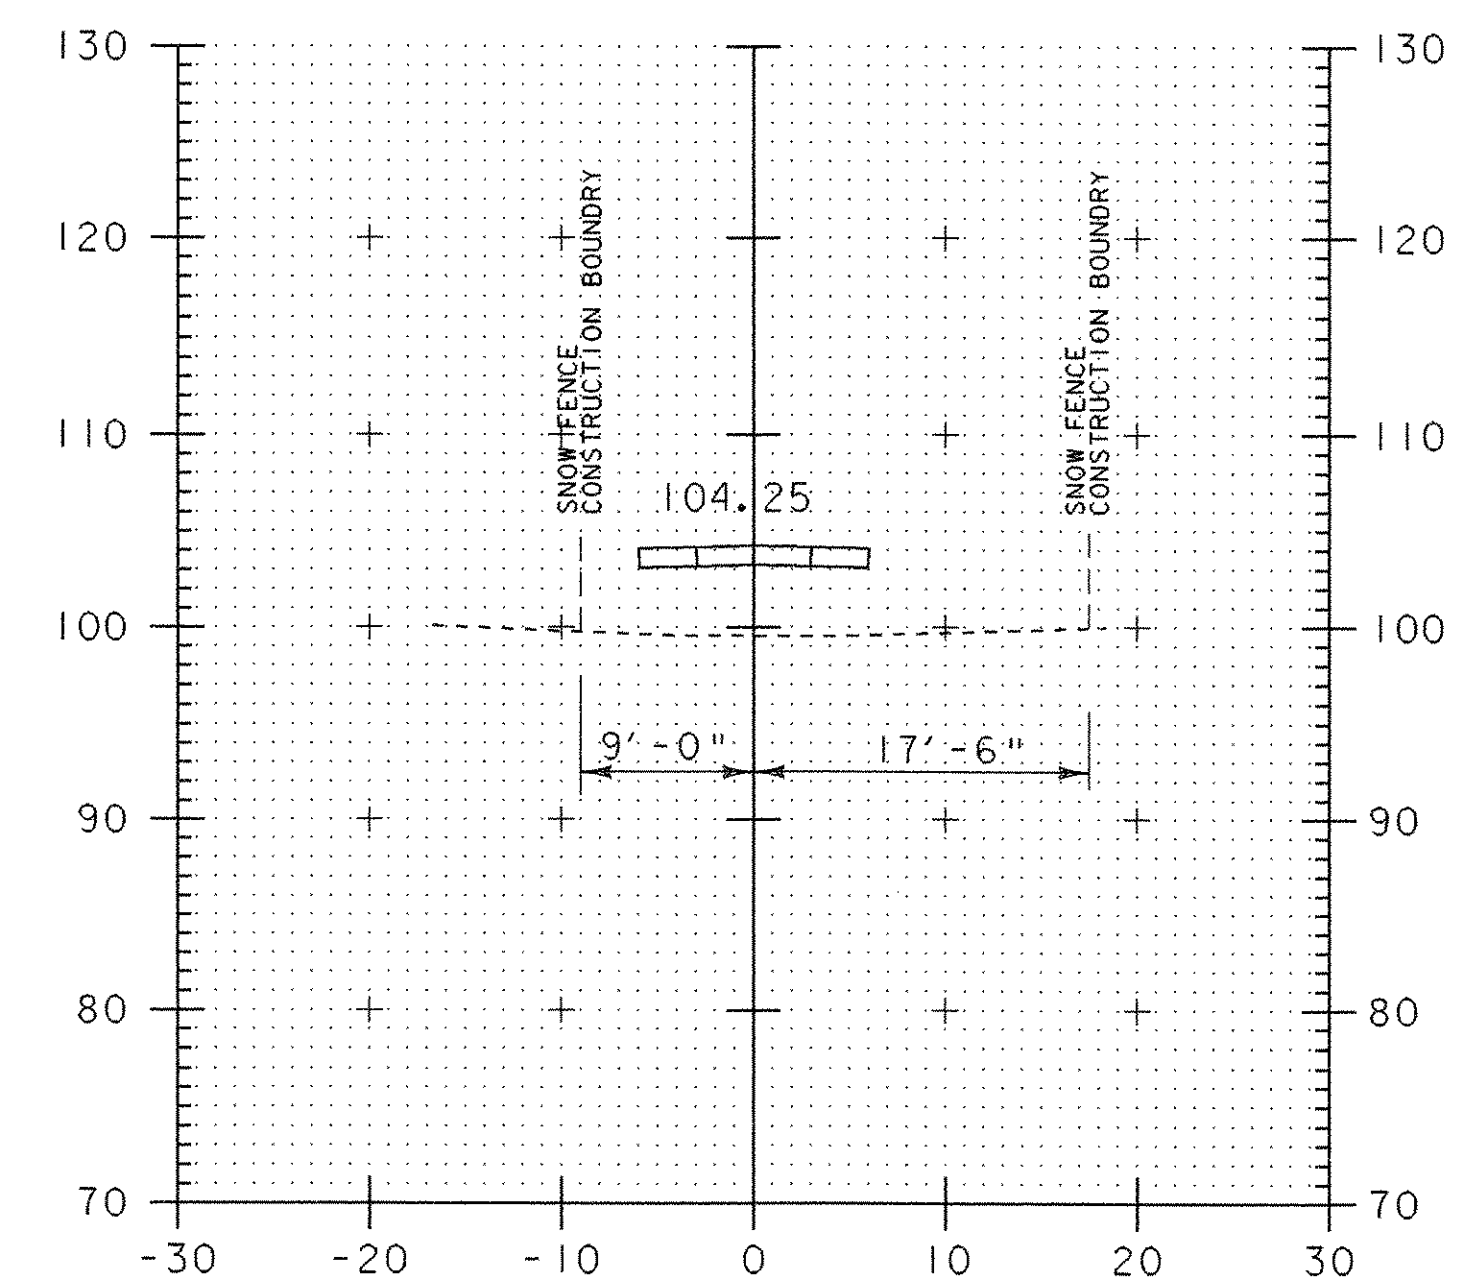


21+50

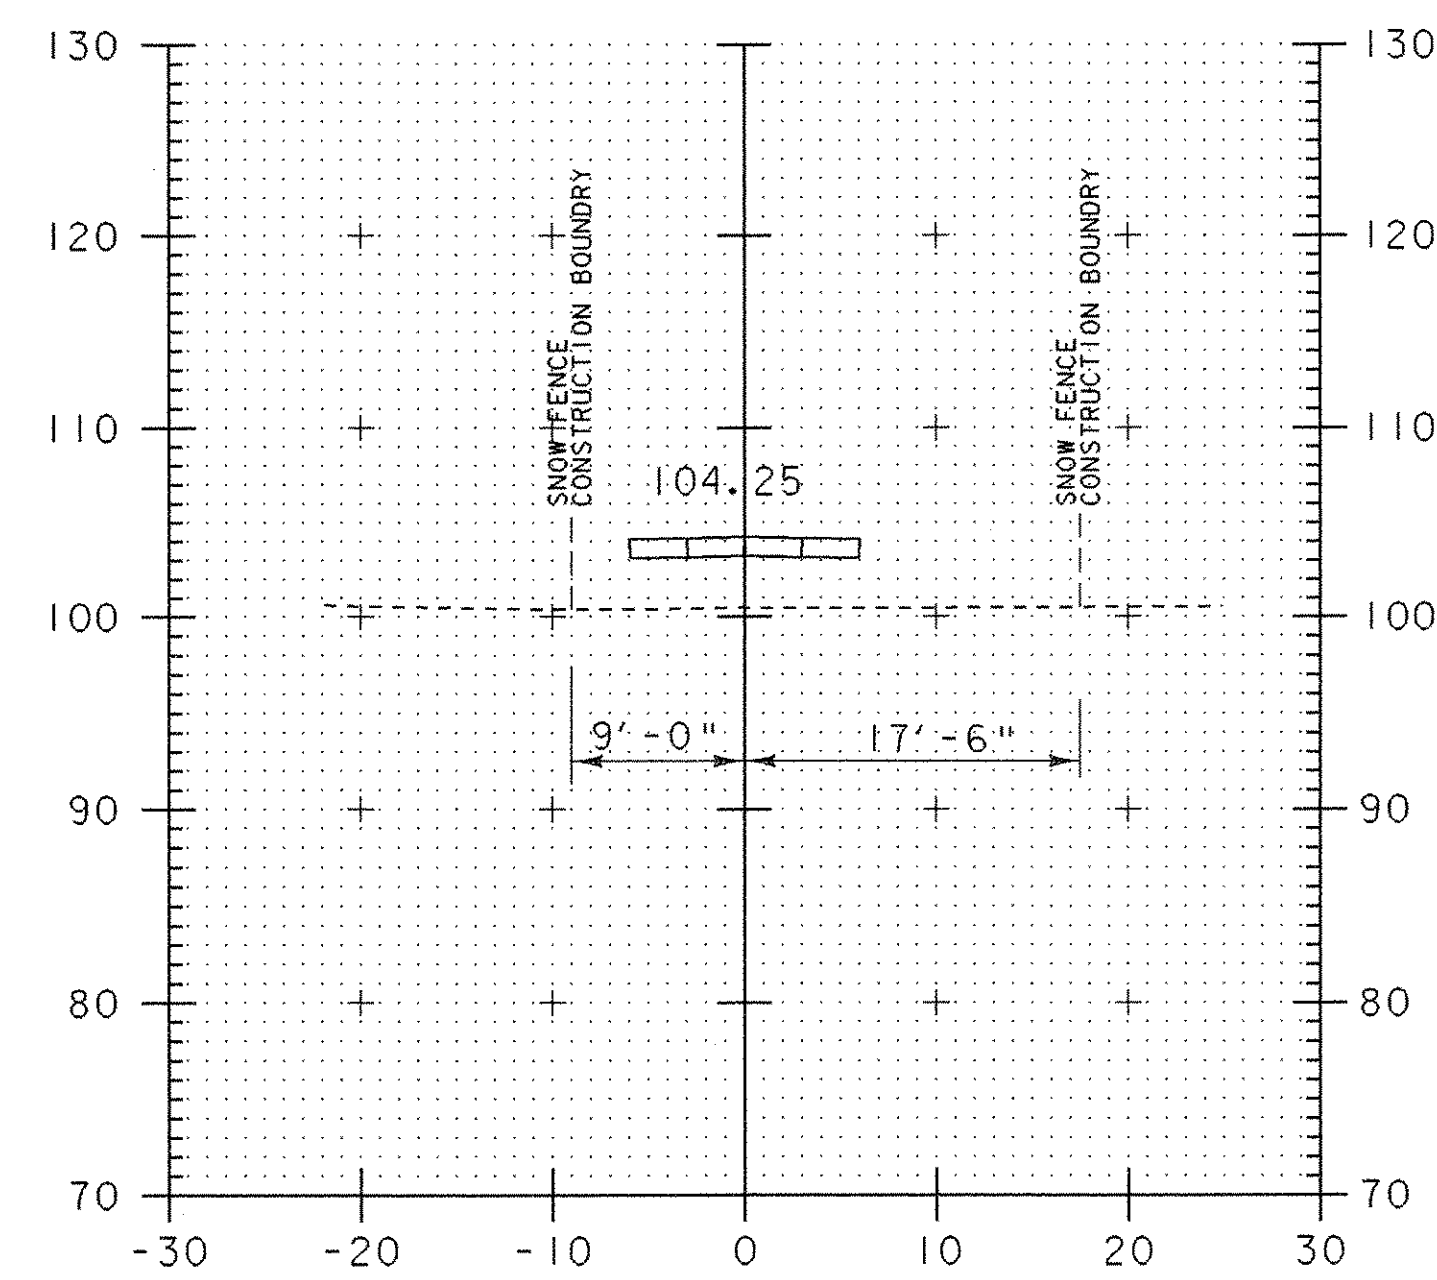


19+75

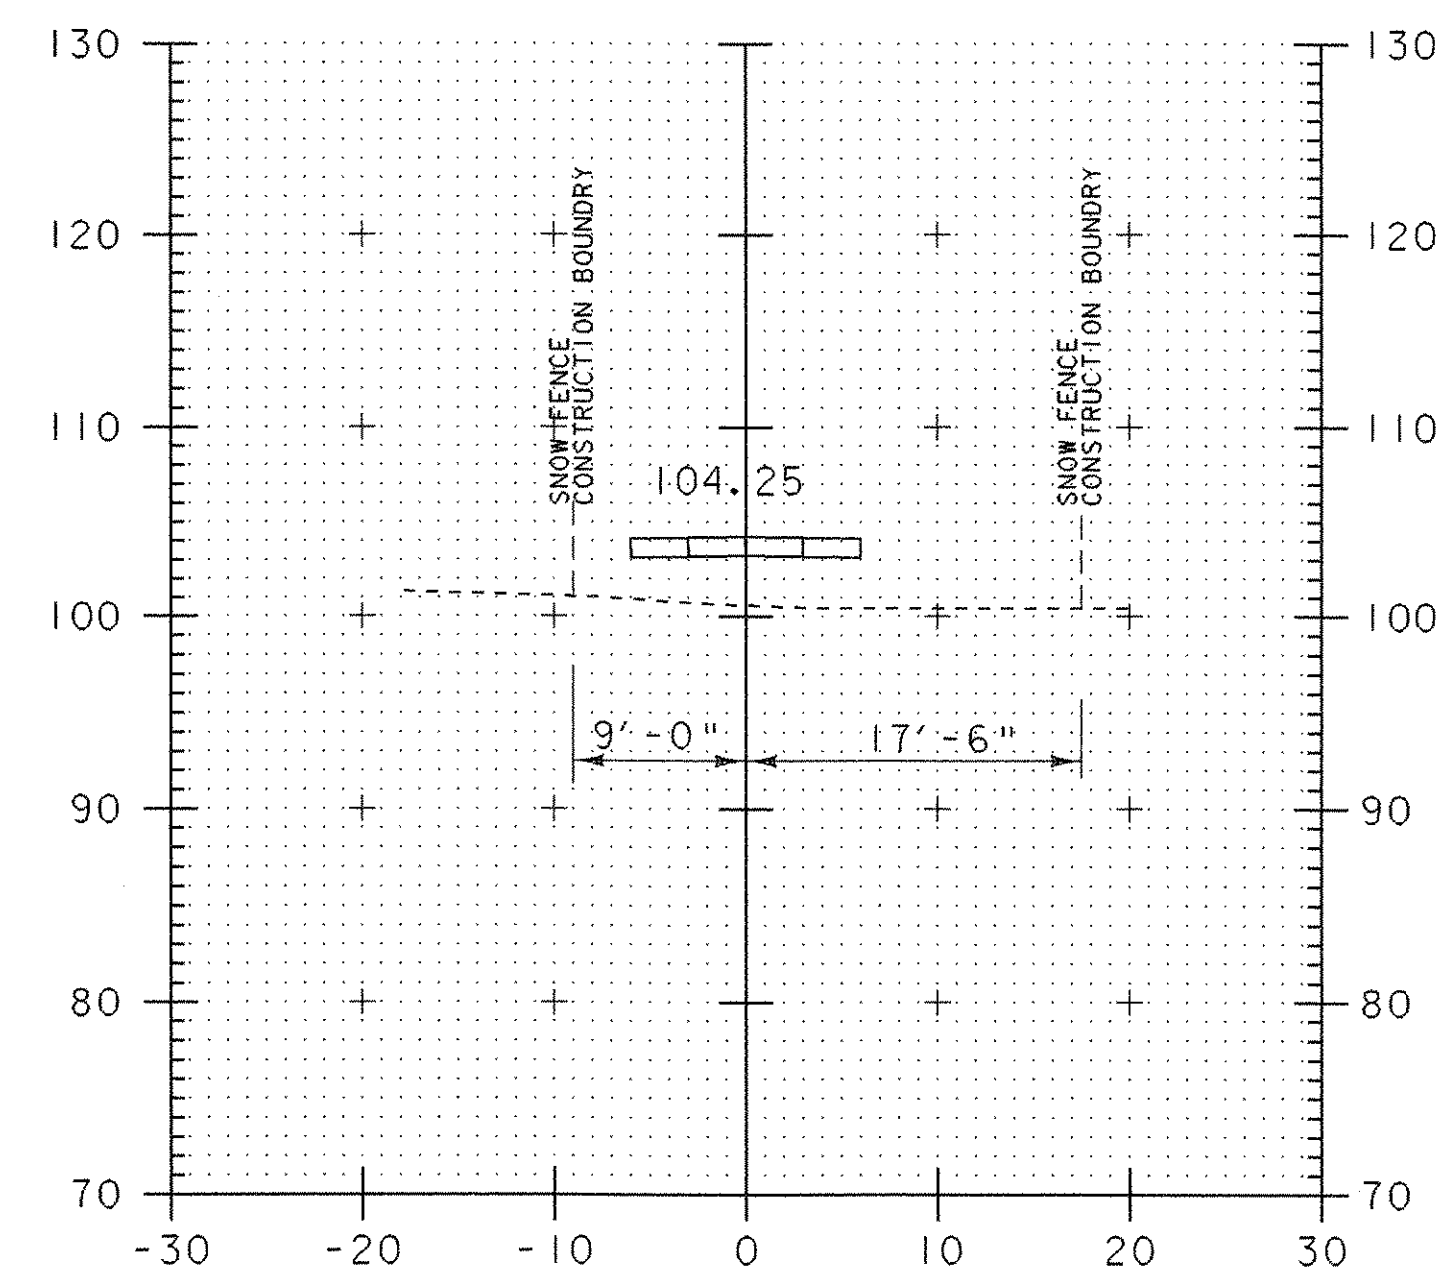

20+25

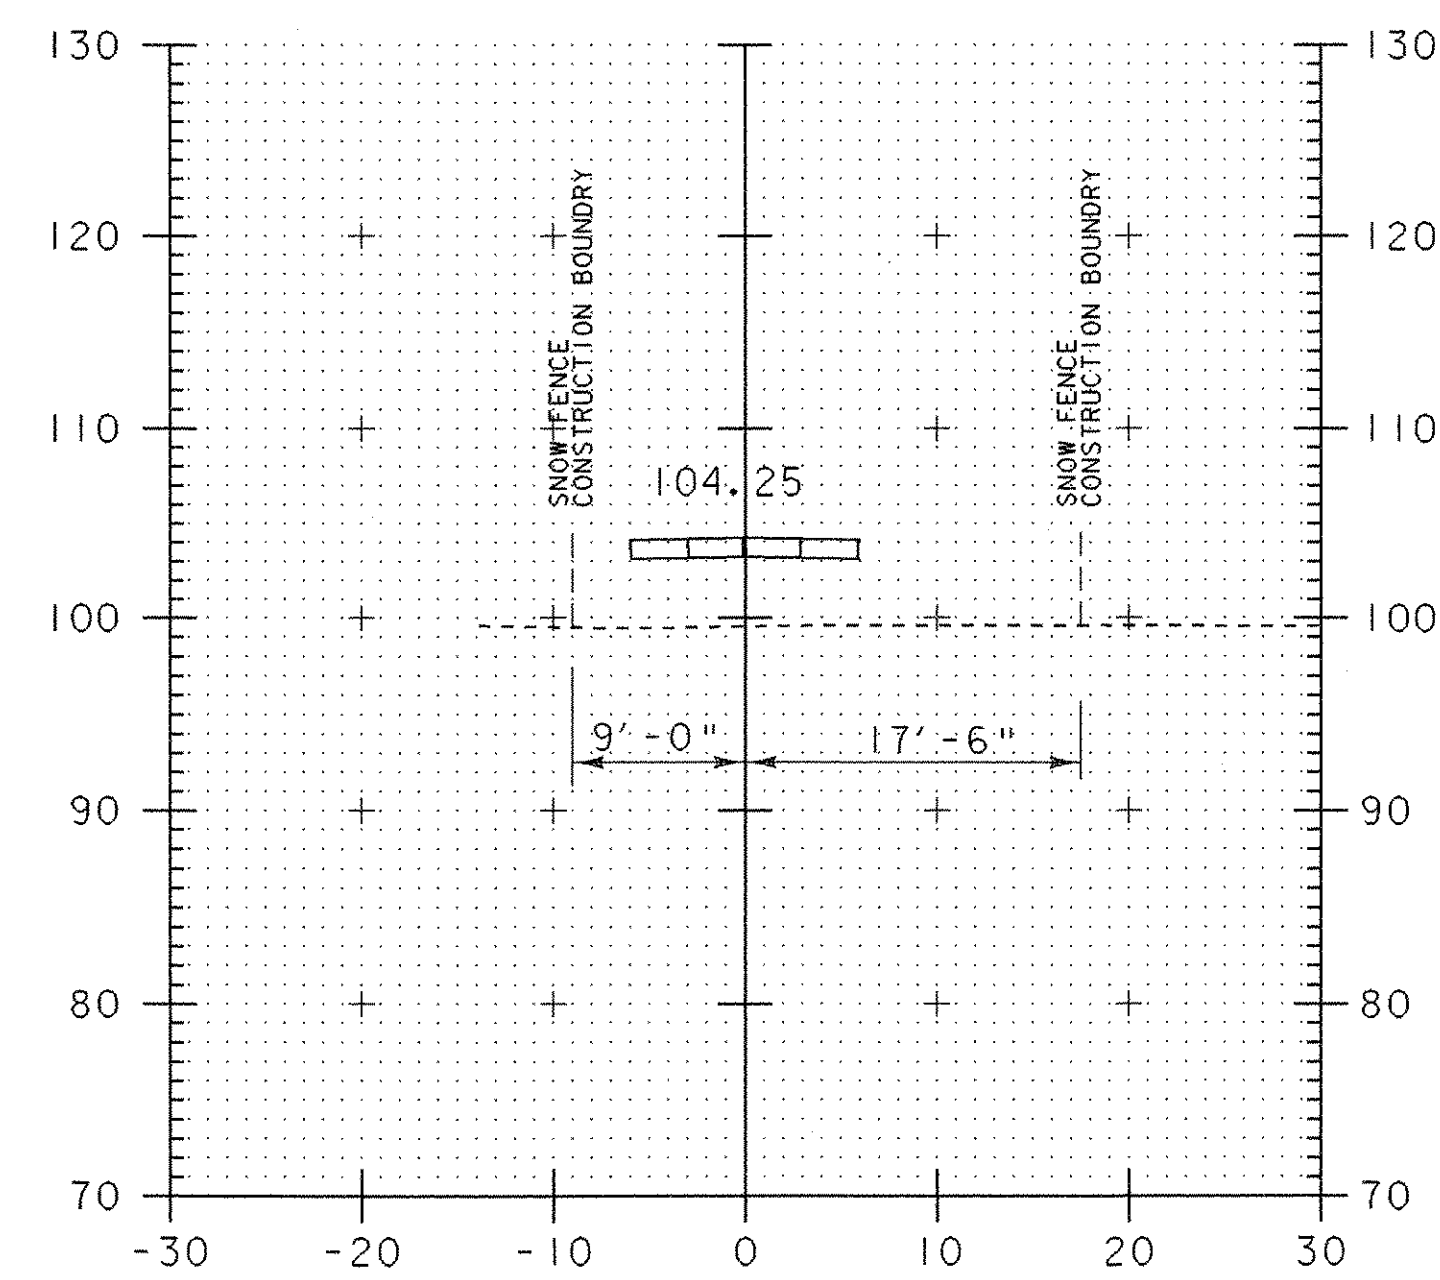

20+75

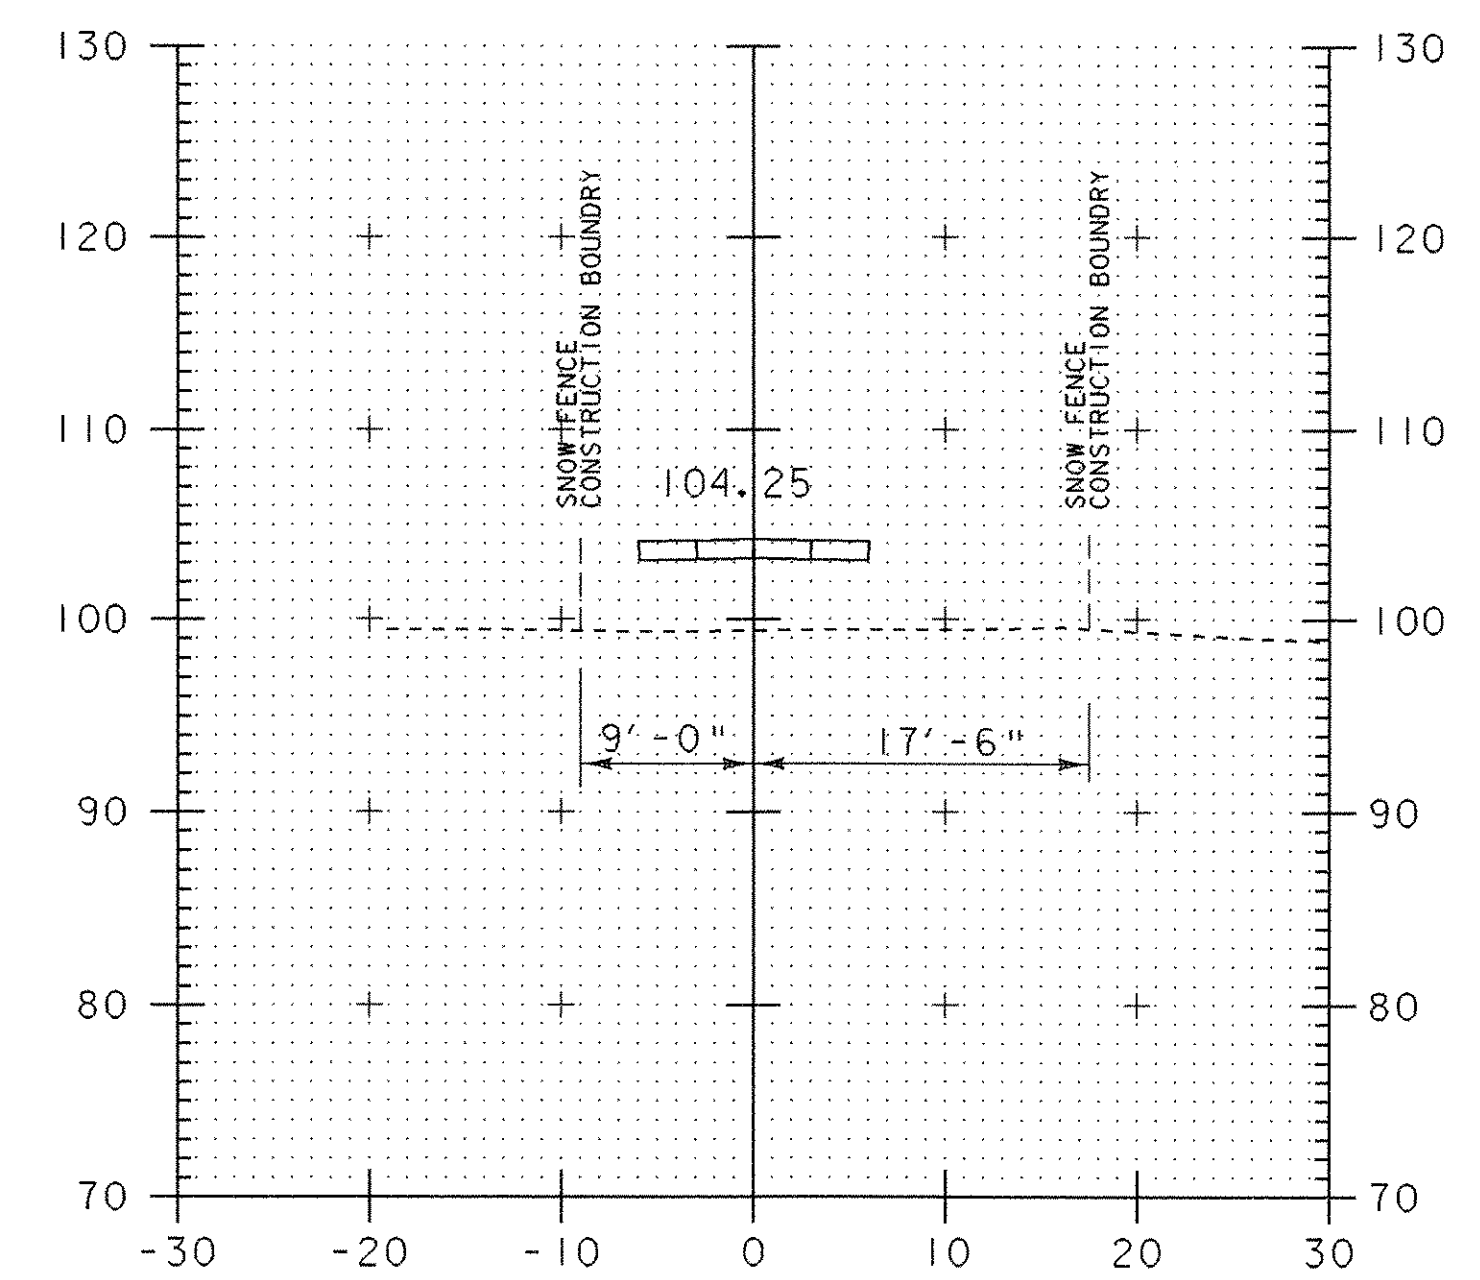

21+25

CROSS SECTIONS 19+75 - 21+50

PROJECT NAME: Colchester
PROJECT NUMBER: STP Bike(48)

FILE NAME: str5/03f038/sf038xsl.dgn PLOT DATE: 05-AUG-2003
PROJECT LEADER: C. Keller DRAWN BY: G. Shangraw
DESIGNED BY: G. Shangraw CHECKED BY:
sf038xsl.i SHEET 80 OF 87