




23+50

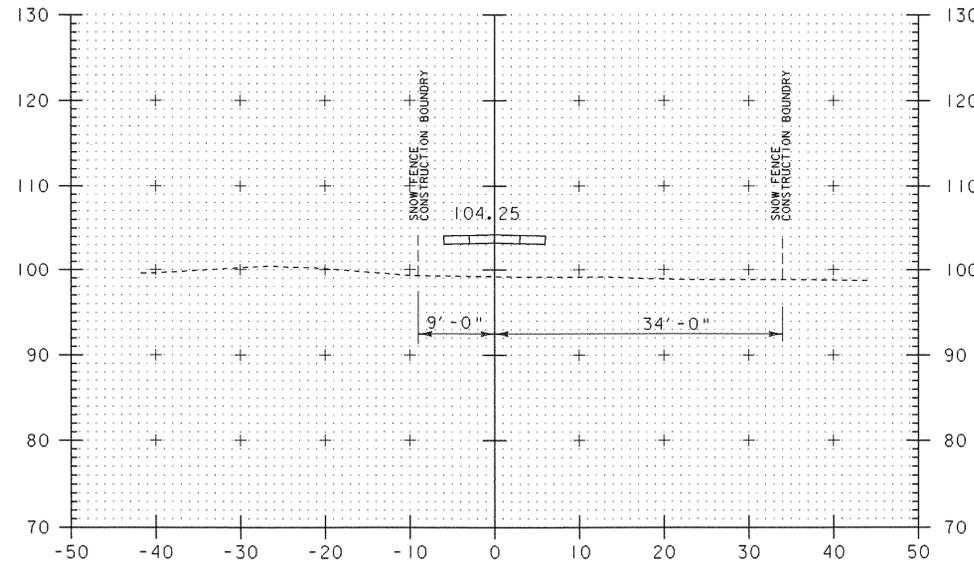

24+00

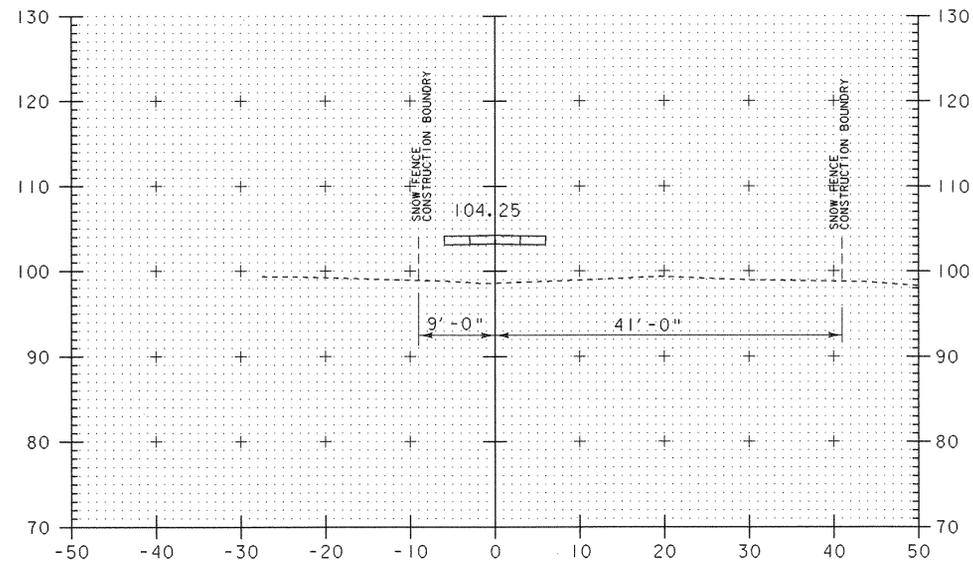

23+25

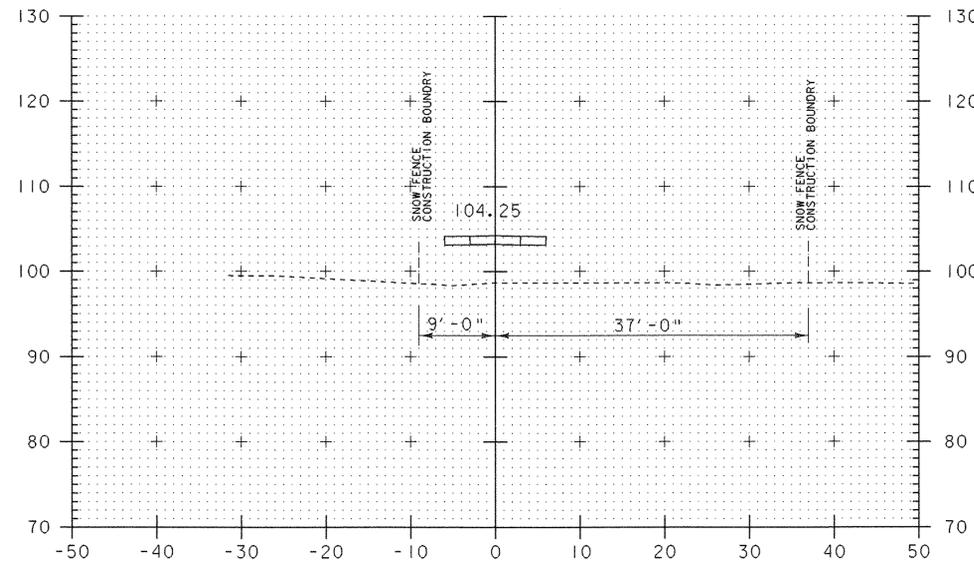

23+75

CROSS SECTIONS 23+25 - 24+00

PROJECT NAME:	Colchester
PROJECT NUMBER:	STP Bike(48)
FILE NAME:\str5\03f038\s038xsl.dgn	PLOT DATE: 05-AUG-2003
PROJECT LEADER: C. Keller	DRAWN BY: G. Shangraw
DESIGNED BY: G. Shangraw	CHECKED BY:
sf038xsl3.1	SHEET 82 OF 87