




24+50

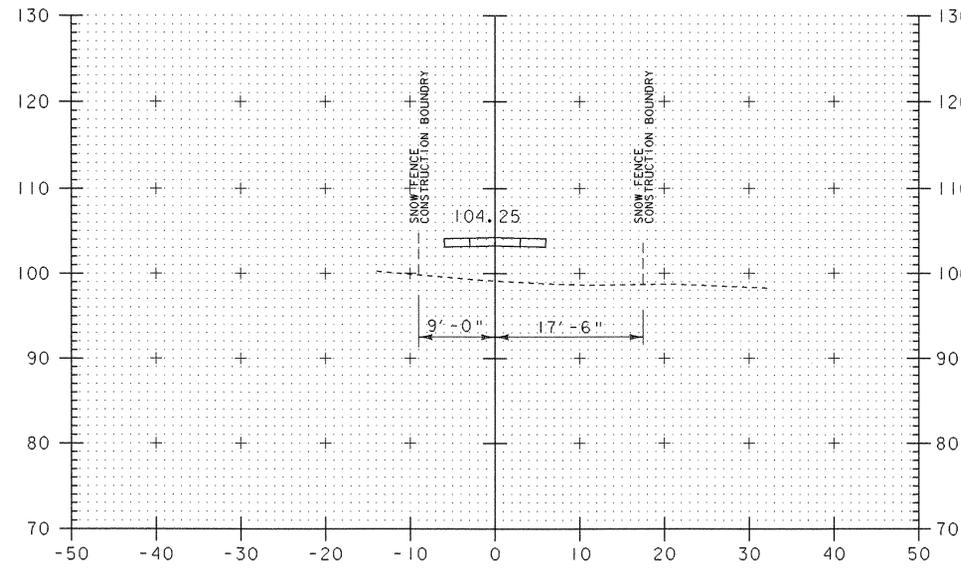


25+00

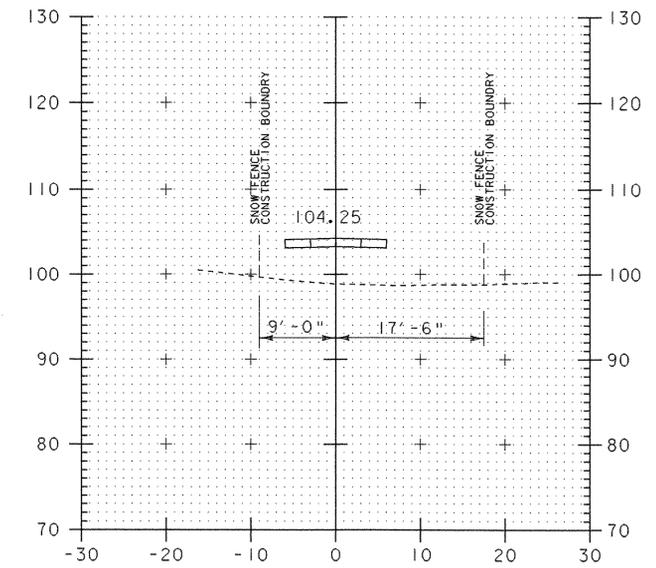


25+50

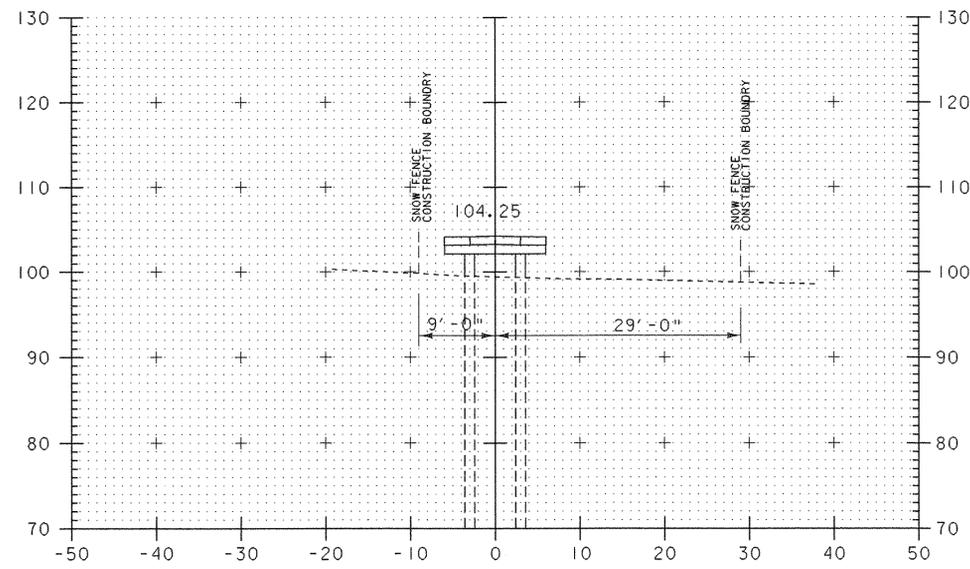

24+25

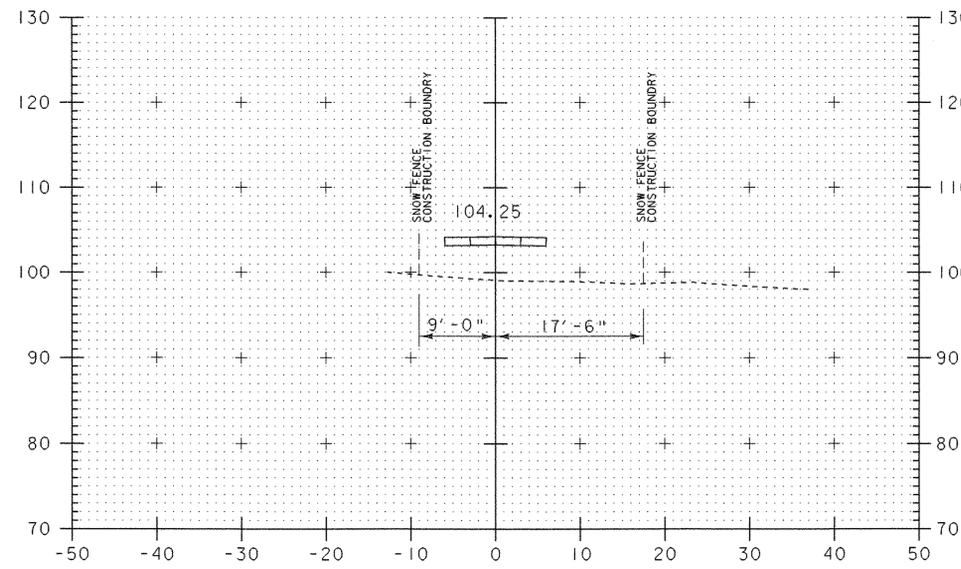

24+75

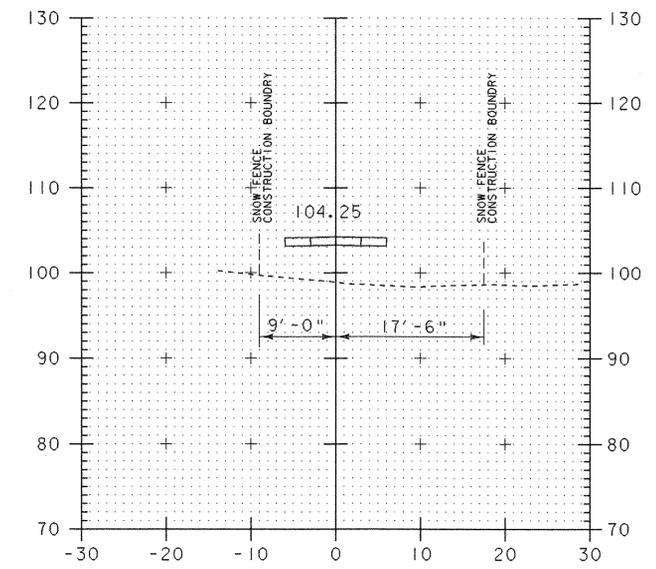

25+25

## CROSS SECTIONS 24+25 - 25+50

PROJECT NAME:	Colchester	FILE NAME:	str5/03f038/sf038xsl.dgn	PLOT DATE:	05-AUG-2003
PROJECT NUMBER:	STP Bike(48)	PROJECT LEADER:	C. Keller	DRAWN BY:	G. Shangraw
		DESIGNED BY:	G. Shangraw	CHECKED BY:	
				SHEET	83 OF 87