




26+00

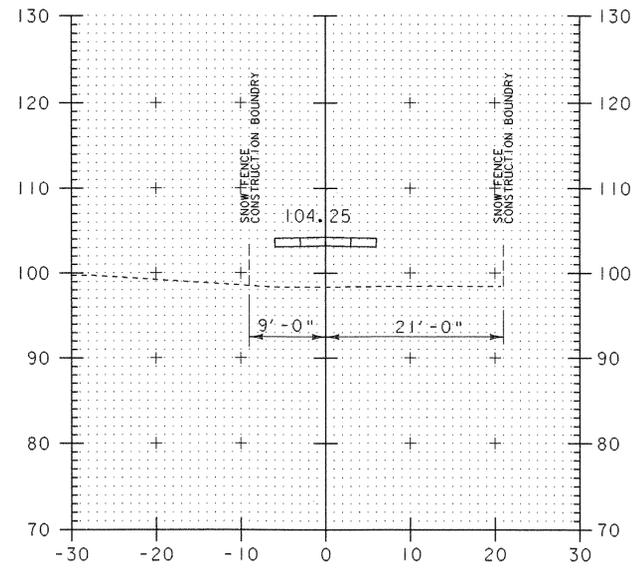

26+50

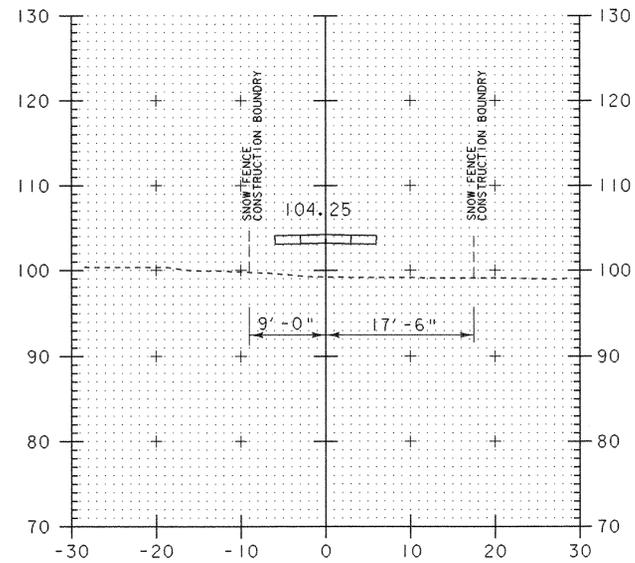

25+75

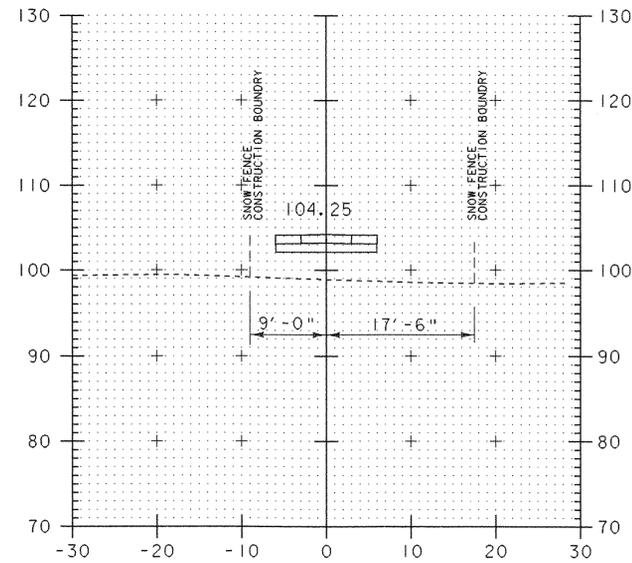

26+25

CROSS SECTIONS 25+75 - 26+50

PROJECT NAME: Colchester
PROJECT NUMBER: STP Bike(48)

FILE NAME: str5/03f038/sf038xsl.dgn PLOT DATE: 05-AUG-2003
PROJECT LEADER: C. Keller DRAWN BY: G. Shangraw
DESIGNED BY: G. Shangraw CHECKED BY:
sf038xsl5.l SHEET 84 OF 87