




26+80 Sta. 26+70 BEGIN COMMON EXCAVATION  
BEGIN STONE FILL TYPE I

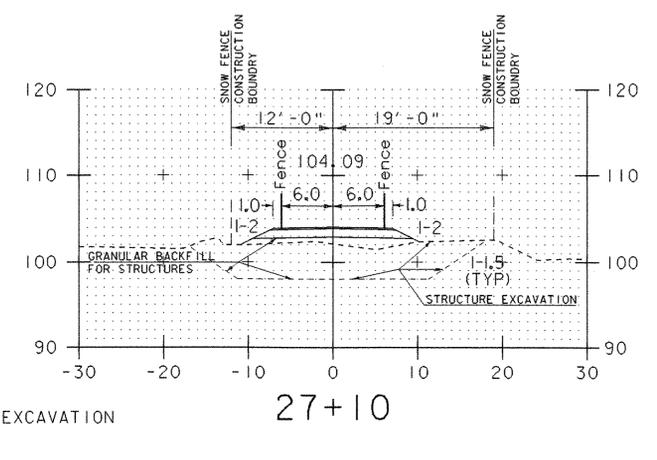


27+10  
Sta. 27+05 END STONE FILL TYPE I  
End Elevated Concrete Path

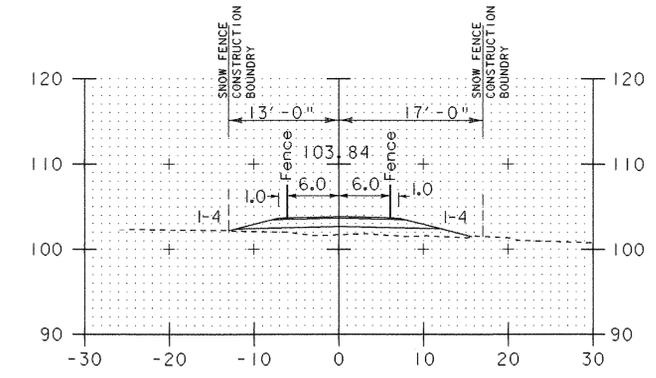


27+40  
End Fence Lt. & Rt.  
Begin Path Width Taper

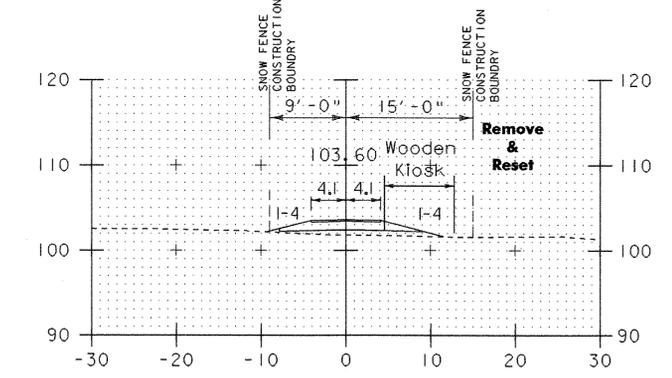


27+70

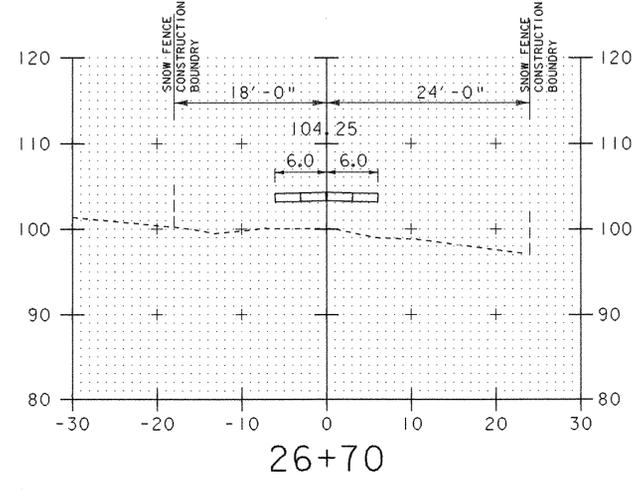


26+70

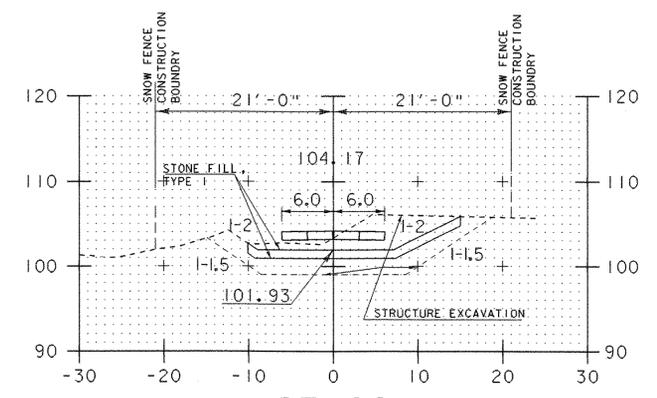


27+00 Sta. 27+00 END COMMON EXCAVATION

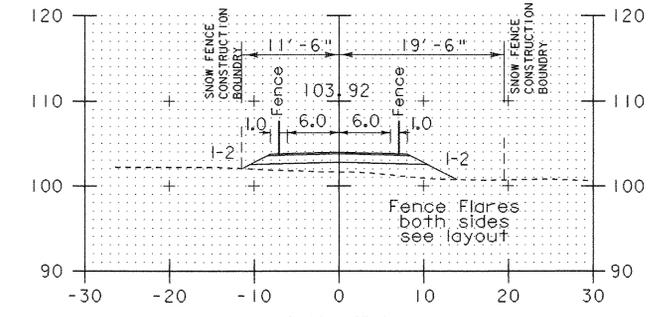


27+30

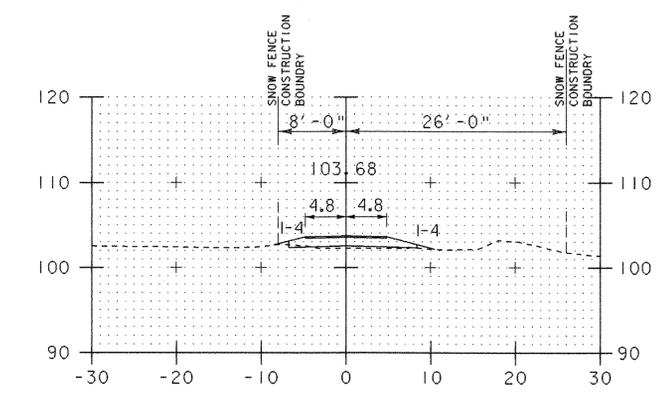


27+60

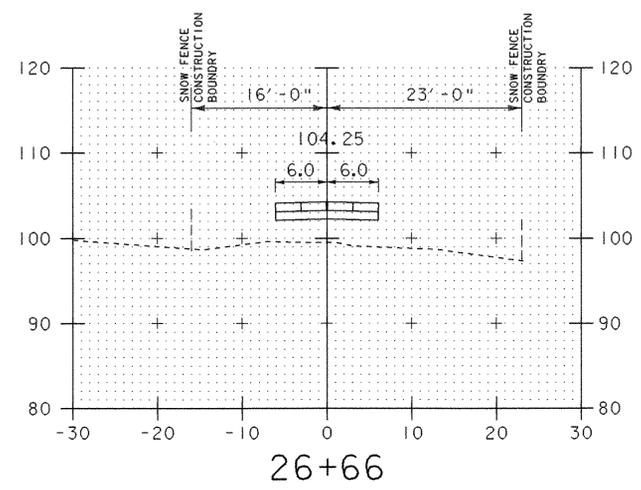


26+66

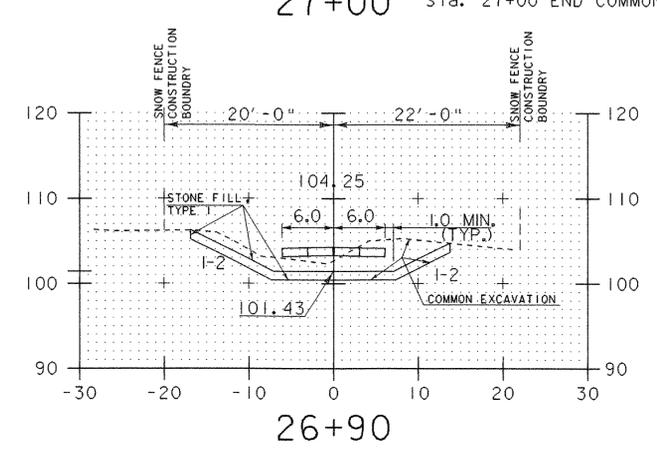

26+90

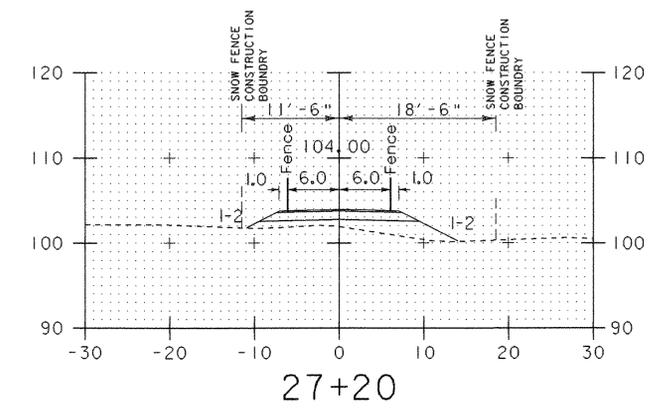

27+20

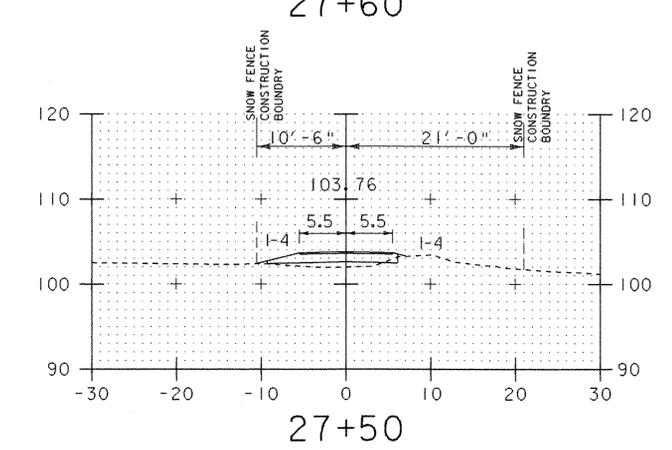

27+50

## CROSS SECTIONS 26+66 - 27+70

PROJECT NAME:	Colchester
PROJECT NUMBER:	STP Bike(48)
FILE NAME:\str5\03f038\sf038xsl.dgn	PLOT DATE: 05-AUG-2003
PROJECT LEADER: C. Keller	DRAWN BY: G. Shangraw
DESIGNED BY: G. Shangraw	CHECKED BY:
sf038xsl6.i	SHEET 85 OF 87