



28+62.00
End Project

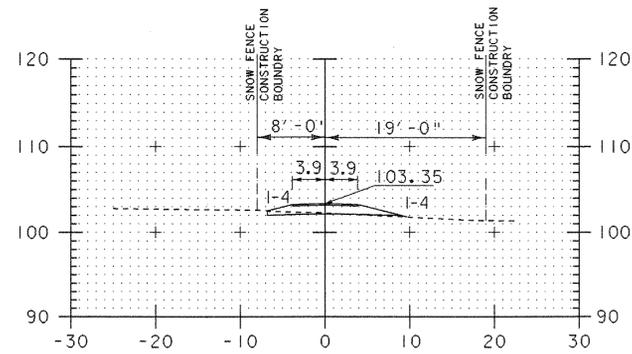


28+00

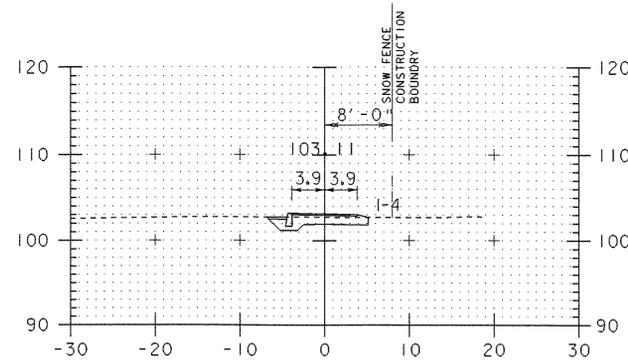


28+30


28+25 Begin Curbed Typical
28+25 to 28+30 Construct Ramp

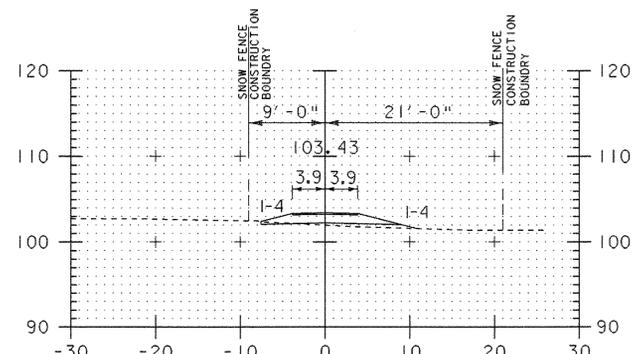

27+90

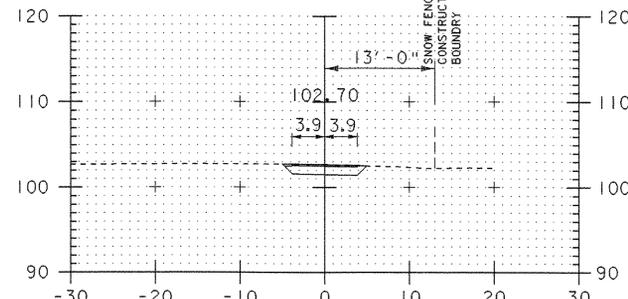


28+20

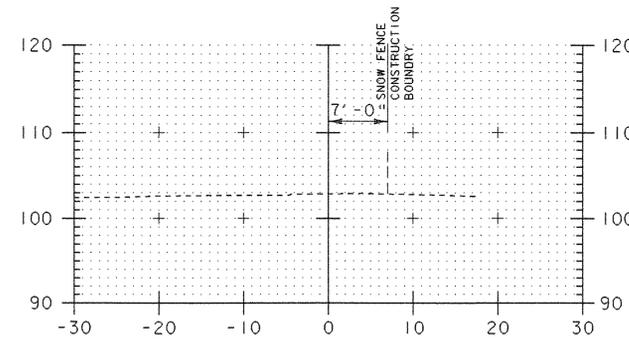


28+60

Match Existing Path

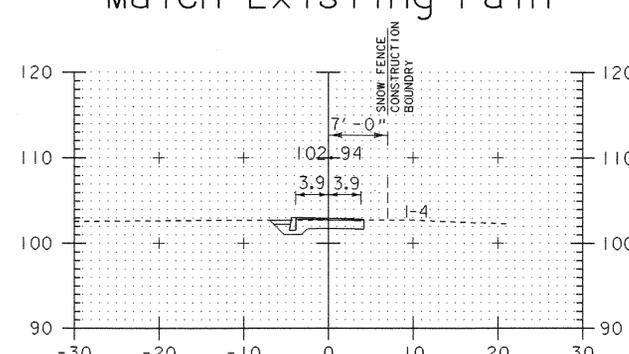


28+50

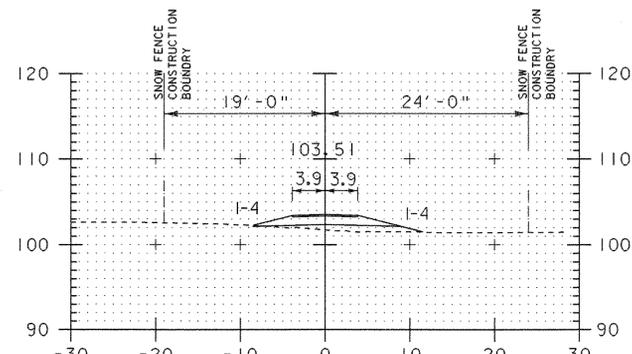


27+80

End Path Width Taper

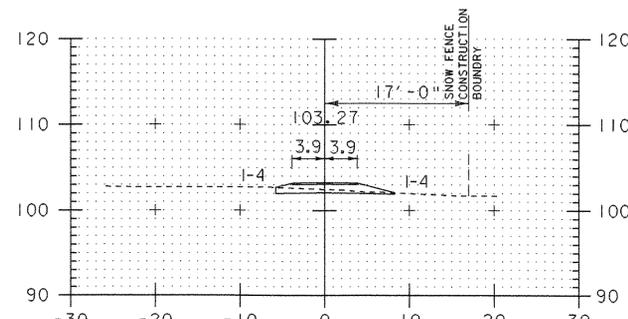

28+10

28+10 to 28+15
Construct Ramp

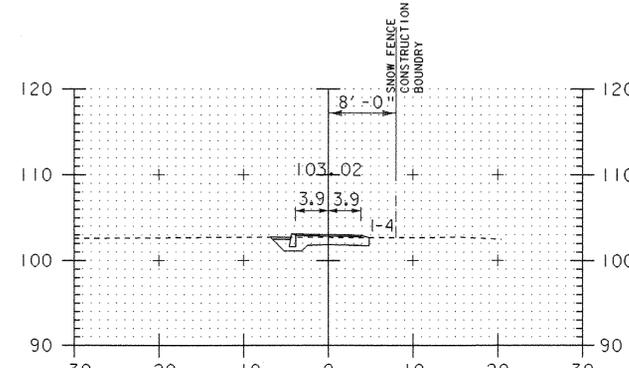

28+40

CROSS SECTIONS 27+80 - 28+60

PROJECT NAME:	Colchester	FILE NAME:	str5/03f038/sf038xsl.dgn	PLOT DATE:	05-AUG-2003
PROJECT NUMBER:	STP Bike(48)	PROJECT LEADER:	C. Keller	DRAWN BY:	
		DESIGNED BY:	G. Shangraw	CHECKED BY:	
				SHEET	86 OF 87