


1 PARTIAL P/S PILE CAP PLAN
 F3 1/8" = 1'-0"

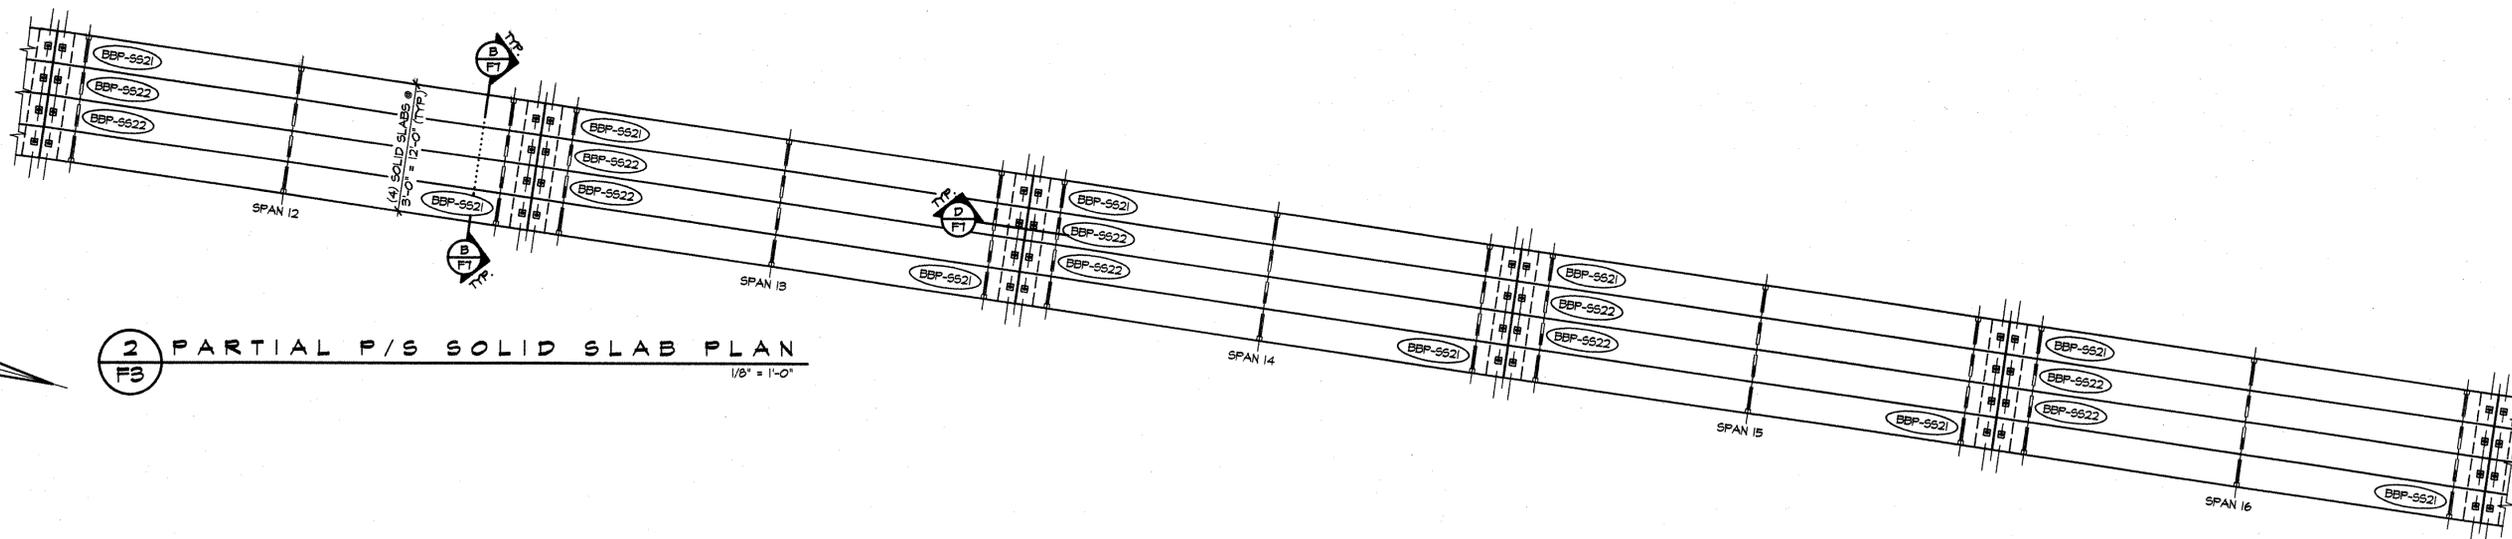

2 PARTIAL P/S SOLID SLAB PLAN
 F3 1/8" = 1'-0"

J.P. CARRARA & SONS, INC.

NOV 12 2003

ISSUED FOR PRODUCTION

APPROVAL STAMP: RECEIVED CKD BY <i>WJL</i> OK'D BY _____ NOV 14 2003 RESUBMIT _____ APPROVED _____ BY _____ DATE 12/3/03	J.P. CARRARA & SONS INC. Precast & Prestress Manufacturer <small>2444 CASE STR., MOORESBURY, VERMONT 05753 Phone:(802)388-6361 Fax:(802)388-9010</small>		KUBRICKY CONSTRUCTION CORP. CONTRACTOR <small>GLENS FALLS, NEW YORK</small>	
	STATE OF VERMONT AGENCY OF TRANSPORTATION		DATE: SEPT. 26, 2003 SCALE: NOTED	
	TOWN OF COLCHESTER PROJECT NUMBER: STP BIKE (48)		CHKD: DFTM: B.L. JOB NO: 23169-03	
	P/S PILE CAP & SOLID SLAB LAYOUTS (SPANS 12-16)		DWG. NO: F3 09/	