


1 PARTIAL P/S PILE CAP PLAN  
F5  
1/8" = 1'-0"

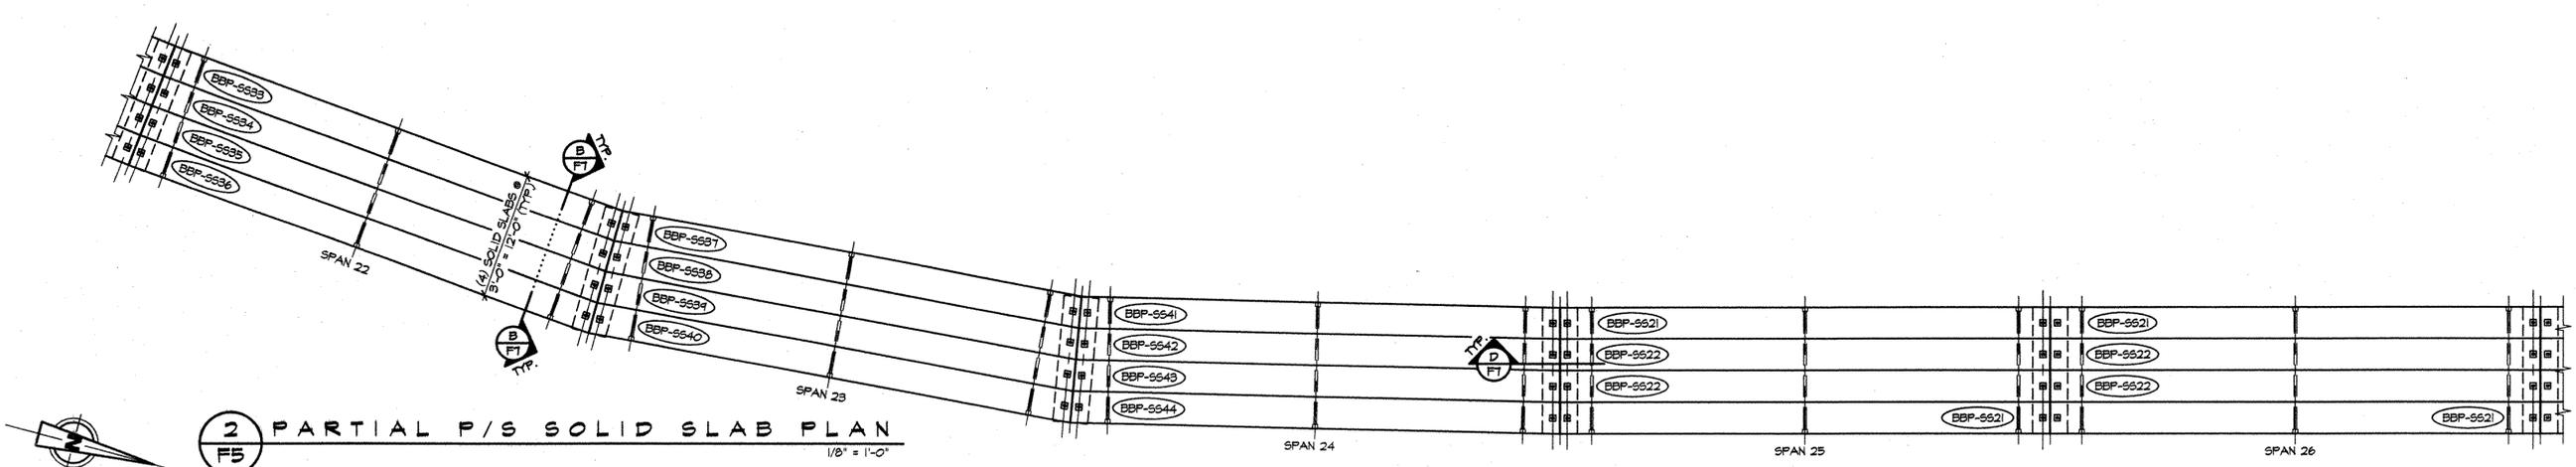

2 PARTIAL P/S SOLID SLAB PLAN  
F5  
1/8" = 1'-0"

J.P. CARRARA & SONS, INC.  
NOV 12 2003  
ISSUED FOR PRODUCTION

APPROVAL STAMP:  RECEIVED OK'D BY <i>MGM</i> OK'D BY _____ NOV 14 2003 RESUBMIT _____ APPROVED _____ BY _____ DATE 12/3/03	<b>J.P. CARRARA &amp; SONS INC.</b> Precast & Prestress Manufacturer <small>2484 CASE ST., WOODBURY, VERMONT 05793 Phone:(802)388-8361 Fax:(802)388-9010</small>		<b>KUBRICKY CONSTRUCTION CORP.</b> CONTRACTOR GLENS FALLS, NEW YORK	
	STATE OF VERMONT AGENCY OF TRANSPORTATION		DATE: SEPT. 26, 2003 SCALE: NOTED	
	TOWN OF COLCHESTER PROJECT NUMBER: STP BIKE (48)		CHKD: _____ DFTM: B.L. JOB NO: 23169-03	
	<b>P/S FILE CAP &amp; SOLID SLAB LAYOUTS</b> (SPANS 22-26)		DWG. NO: <b>F5</b> 093	