




DIMENSIONAL PLAN VIEW IN FORM
3/4" = 1'-0"

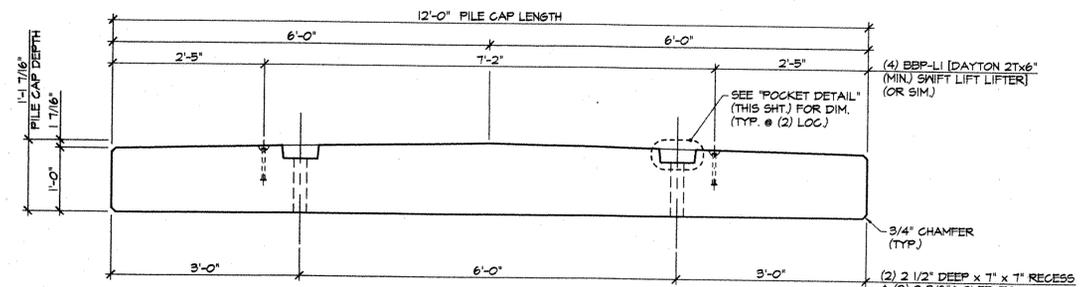


DIMENSIONAL ELEVATION
3/4" = 1'-0"

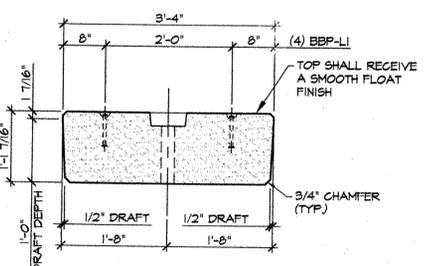


DIMENSIONAL SECTION
3/4" = 1'-0"

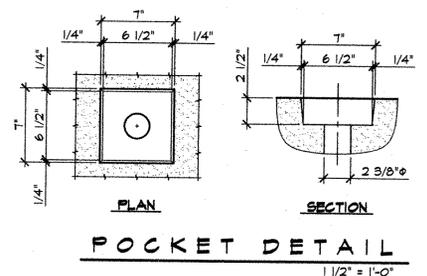


POCKET DETAIL
1 1/2" = 1'-0"

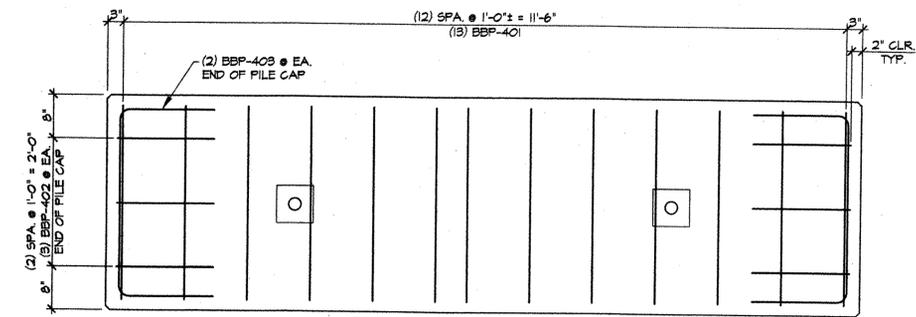

REINFORCING PLAN VIEW IN FORM
3/4" = 1'-0"

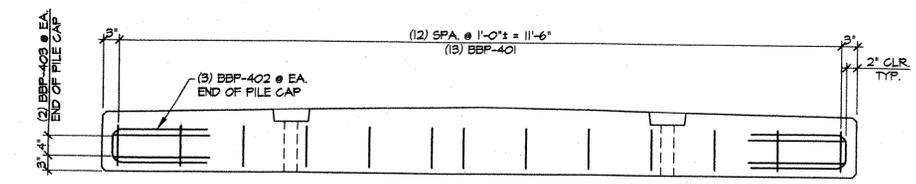

REINFORCING ELEVATION
3/4" = 1'-0"

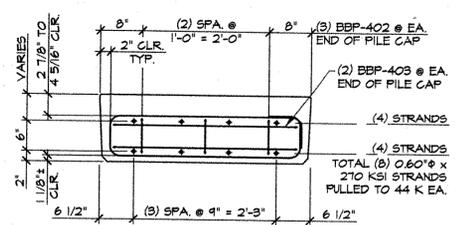


REINFORCING SECTION
3/4" = 1'-0"

J.P. CARRARA & SONS, INC.
NOV 12 2003
ISSUED FOR PRODUCTION

APPROVED BY VAOT 10-2-03

APPROVAL STAMP:
RECEIVED
NOV 14 2003
RESUBMIT APPROVED
BY DATE 12/3/03

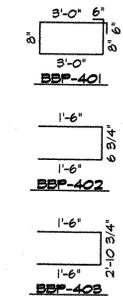

MATERIAL LIST / PILE CAP			
ITEM	MARK	DESCRIPTION	QTY.
1	401	#4 BENT BAR	13
2	402	#4 BENT BAR	6
3	403	#4 BENT BAR	4
4			
5			
6			
7			
8			
9	BBP-LI	DAYTON 2T x 6" (MIN) SWIFT LIFT LIFTER (OR SIM)	4
10			

J.P. CARRARA & SONS INC. KUBRICKY CONSTRUCTION CORP.
Precast & Prestress Manufacturer CONTRACTOR
2444 CASE STR., WOODLURY, VERMONT 05753 Phone:(802)388-6361 Fax:(802)388-9010 GLENS FALLS, NEW YORK

STATE OF VERMONT AGENCY OF TRANSPORTATION
TOWN OF COLCHESTER
PROJECT NUMBER: STP BIKE (48)

P/S PILE CAP DETAILS

DATE: SEPT. 26, 2003
SCALE: NOTED
CHKD: DFTM: B.L.
JOB NO: 23164-03
DWG. NO: PCI
099