




DIMENSIONAL PLAN VIEW IN FORM
1/4" = 1'-0"

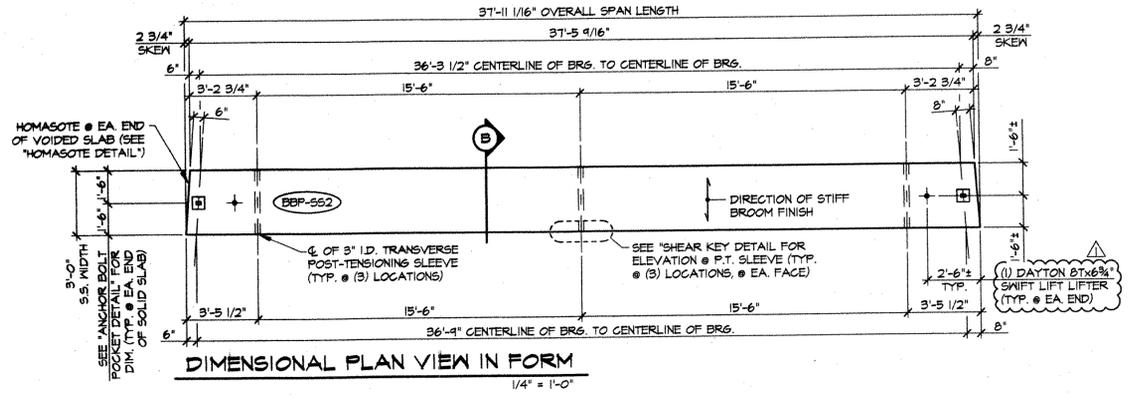


DIMENSIONAL PLAN VIEW IN FORM
1/4" = 1'-0"

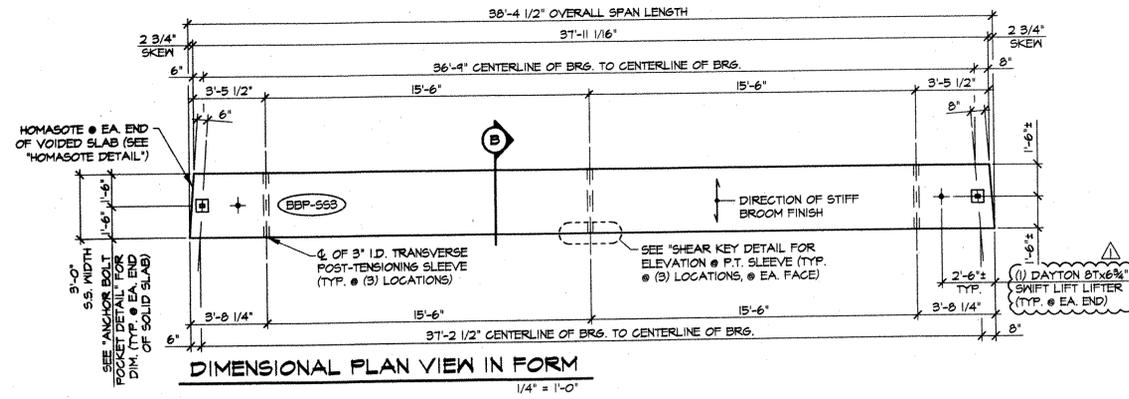


DIMENSIONAL PLAN VIEW IN FORM
1/4" = 1'-0"

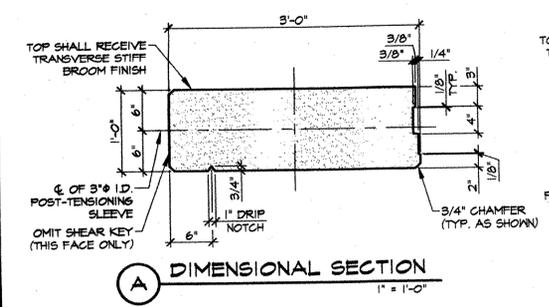


A DIMENSIONAL SECTION
1" = 1'-0"

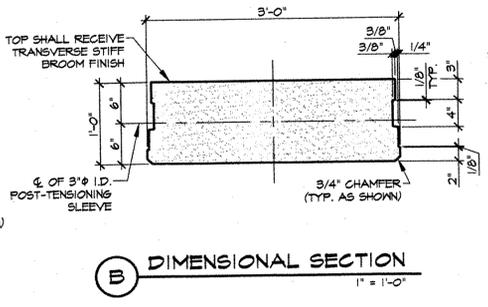


B DIMENSIONAL SECTION
1" = 1'-0"

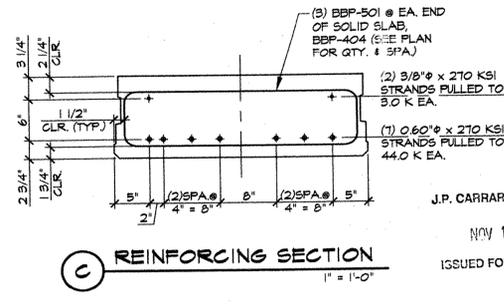


C REINFORCING SECTION
1" = 1'-0"

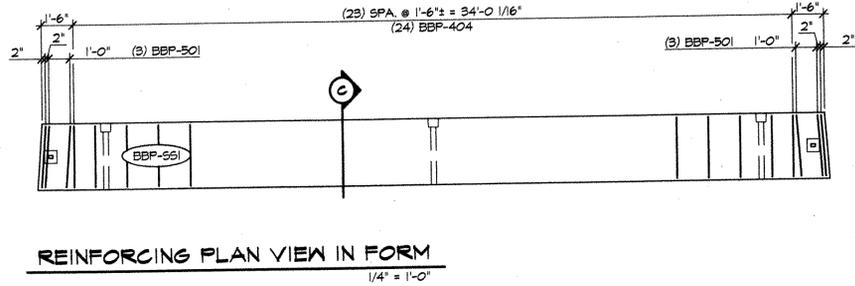


REINFORCING PLAN VIEW IN FORM
1/4" = 1'-0"

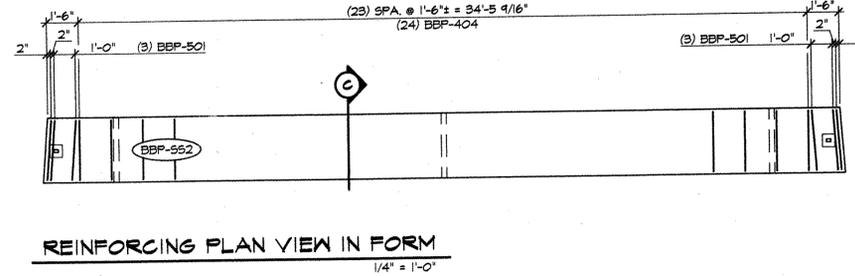


REINFORCING PLAN VIEW IN FORM
1/4" = 1'-0"

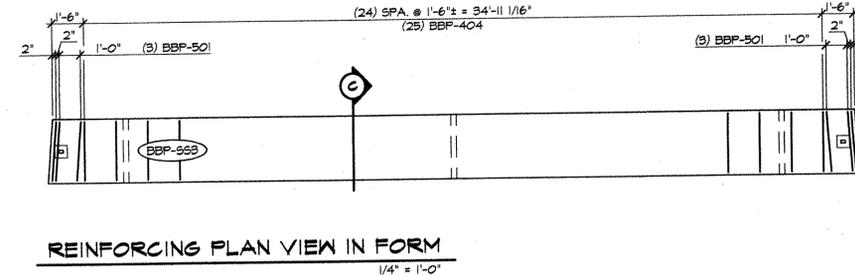


REINFORCING PLAN VIEW IN FORM
1/4" = 1'-0"

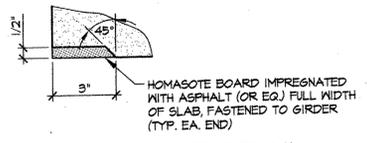


HOMASOTE DETAIL
3" = 1'-0"

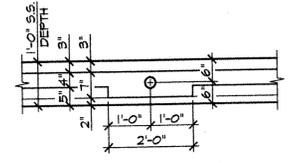

SHEAR KEY DETAIL
1/2" = 1'-0"

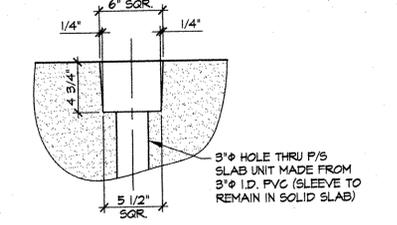


POST-TENSIONING POCKET DETAIL
1 1/2" = 1'-0"

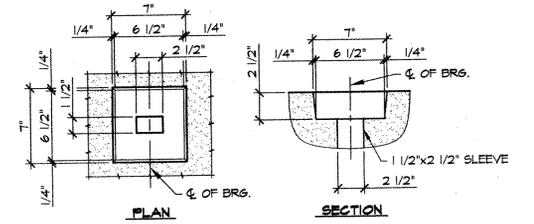

ANCHOR BOLT POCKET DETAIL
1 1/2" = 1'-0"

DETENSIONING SCHEDULE
N.T.S.

1	2
3	4
5	6
7	8
9	4

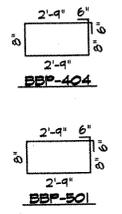

MARK: BBP-551	QTY.: 1	WT.: 0.23 T	VOL.: 4.07 cy
MARK: BBP-552	QTY.: 1	WT.: 0.21 T	VOL.: 4.06 cy
MARK: BBP-553	QTY.: 1	WT.: 0.31 T	VOL.: 4.10 cy

MATERIAL LIST / SOLID SLAB

ITEM	MARK	DESCRIPTION	QTY./SLAB		
			551	552	553
1	404	#4 BENT BAR	24	24	25
2					
3	501	#5 BENT BAR	6	6	6
4					
5					
6					
7					
8					
9		DAYTON 8T x 6 3/4" SWIFT LIFT LIFTER	2	2	2
10					

APPROVAL STAMP:

RECEIVED
NOV 14 2003

DATE 12/3/03

J.P. CARRARA & SONS INC.
Precast & Prestress Manufacturer
2464 CASE ST., MIDDLEBURY, VERMONT 05753 Phone: (802)388-6361 Fax: (802)388-9010

KUBRICKY CONSTRUCTION CORP.
CONTRACTOR
GLENS FALLS, NEW YORK

STATE OF VERMONT
AGENCY OF TRANSPORTATION

TOWN OF COLCHESTER
PROJECT NUMBER: STP BIKE (48)

P/S SOLID SLAB DETAILS

DATE: SEPT. 26, 2003
SCALE: NOTED
CHKD: DFTM: B.L.
JOB NO: 23169-03
DWG. NO: **SS1**
100