



DIMENSIONAL PLAN VIEW IN FORM

1/4" = 1'-0"

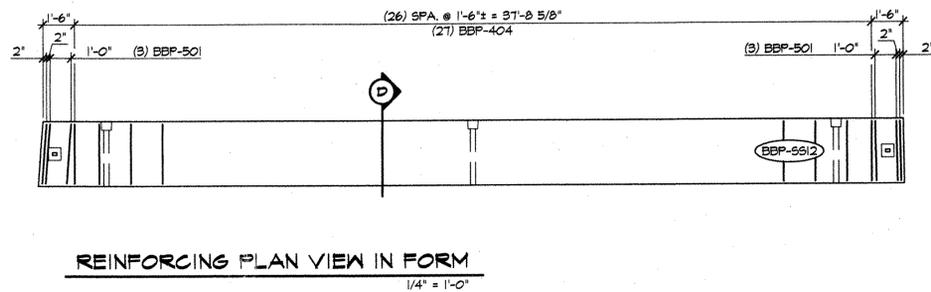


REINFORCING PLAN VIEW IN FORM

1/4" = 1'-0"

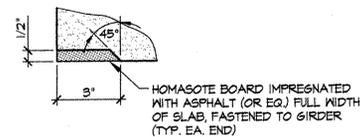


HOMASOTE DETAIL

3" = 1'-0"

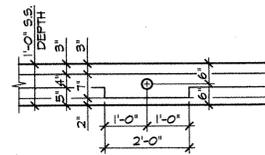


SHEAR KEY DETAIL

1/2" = 1'-0"

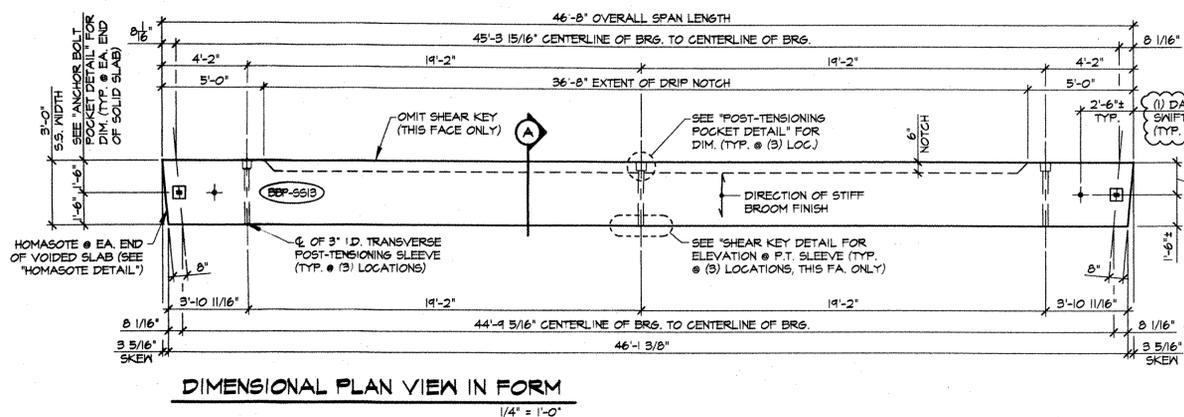


DIMENSIONAL PLAN VIEW IN FORM

1/4" = 1'-0"

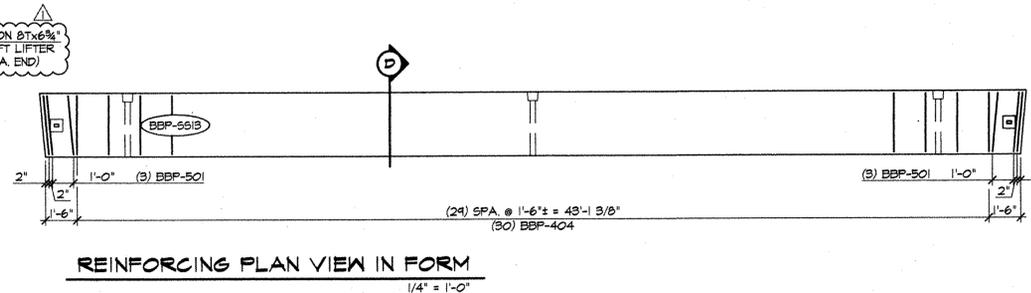


REINFORCING PLAN VIEW IN FORM

1/4" = 1'-0"

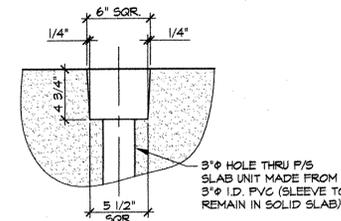


POST-TENSIONING POCKET DETAIL

1 1/2" = 1'-0"

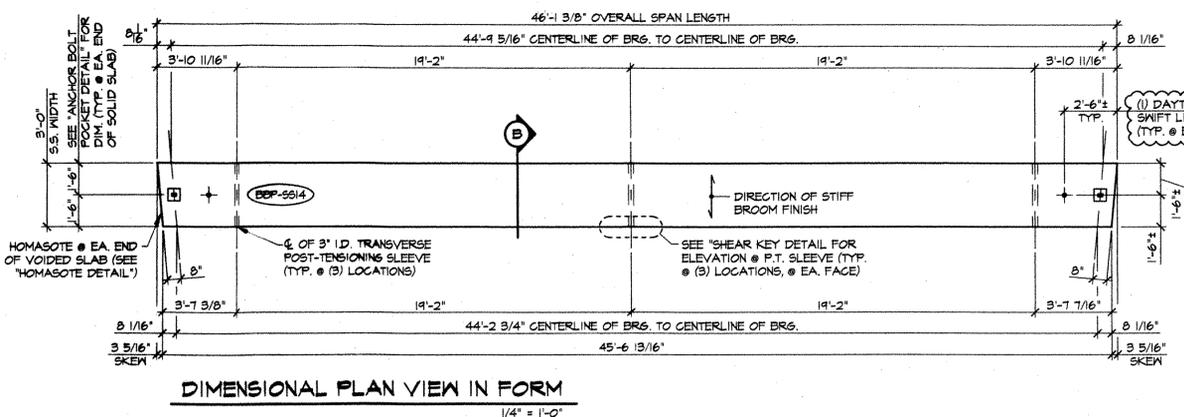


DIMENSIONAL PLAN VIEW IN FORM

1/4" = 1'-0"

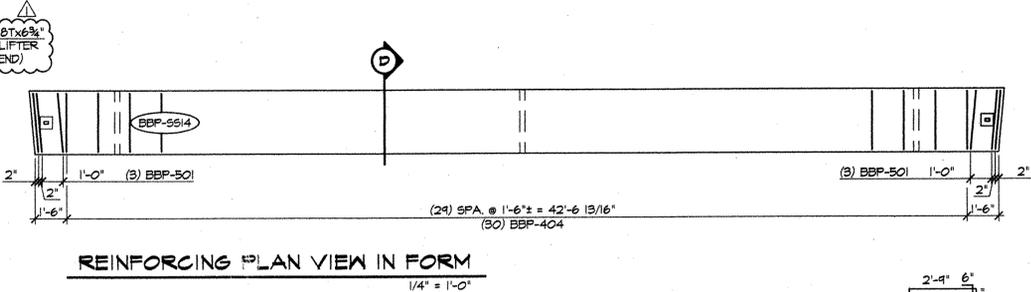


REINFORCING PLAN VIEW IN FORM

1/4" = 1'-0"

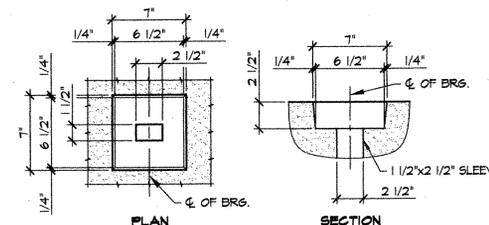


ANCHOR BOLT POCKET DETAIL

1 1/2" = 1'-0"

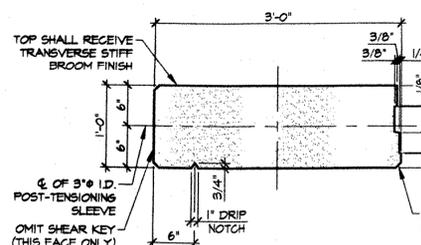


A DIMENSIONAL SECTION

1" = 1'-0"

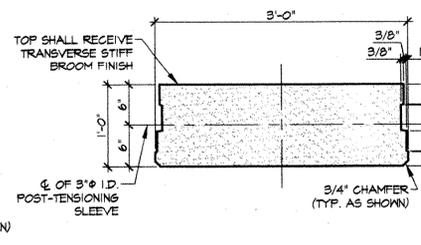


B DIMENSIONAL SECTION

1" = 1'-0"

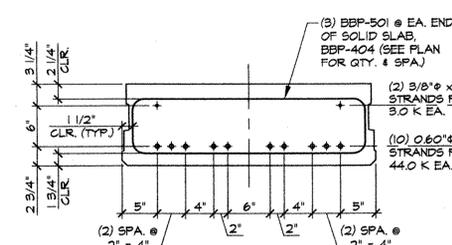


D REINFORCING SECTION

1" = 1'-0"

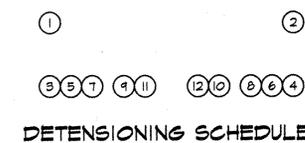

DETENSIONING SCHEDULE

N.T.S.

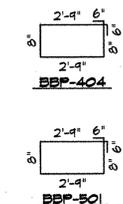

MATERIAL LIST / SOLID SLAB			
ITEM	MARK	DESCRIPTION	QTY./SLAB
1	404	#4 BENT BAR	27 30 30
2	501	#5 BENT BAR	6 6 6
3			
4	△	DAYTON 8T x 6 3/4" SWIFT LIFT LIFTER	2 2 2
5			

APPROVAL STAMP:

RECEIVED

NOV 14 2003

DATE 12/3/03

J.P. CARRARA & SONS INC. KUBRICKY CONSTRUCTION CORP.

STATE OF VERMONT AGENCY OF TRANSPORTATION

TOWN OF COLCHESTER PROJECT NUMBER: STP BIKE (48)

P/S SOLID SLAB DETAILS

DATE: SEPT. 26, 2003

SCALE: NOTED

CHKD: DFTM: B.L.

JOB NO: 23169-03

DWG. NO: S55