




DIMENSIONAL PLAN VIEW IN FORM
1/4" = 1'-0"

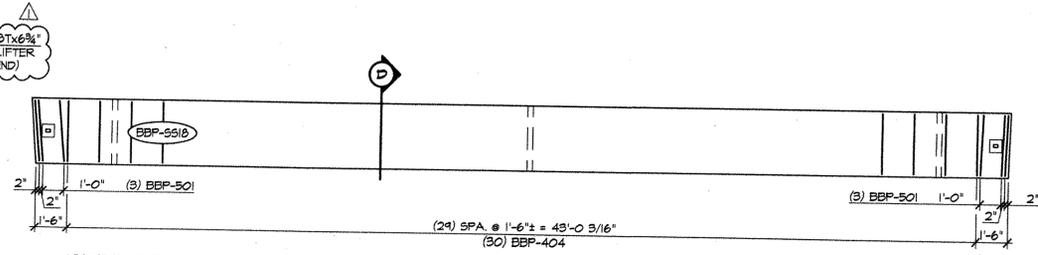


REINFORCING PLAN VIEW IN FORM
1/4" = 1'-0"

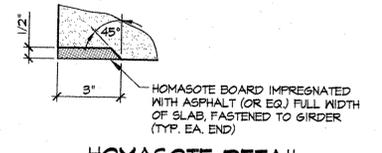


HOMASOTE DETAIL
3" = 1'-0"

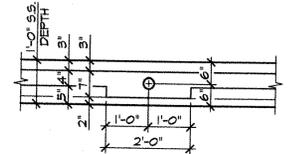


SHEAR KEY DETAIL
1/2" = 1'-0"

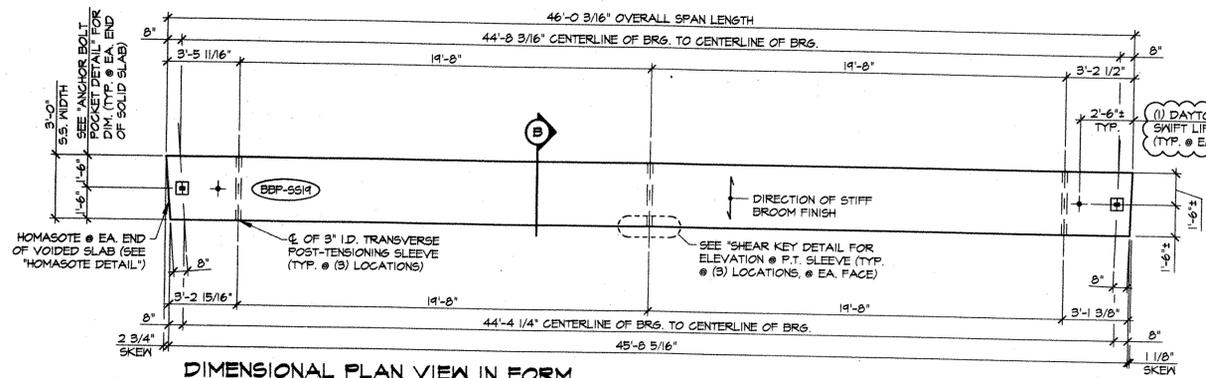


DIMENSIONAL PLAN VIEW IN FORM
1/4" = 1'-0"

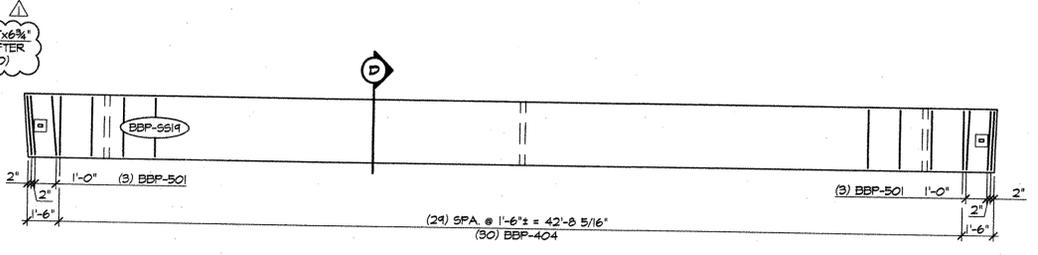


REINFORCING PLAN VIEW IN FORM
1/4" = 1'-0"

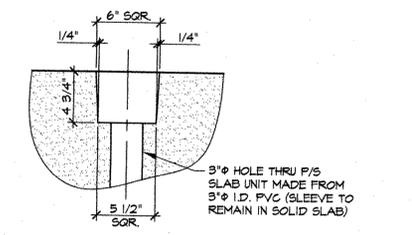


POST-TENSIONING POCKET DETAIL
1/2" = 1'-0"

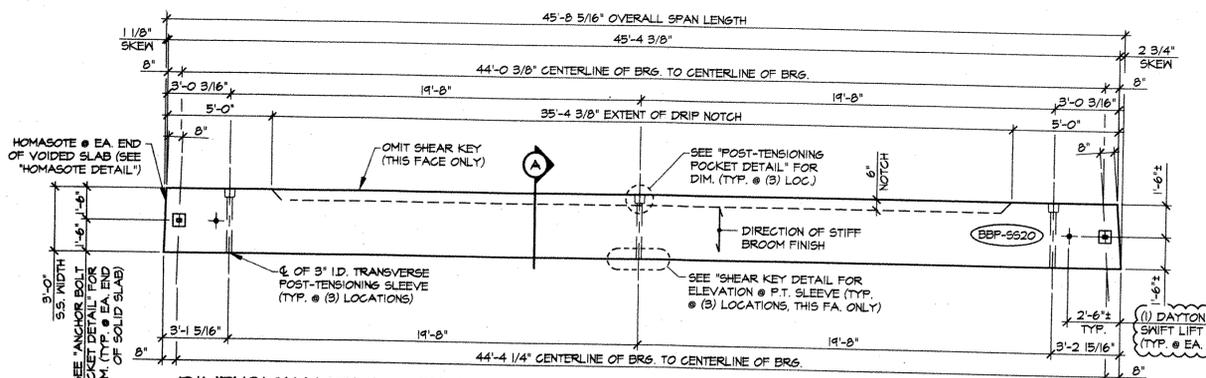


DIMENSIONAL PLAN VIEW IN FORM
1/4" = 1'-0"

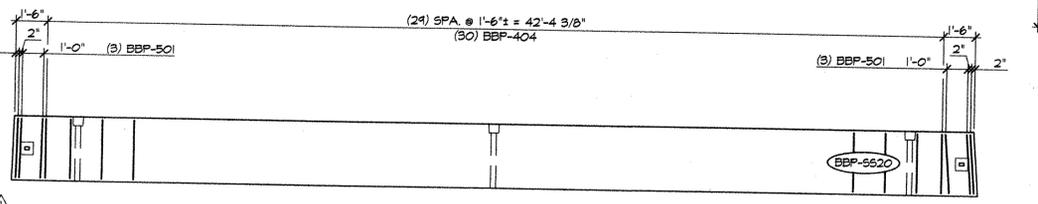


REINFORCING PLAN VIEW IN FORM
1/4" = 1'-0"

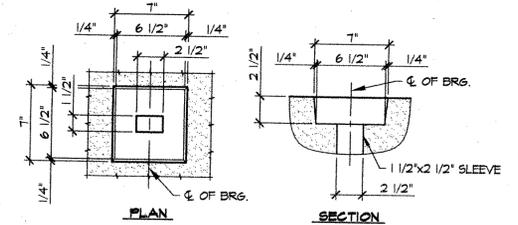


ANCHOR BOLT POCKET DETAIL
1/2" = 1'-0"

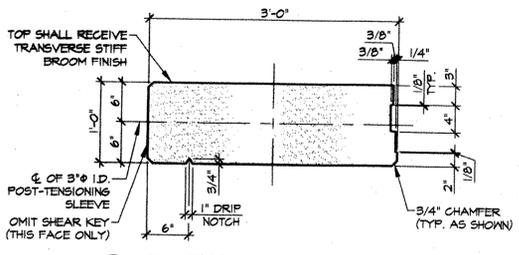

A DIMENSIONAL SECTION
1" = 1'-0"

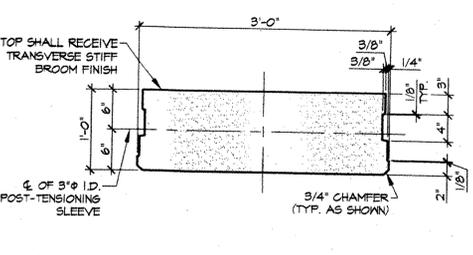

B DIMENSIONAL SECTION
1" = 1'-0"

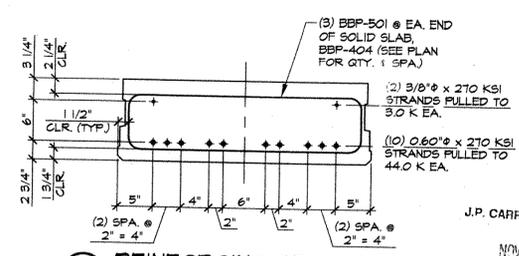


D REINFORCING SECTION
1" = 1'-0"

① ②

③ ④ ⑤ ⑥ ⑦ ⑧ ⑨ ⑩ ⑪ ⑫ ⑬ ⑭ ⑮ ⑯ ⑰ ⑱ ⑲ ⑳

DETENSIONING SCHEDULE
N.T.S.

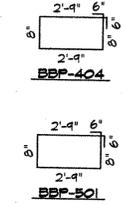

MARK: BBP-SS18	QTY.: 1	WT.: 10.06 T	VOL.: 4.97 cy	(Pci = 4000 PSI) (fc = 6000 PSI)	
MARK: BBP-SS19	QTY.: 1	WT.: 9.99 T	VOL.: 4.93 cy		
MARK: BBP-SS20	QTY.: 1	WT.: 10.07 T	VOL.: 4.97 cy		
MATERIAL LIST / SOLID SLAB					
ITEM	MARK	DESCRIPTION	QTY./SLAB		
			SS18	SS19	SS20
1	404	#4 BENT BAR	30	30	30
2	501	#5 BENT BAR	6	6	6
3					
4	△	DAYTON 8T x 6 3/4" SWIFT LIFT LIFTER	2	2	2
5					

APPROVAL STAMP:

RECEIVED
NOV 14 2003

RESUBMIT APPROVED
DATE 12/3/03

J.P. CARRARA & SONS INC.
Precast & Prestress Manufacturer
2844 CASE STR., MIDDLEBURY, VERMONT 05751 Phone: (802)358-6361 Fax: (802)358-9910

KUBRICKY CONSTRUCTION CORP.
CONTRACTOR
GLENS FALLS, NEW YORK

STATE OF VERMONT
AGENCY OF TRANSPORTATION

TOWN OF COLCHESTER
PROJECT NUMBER: STP BIKE (48)

F/S SOLID SLAB DETAILS

DATE: SEPT. 26, 2003
SCALE: NOTED
CHKD: DFTM: B.L.
JOB NO: 23169-03
DWG. NO: **SS7**
106