




HOMASOTE DETAIL
3" = 1'-0"

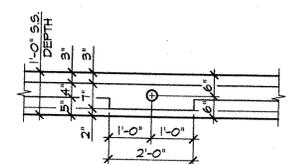


SHEAR KEY DETAIL
1/2" = 1'-0"

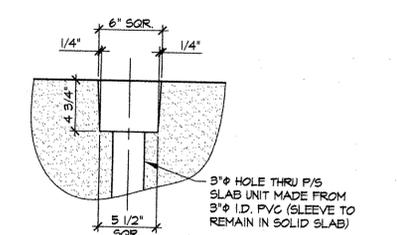


POST-TENSIONING POCKET DETAIL
1/2" = 1'-0"

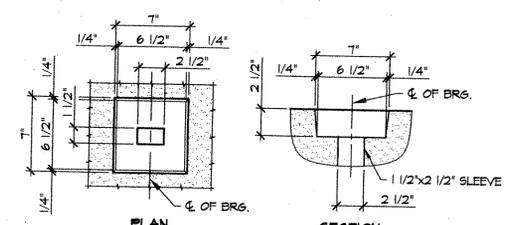


ANCHOR BOLT POCKET DETAIL
1/2" = 1'-0"

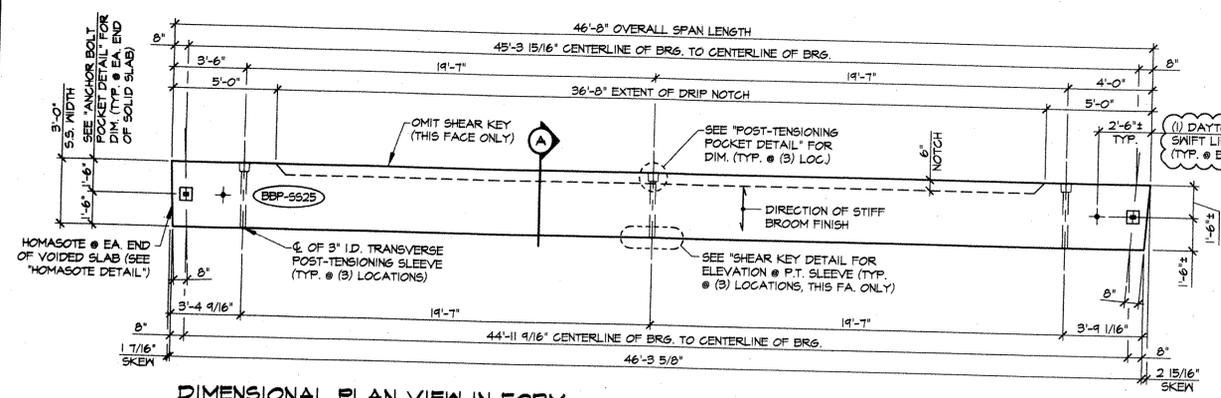


DIMENSIONAL PLAN VIEW IN FORM
1/4" = 1'-0"

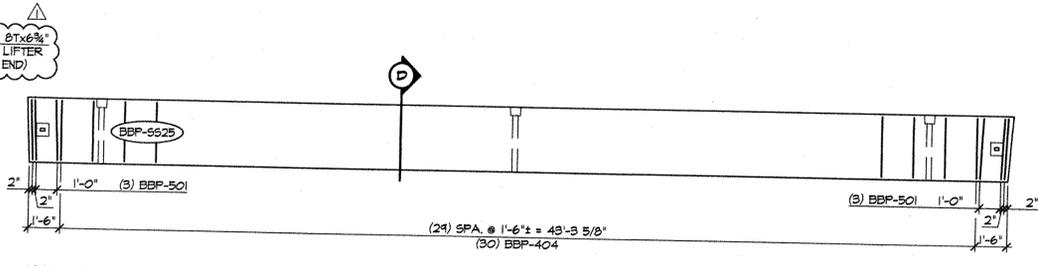


REINFORCING PLAN VIEW IN FORM
1/4" = 1'-0"

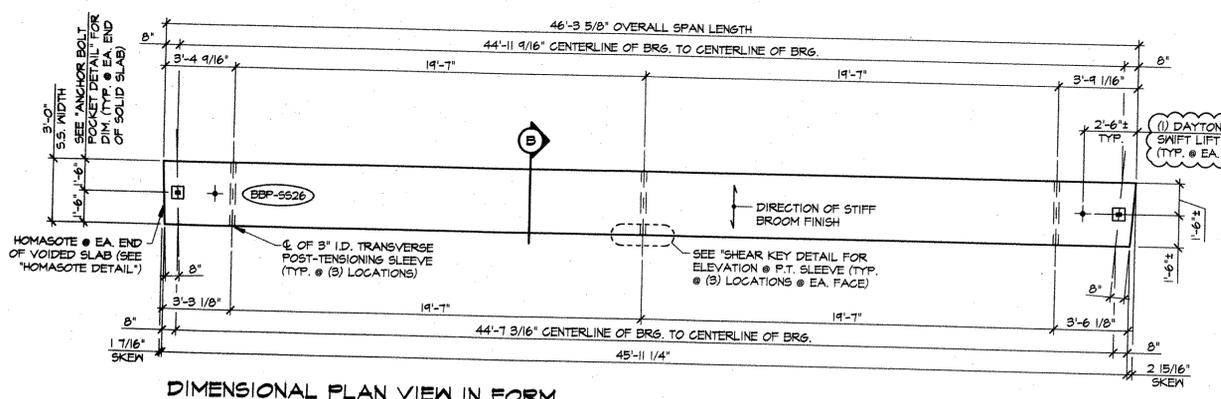


DIMENSIONAL PLAN VIEW IN FORM
1/4" = 1'-0"

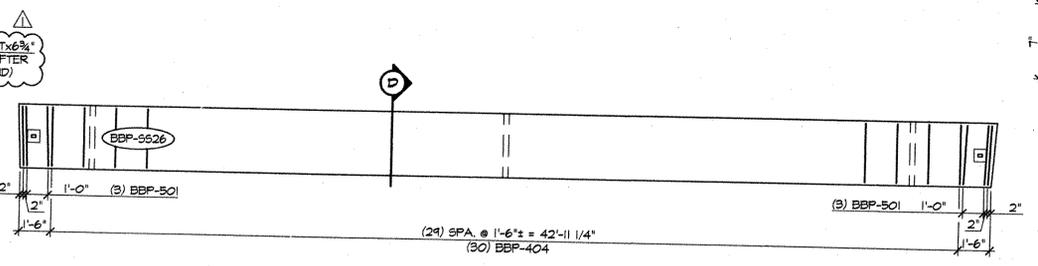


REINFORCING PLAN VIEW IN FORM
1/4" = 1'-0"

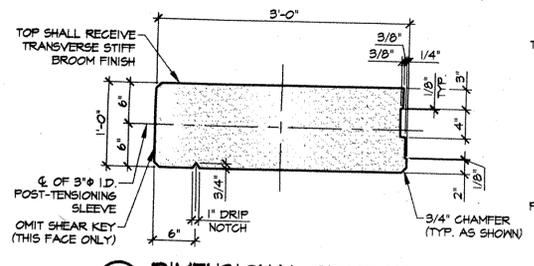

A DIMENSIONAL SECTION
1" = 1'-0"

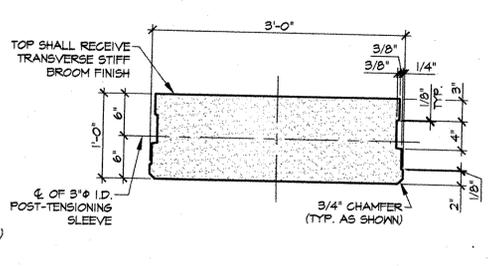

B DIMENSIONAL SECTION
1" = 1'-0"

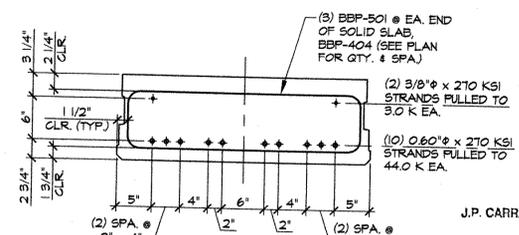


D REINFORCING SECTION
1" = 1'-0"

① ②

③ ④ ⑤ ⑥ ⑦ ⑧ ⑨ ⑩ ⑪ ⑫ ⑬ ⑭ ⑮ ⑯ ⑰ ⑱ ⑲ ⑳

DETENSIONING SCHEDULE
N.T.S.

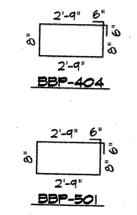

MARK:	QTY.:	WT.:	VOL.:	
MARK: BBP-5525	QTY.: 1	WT.: 10.20 T	VOL.: 5.08 cy	(Pci = 4000 PSI) (f'c = 6000 PSI)
MARK: BBP-5526	QTY.: 1	WT.: 10.21 T	VOL.: 5.04 cy	
MATERIAL LIST / SOLID SLAB				
ITEM	MARK	DESCRIPTION	QTY./SLAB	
1	404	#4 BENT BAR	30	30
2	501	#5 BENT BAR	6	6
3				
4	①	DAYTON 8T x 6 3/4" SWIFT LIFT LIFTER	2	2
5				

APPROVAL STAMP:

RECEIVED
NOV 14 2003

RESUBMIT: _____ APPROVED: _____
BY: _____ DATE: 12/3/03

J.P. CARRARA & SONS INC.
Precast & Prestress Manufacturer
2646 CASE STR., MIDDLEBURY, VERMONT 05753 Phone: (802)388-6351 Fax: (802)388-9010

KUBRICKY CONSTRUCTION CORP.
CONTRACTOR
GLENS FALLS, NEW YORK

STATE OF VERMONT
AGENCY OF TRANSPORTATION

TOWN OF COLCHESTER
PROJECT NUMBER: STP BIKE (48)

P/S SOLID SLAB DETAILS

DATE: SEPT. 26, 2003
SCALE: NOTED
CHKD: _____ DFTM: B.L.
JOB NO: 23169-03
DWG. NO: **SS9**
108

J.P. CARRARA & SONS, INC.
NOV 12 2003
ISSUED FOR PRODUCTION