




DIMENSIONAL PLAN VIEW IN FORM
1/4" = 1'-0"

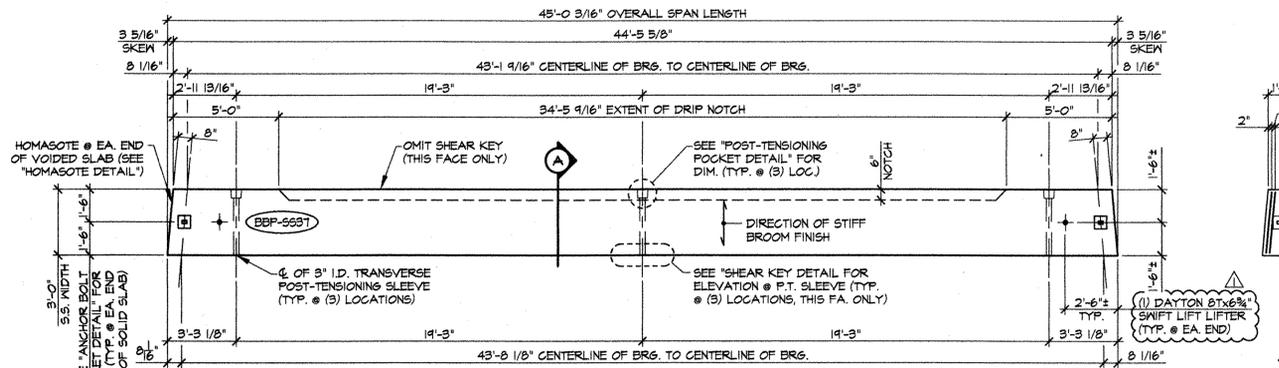


DIMENSIONAL PLAN VIEW IN FORM
1/4" = 1'-0"

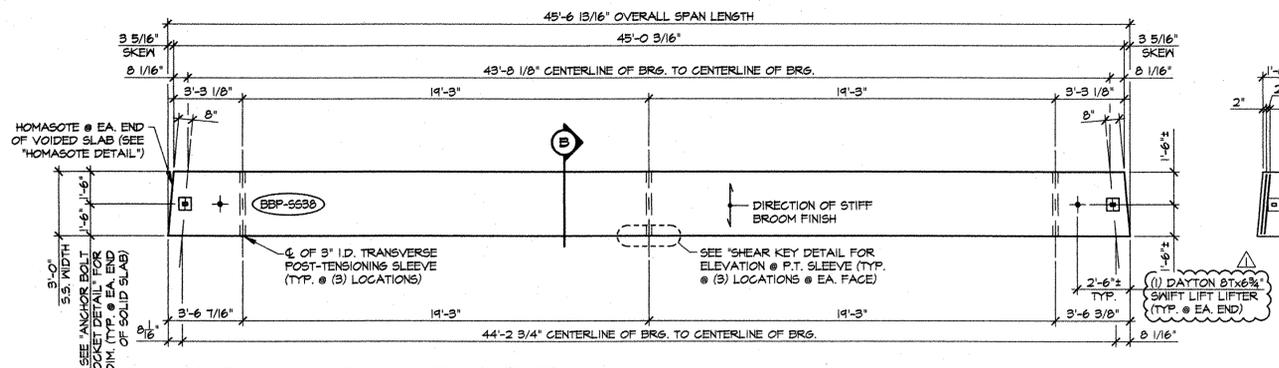


DIMENSIONAL PLAN VIEW IN FORM
1/4" = 1'-0"

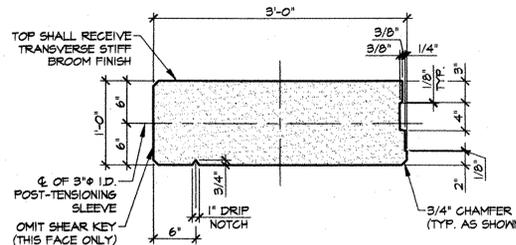


A DIMENSIONAL SECTION
1" = 1'-0"

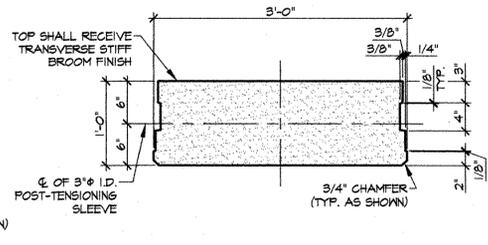


B DIMENSIONAL SECTION
1" = 1'-0"

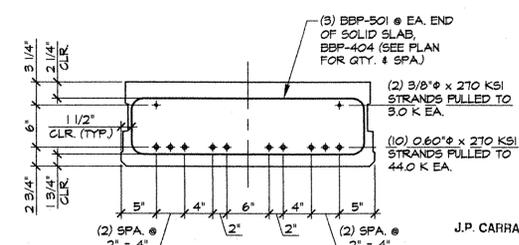


D REINFORCING SECTION
1" = 1'-0"

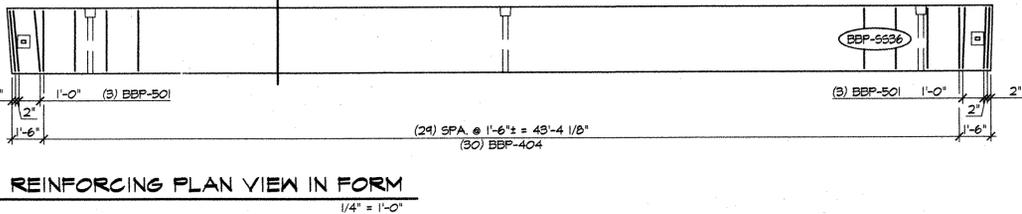


REINFORCING PLAN VIEW IN FORM
1/4" = 1'-0"

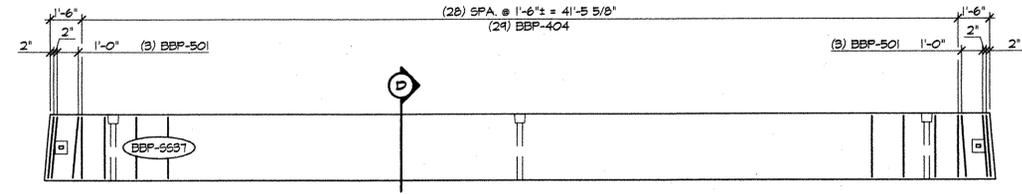


REINFORCING PLAN VIEW IN FORM
1/4" = 1'-0"

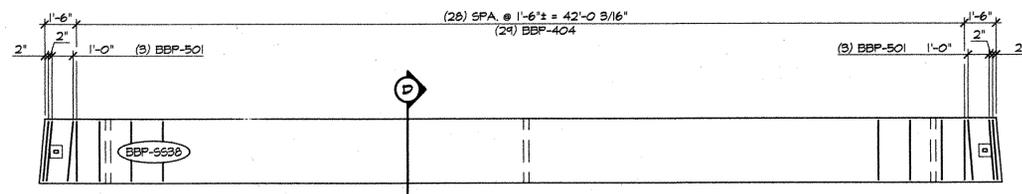


REINFORCING PLAN VIEW IN FORM
1/4" = 1'-0"

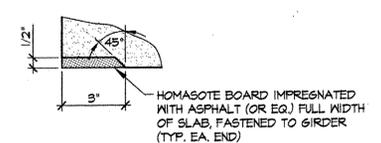


HOMASOTE DETAIL
3" = 1'-0"

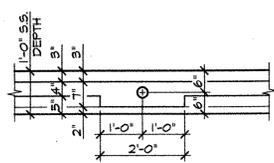

SHEAR KEY DETAIL
1/2" = 1'-0"

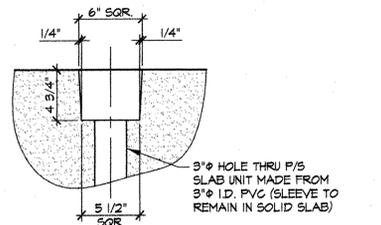

POST-TENSIONING POCKET DETAIL
1 1/2" = 1'-0"

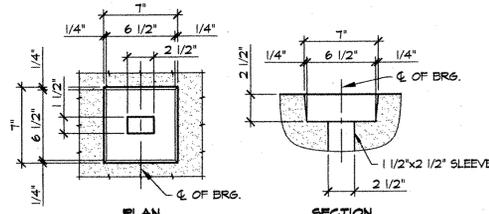


ANCHOR BOLT POCKET DETAIL
1 1/2" = 1'-0"

① ②

③ ④ ⑤ ⑥ ⑦ ⑧ ⑨ ⑩ ⑪ ⑫ ⑬ ⑭ ⑮ ⑯ ⑰ ⑱ ⑲ ⑳ ㉑ ㉒ ㉓ ㉔ ㉕ ㉖ ㉗ ㉘ ㉙ ㉚ ㉛ ㉜ ㉝ ㉞ ㉟ ㊱ ㊲ ㊳ ㊴ ㊵ ㊶ ㊷ ㊸ ㊹ ㊺

DETENSING SCHEDULE
N.T.S.

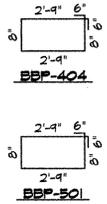

MARK: BBP-5536	QTY.: 1	WT.: 10.28 T	VOL.: 5.08 cy	f _{ci} = 4,000 PSI f _c = 6,000 PSI	
MARK: BBP-5537	QTY.: 1	WT.: 9.90 T	VOL.: 4.89 cy		
MARK: BBP-5538	QTY.: 1	WT.: 9.87 T	VOL.: 4.87 cy		
MATERIAL LIST / SOLID SLAB					
ITEM	MARK	DESCRIPTION	QTY./SLAB		
			5536	5537	5538
1	404	#4 BENT BAR	30	24	24
2	501	#5 BENT BAR	6	6	6
4		DAYTON 8T x 6 3/4" SWIFT LIFT LIFTER	2	2	2
5					

APPROVAL STAMP:

RECEIVED
 OK'D BY: [Signature]
 NOV 14 2003
 RESUBMIT: [] APPROVED: []
 BY: [] DATE: 12/3/03

J.P. CARRARA & SONS INC.
 Precast & Prestress Manufacturer
 264 CREE STR., WOODVILLE, VERMONT 05733 Phone: (802)388-6361 Fax: (802)388-9010

KUBRICKY CONSTRUCTION CORP.
 CONTRACTOR
 GLENS FALLS, NEW YORK

STATE OF VERMONT
 AGENCY OF TRANSPORTATION

TOWN OF COLCHESTER
 PROJECT NUMBER: STP BIKE (48)

P/S SOLID SLAB DETAILS

DATE: SEPT. 26, 2003
 SCALE: NOTED
 CHKD: [] DFTM: B.L.
 JOB NO: 23169-03
 DWG. NO: **SS13**
 112

J.P. CARRARA & SONS, INC.
 NOV 12 2003
 ISSUED FOR PRODUCTION