




**DIMENSIONAL PLAN VIEW IN FORM**  
1/4" = 1'-0"

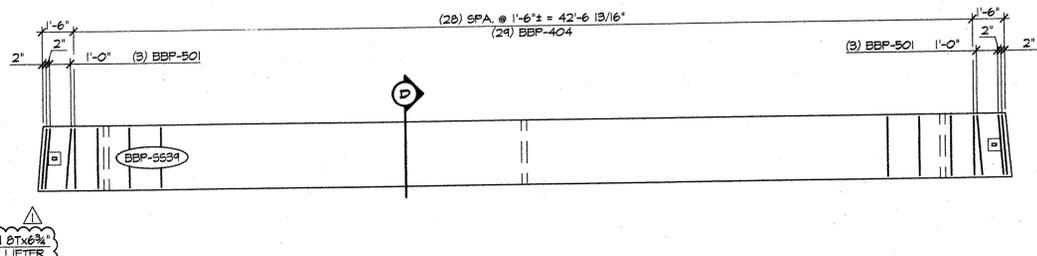


**REINFORCING PLAN VIEW IN FORM**  
1/4" = 1'-0"

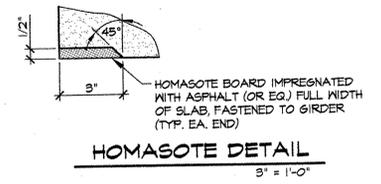


**HOMASOTE DETAIL**  
3" = 1'-0"

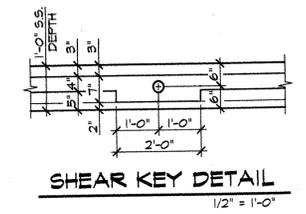


**SHEAR KEY DETAIL**  
1/2" = 1'-0"

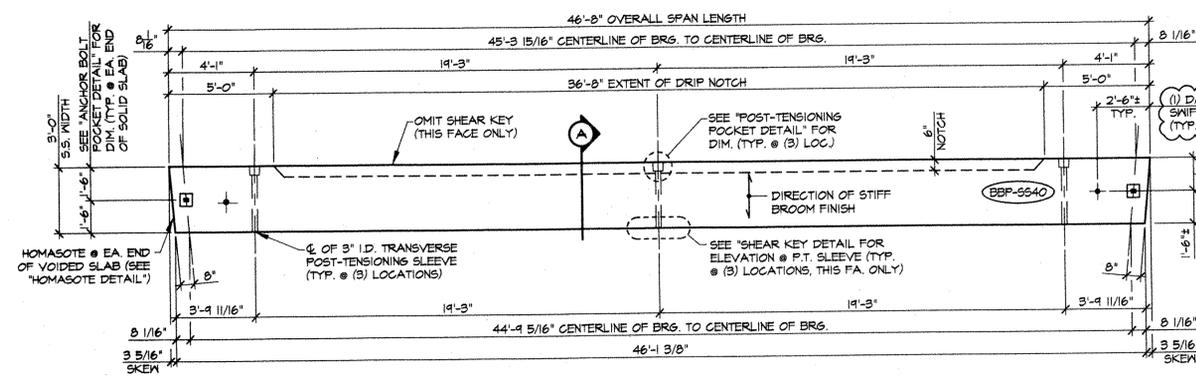


**DIMENSIONAL PLAN VIEW IN FORM**  
1/4" = 1'-0"

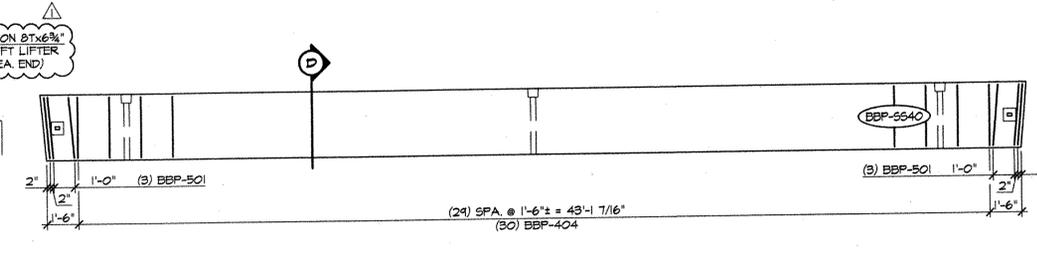


**REINFORCING PLAN VIEW IN FORM**  
1/4" = 1'-0"

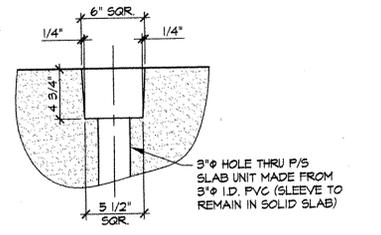


**POST-TENSIONING POCKET DETAIL**  
1 1/2" = 1'-0"

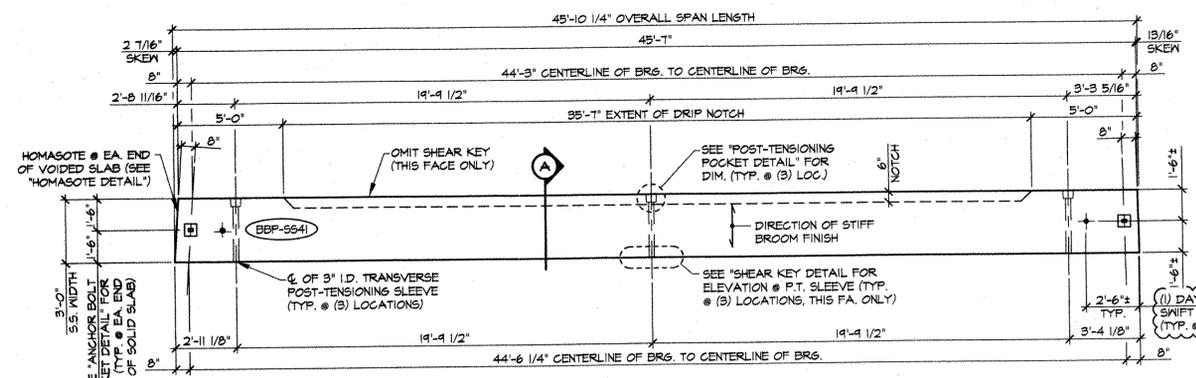


**DIMENSIONAL PLAN VIEW IN FORM**  
1/4" = 1'-0"

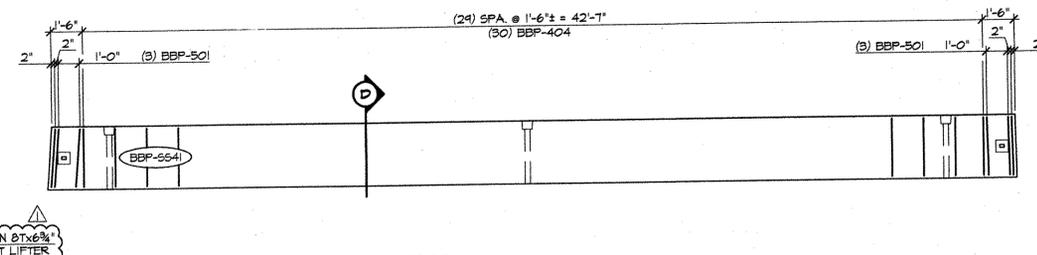


**REINFORCING PLAN VIEW IN FORM**  
1/4" = 1'-0"

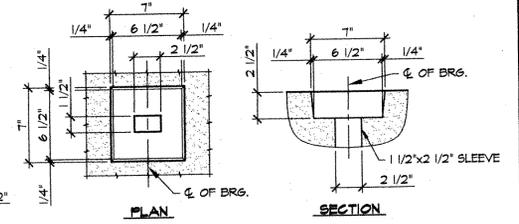


**ANCHOR BOLT POCKET DETAIL**  
1 1/2" = 1'-0"

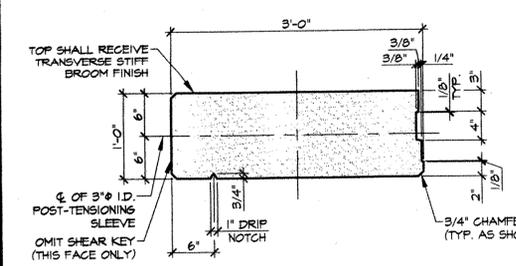


**A DIMENSIONAL SECTION**  
1" = 1'-0"

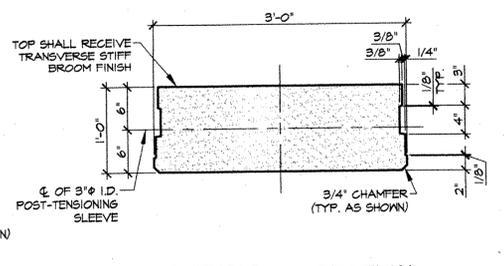


**B DIMENSIONAL SECTION**  
1" = 1'-0"

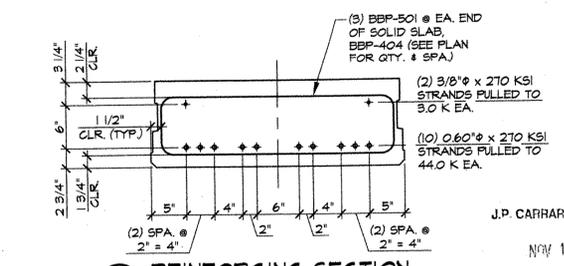

**D REINFORCING SECTION**  
1" = 1'-0"

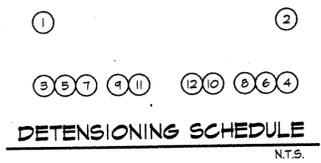

**DETENSIONING SCHEDULE**  
N.T.S.

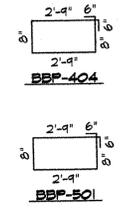

MARK: BBP-5534	QTY.: 1	WT.: 4.99 T	VOL.: 4.93 cy	(F <sub>cl</sub> = 4,000 PSI) (F <sub>c</sub> = 6,000 PSI)	
MARK: BBP-5540	QTY.: 1	WT.: 10.26 T	VOL.: 5.07 cy		
MARK: BBP-5541	QTY.: 1	WT.: 10.11 T	VOL.: 4.99 cy		
MATERIAL LIST / SOLID SLAB					
ITEM	MARK	DESCRIPTION	QTY./SLAB		
			5534	5540	5541
1	404	#4 BENT BAR	24	30	30
2	501	#5 BENT BAR	6	6	6
3					
4		DAYTON 8T x 6 3/4" SWIFT LIFT LIFTER	2	2	2
5					

APPROVAL STAMP:

RECEIVED  
 NOV 14 2003  
 RESUBMIT APPROVED  
 BY DATE 12/3/03

**J.P. CARRARA & SONS INC.** KUBRICKY CONSTRUCTION CORP.  
 Precast & Prestress Manufacturer CONTRACTOR  
 2464 CASE ST., MOORESBURY, VERMONT 05753 Phone: (802) 388-6361 Fax: (802) 388-9010 GLENS FALLS, NEW YORK

STATE OF VERMONT  
 AGENCY OF TRANSPORTATION

TOWN OF COLCHESTER  
 PROJECT NUMBER: STP BIKE (48)

P/S SOLID SLAB DETAILS

DATE: SEPT. 26, 2003  
 SCALE: NOTED  
 CHKD: DFTM: E.L.  
 JOB NO: 23169-03  
 DWG. NO: 5514  
 113