




DIMENSIONAL PLAN VIEW IN FORM
1/4" = 1'-0"

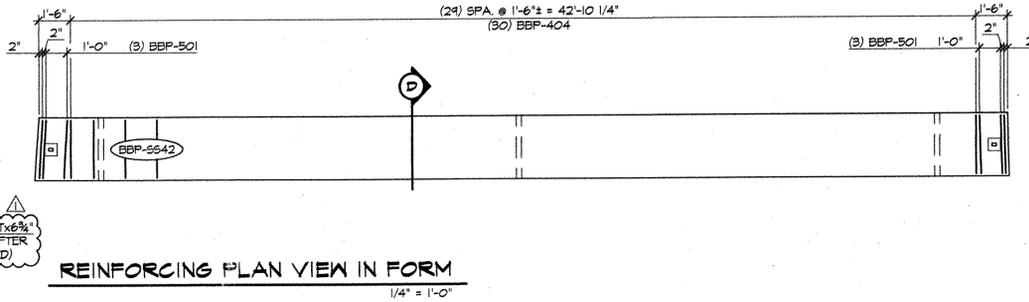


REINFORCING PLAN VIEW IN FORM
1/4" = 1'-0"

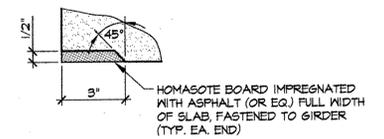


HOMASOTE DETAIL
3" = 1'-0"

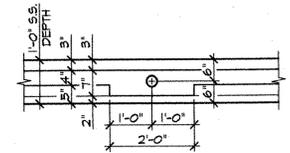


SHEAR KEY DETAIL
1/2" = 1'-0"

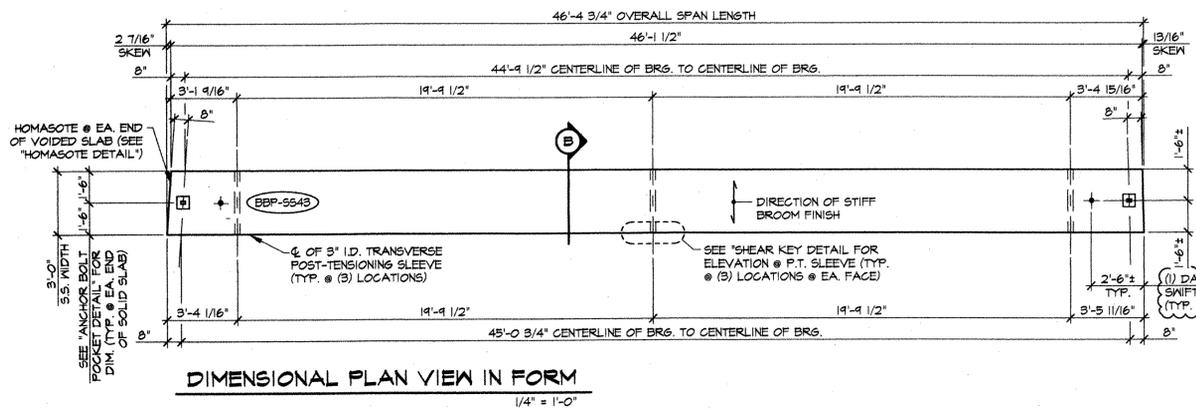


DIMENSIONAL PLAN VIEW IN FORM
1/4" = 1'-0"

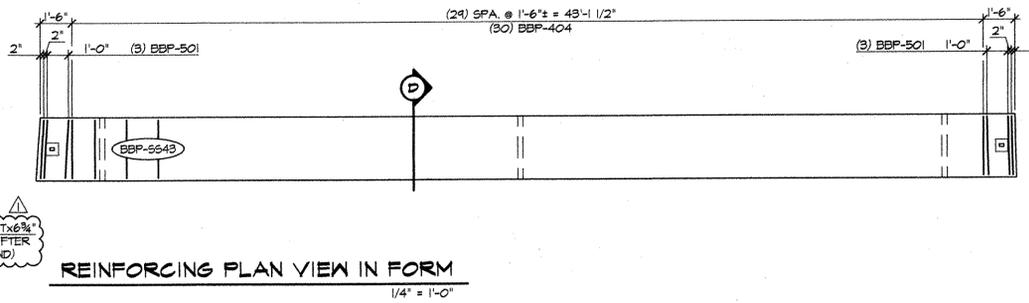


REINFORCING PLAN VIEW IN FORM
1/4" = 1'-0"

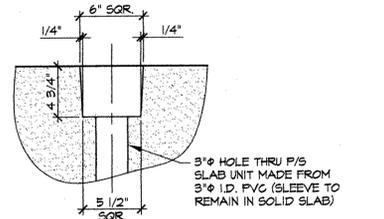


POST-TENSIONING POCKET DETAIL
1/2" = 1'-0"

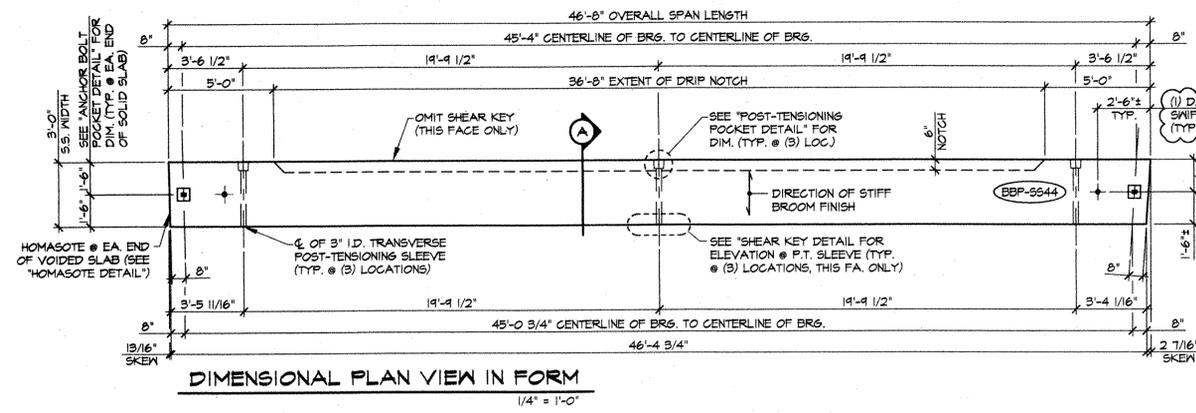


DIMENSIONAL PLAN VIEW IN FORM
1/4" = 1'-0"

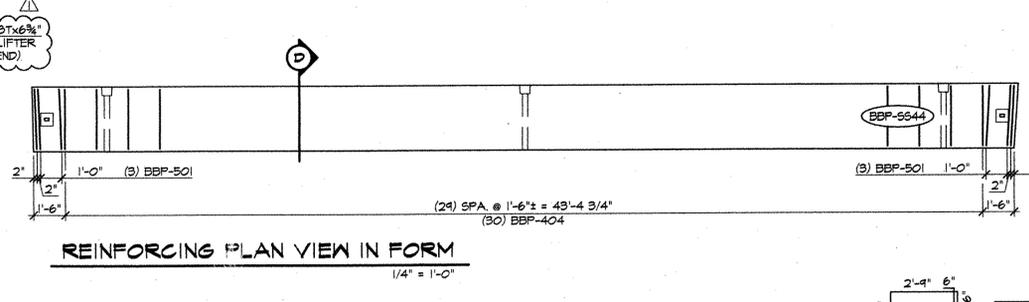


REINFORCING PLAN VIEW IN FORM
1/4" = 1'-0"

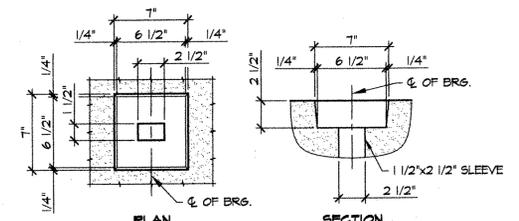


ANCHOR BOLT POCKET DETAIL
1/2" = 1'-0"

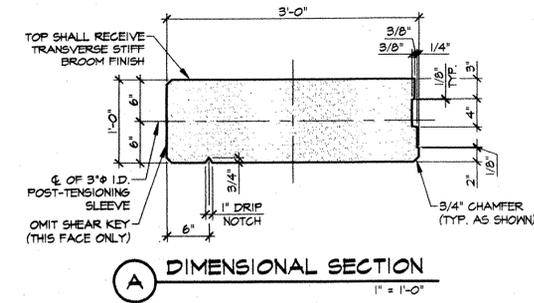



A DIMENSIONAL SECTION
1" = 1'-0"

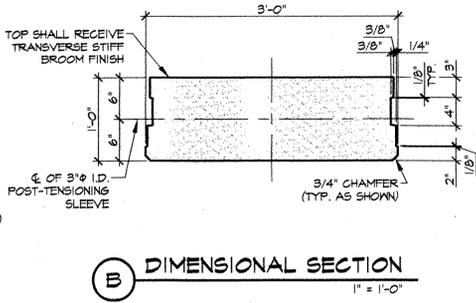

B DIMENSIONAL SECTION
1" = 1'-0"

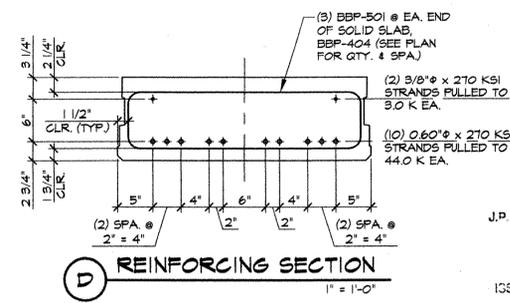

D REINFORCING SECTION
1" = 1'-0"

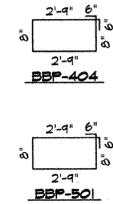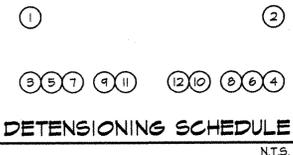

MARK: BBP-5542	QTY.: 1	WT.: 9.84 T	VOL.: 4.86 cy
MARK: BBP-5543	QTY.: 1	WT.: 10.08 T	VOL.: 4.98 cy
MARK: BBP-5544	QTY.: 1	WT.: 10.24 T	VOL.: 5.08 cy

MATERIAL LIST / SOLID SLAB

ITEM	MARK	DESCRIPTION	QTY./SLAB		
			5542	5543	5544
1	404	#4 BENT BAR	30	30	30
2	501	#5 BENT BAR	6	6	6
3					
4	△	DAYTON 8T x 6 3/4" SWIFT LIFT LIFTER	2	2	2
5					

APPROVAL STAMP:
RECEIVED
NOV 14 2003
ISSUED FOR PRODUCTION

J.P. CARRARA & SONS INC.
Precast & Prestress Manufacturer
264 CASE ST., MOORESBURY, VERMONT 05753 Phone: (802)388-6361 Fax: (802)388-0010

KUBRICKY CONSTRUCTION CORP.
CONTRACTOR
GLENS FALLS, NEW YORK

STATE OF VERMONT
AGENCY OF TRANSPORTATION

TOWN OF COLCHESTER
PROJECT NUMBER: STP BIKE (48)

P/S SOLID SLAB DETAILS

DATE: SEPT. 26, 2003
SCALE: NOTED
CHKD: DFTM: B.L.
JOB NO: 23169-03
DWG. NO: SS15
114