




DIMENSIONAL PLAN VIEW IN FORM
1/4" = 1'-0"

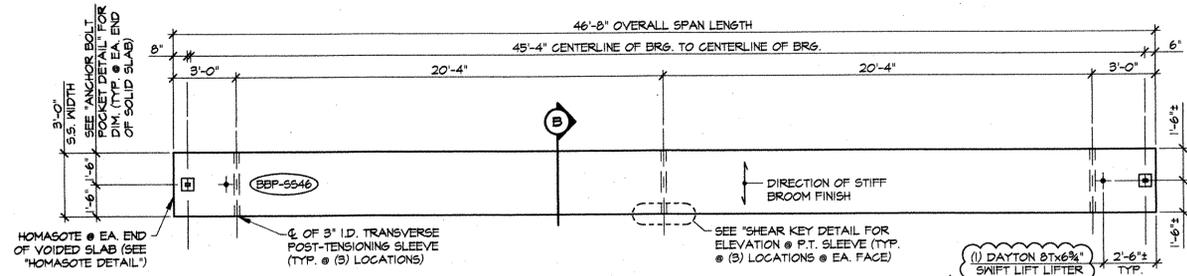


DIMENSIONAL PLAN VIEW IN FORM
1/4" = 1'-0"

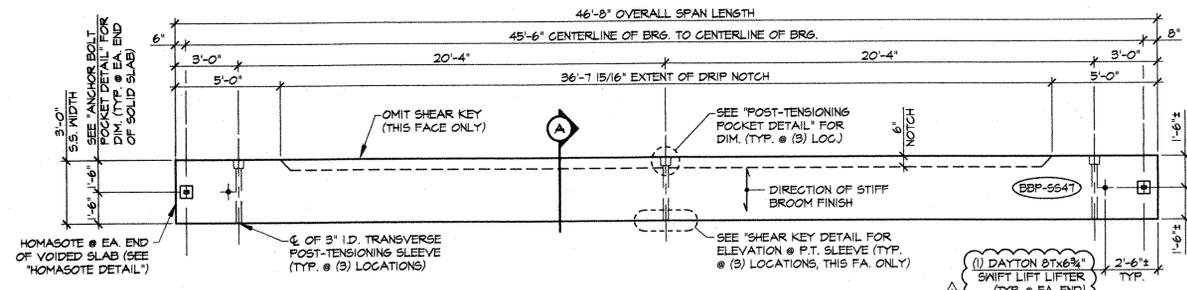


DIMENSIONAL PLAN VIEW IN FORM
1/4" = 1'-0"

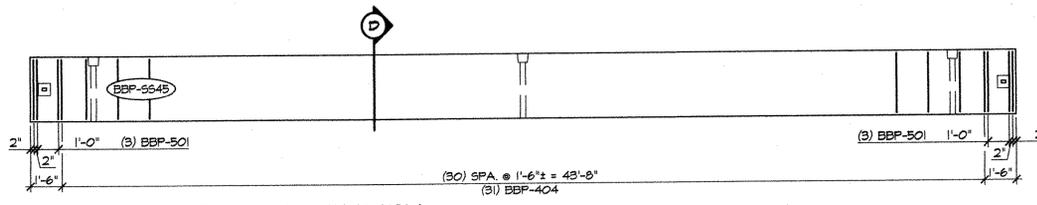


REINFORCING PLAN VIEW IN FORM
1/4" = 1'-0"

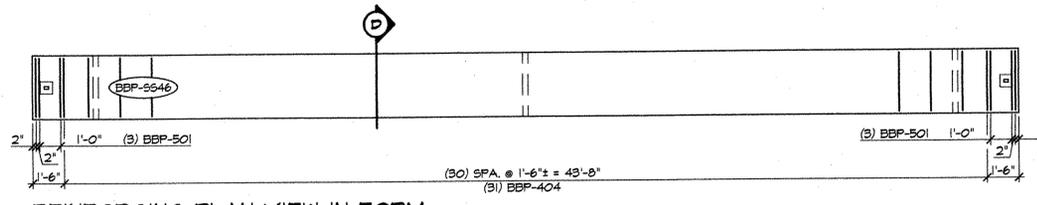


REINFORCING PLAN VIEW IN FORM
1/4" = 1'-0"

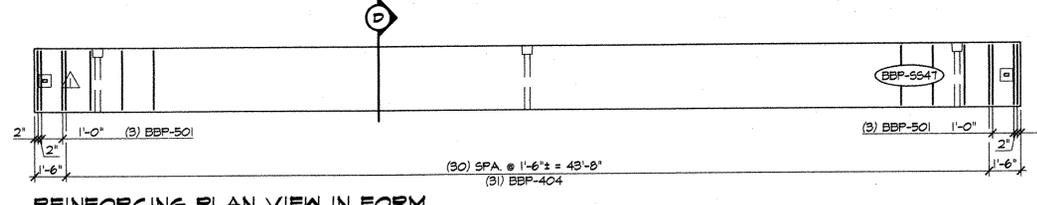


REINFORCING PLAN VIEW IN FORM
1/4" = 1'-0"

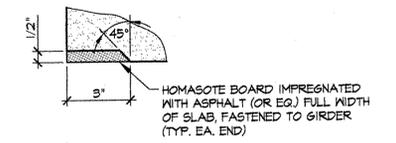


HOMASOTE DETAIL
3" = 1'-0"

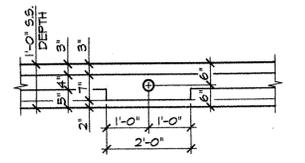

SHEAR KEY DETAIL
1/2" = 1'-0"

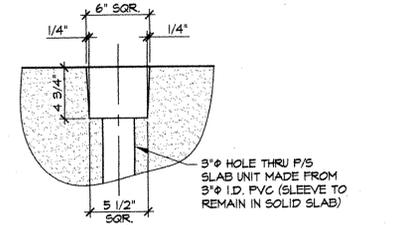

POST-TENSIONING POCKET DETAIL
1/2" = 1'-0"

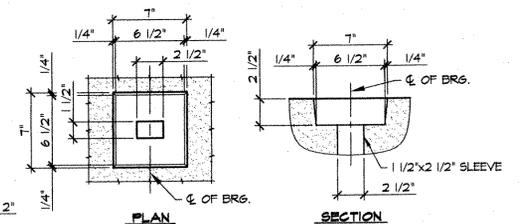


ANCHOR BOLT POCKET DETAIL
1/2" = 1'-0"


① ②

③ ⑤ ⑦ ⑨ ⑪ ⑫ ⑬ ⑭ ⑮ ⑯ ⑰ ⑱


DETENSIONING SCHEDULE
N.T.S.

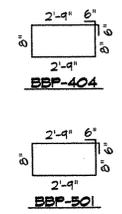


MARK: BBP-SS45	QTY.: 1	WT.: 10.32 T	VOL.: 5.10 cy	(FCI = 4000 PSI) (FCI = 6000 PSI)	
MARK: BBP-SS46	QTY.: 2	WT.: 10.1 T	VOL.: 5.02 cy		
MARK: BBP-SS47	QTY.: 1	WT.: 10.32 T	VOL.: 5.10 cy		
MATERIAL LIST / SOLID SLAB					
ITEM	MARK	DESCRIPTION	QTY./SLAB		
			SS45	SS46	SS47
1	404	#4 BENT BAR	31	31	31
2	501	#5 BENT BAR	6	6	6
3					
4	DAYTON	8T x 6 3/4" SWIFT LIFT LIFTER	2	2	2
5					

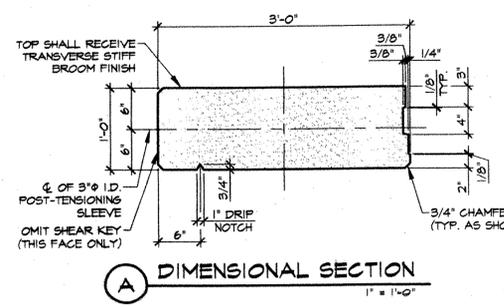

A DIMENSIONAL SECTION
1" = 1'-0"

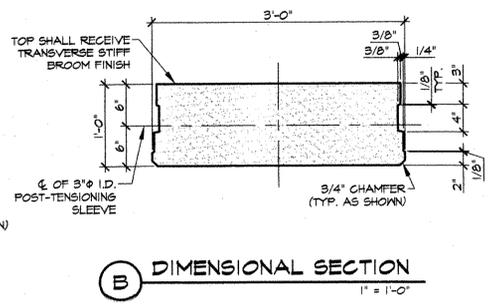

B DIMENSIONAL SECTION
1" = 1'-0"

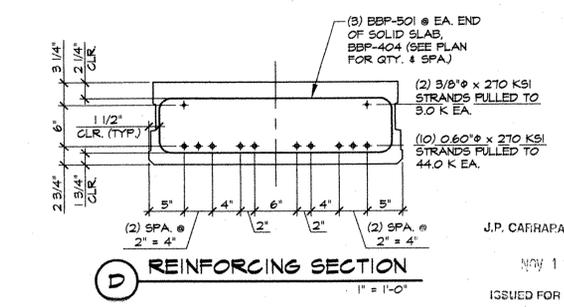

D REINFORCING SECTION
1" = 1'-0"

J.P. CARRARA & SONS, INC.
NOV 12 2003
ISSUED FOR PRODUCTION

APPROVAL STAMP:

RECEIVED
NOV 14 2003

RESUBMIT APPROVED
BY DATE 12/17/03

J.P. CARRARA & SONS INC. KUBRICKY CONSTRUCTION CORP.
Precast & Prestress Manufacturer CONTRACTOR
2844 CASE STR., MIDDLEBURY, VERMONT 05753 Phone: (802)388-6361 Fax: (802)388-9010 GLENS FALLS, NEW YORK

STATE OF VERMONT AGENCY OF TRANSPORTATION
TOWN OF COLCHESTER PROJECT NUMBER: STP BIKE (48)
F/S SOLID SLAB DETAILS

DATE: SEPT. 26, 2003
SCALE: NOTED
CHKD: DFTM: B.L.
JOB NO: 23164-03
DWG. NO: SS16
115