






BENT BARS, TIES, & STIRRUPS

ITEM	MARK	QTY.	SIZE	LENGTH	TYPE	A	B	C	D	E	F/R	Ø	H	J	K	O	GRADE	REMARKS
1	401	468	#4	7'-11"	T2	6"	3'-0"	Ø"	3'-0"	Ø"		6"					60	
2	402	216	#4	3'-4 3/4"	S10		1'-6"	6 3/4"	1'-6"								60	
3	403	144	#4	5'-8 3/4"	S10		1'-6"	2'-10 3/4"	1'-6"								60	
4	404	5256	#4	7'-3"	T2	6"	2'-4"	Ø"	2'-4"	Ø"		6"					60	
5																		
6	501	888	#5	7'-2 3/8"	T2	6"	2'-4"	Ø"	2'-4"	Ø"		6"					60	
7																		
8																		
9																		
10																		

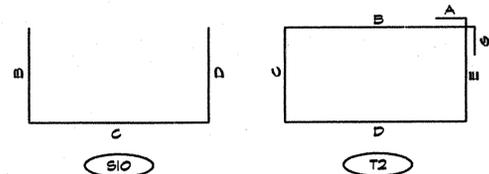

MISCELLANEOUS MATERIALS

ITEM	MARK	QTY.	DESCRIPTION	REMARKS
1	EM-1	222	FL WASHER 3/4" x 5" x 5" W/ (1) 2" HOLE (GALV.)	FOR ERECTION, SEE DETAIL THIS SHEET
2	EM-3	368	FL WASHER 3/4" x 5" x 5" W/ (1) 1 1/2" HOLE (GALV.)	FOR ERECTION, SEE DETAIL THIS SHEET
3		222	SINGLE USE STRESSING CHUCK	FOR ERECTION
4		111	1/2" Ø x 14'-4" POLYSTRAND	FOR ERECTION
5		296	1 1/4" Ø x 1'-10" ANCHOR BOLT (GALV.)	FOR ERECTION, SEE DETAIL THIS SHEET
6		T2	1 1/4" Ø x 2'-6 1/2" ANCHOR BOLT (GALV.)	FOR ERECTION, SEE DETAIL THIS SHEET
7				
8				
9				
10	BBB-L1	144	DAYTON 2T x 6" (MIN) SWIFT LIFT LIFTER (OR SIM)	
11				
12				
13				
14				
15				

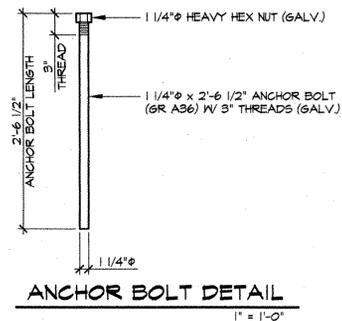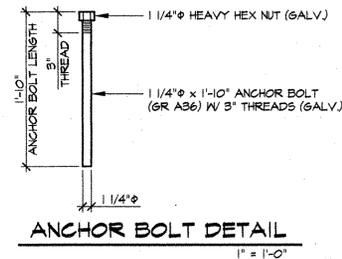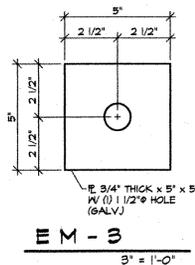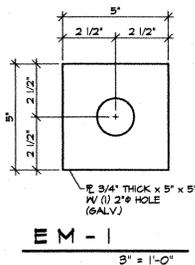

J.P. CARRARA & SONS, INC.
NOV 12 2003
ISSUED FOR PRODUCTION

11-11-03 REVISED AS NOTED

APPROVAL STAMP: RECEIVED OK'D BY <i>W. G. M.</i> OK'D BY _____ NOV 14 2003 RESUBMIT _____ APPROVED <i>✓</i> BY _____ DATE 12/3/03	J.P. CARRARA & SONS INC. Precast & Prestress Manufacturer <small>2464 CASE STR., MIDDLEBURY, VERMONT 05753 Phone: (802) 388-6361 Fax: (802) 388-9010</small>	KUBRICKY CONSTRUCTION CORP. CONTRACTOR <small>GLENS FALLS, NEW YORK</small>
	STATE OF VERMONT AGENCY OF TRANSPORTATION	DATE: SEPT. 26, 2003 SCALE: NOTED
	TOWN OF COLCHESTER PROJECT NUMBER: STP BIKE (48)	CHKD: _____ DFTM: B.L. JOB NO: 23169-03
MATERIALS LIST		DWG. NO: M1 116