


STATE OF VERMONT AGENCY OF TRANSPORTATION

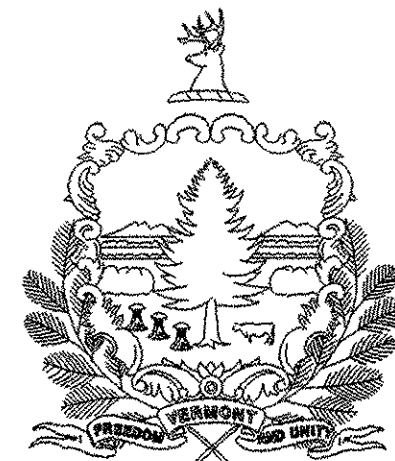

PROPOSED IMPROVEMENT TOWN OF COLCHESTER COUNTY OF CHITTENDEN

RECORD PLANS

CONTRACTOR: KUBRICKY CONST. CORP.
RESIDENT ENGINEER: JOE KNIPES
CONSTRUCTION BEGAN: SEPTEMBER 02, 2003
CONSTRUCTION COMPLETE: JULY 19, 2004
RECORD PLANS BY: K. NORTH & N. GARBACIK

I HEREBY CERTIFY THAT ALL THE CONSTRUCTION REQUIRED BY THIS SET OF DRAWINGS HAS BEEN ACCOMPLISHED AS INDICATED HEREIN.

BY [Signature] RESIDENT ENGINEER
DATE 12-14-04

NOTE: Any further information concerning final quantities, amounts or other details relative to this project may be found at Central Files in the electronic archives.



PROJECT LOCATION

Beginning in Colchester at a point on the existing bike path approximately 2176 feet northerly of the intersection of the bike path and North Avenue Extension, and extending northerly approximately 1986 feet to the intersection of Windermere Way and Horizon View Drive in the Town of Colchester.

PROJECT DESCRIPTION


Work to be performed under this project includes the construction of a new shared-use path.

Length of elevated path = 1691.53 feet - 0.320 miles
Length of path = 294.47 feet - 0.056 miles
Length of project = 1986.00 feet - 0.376 miles

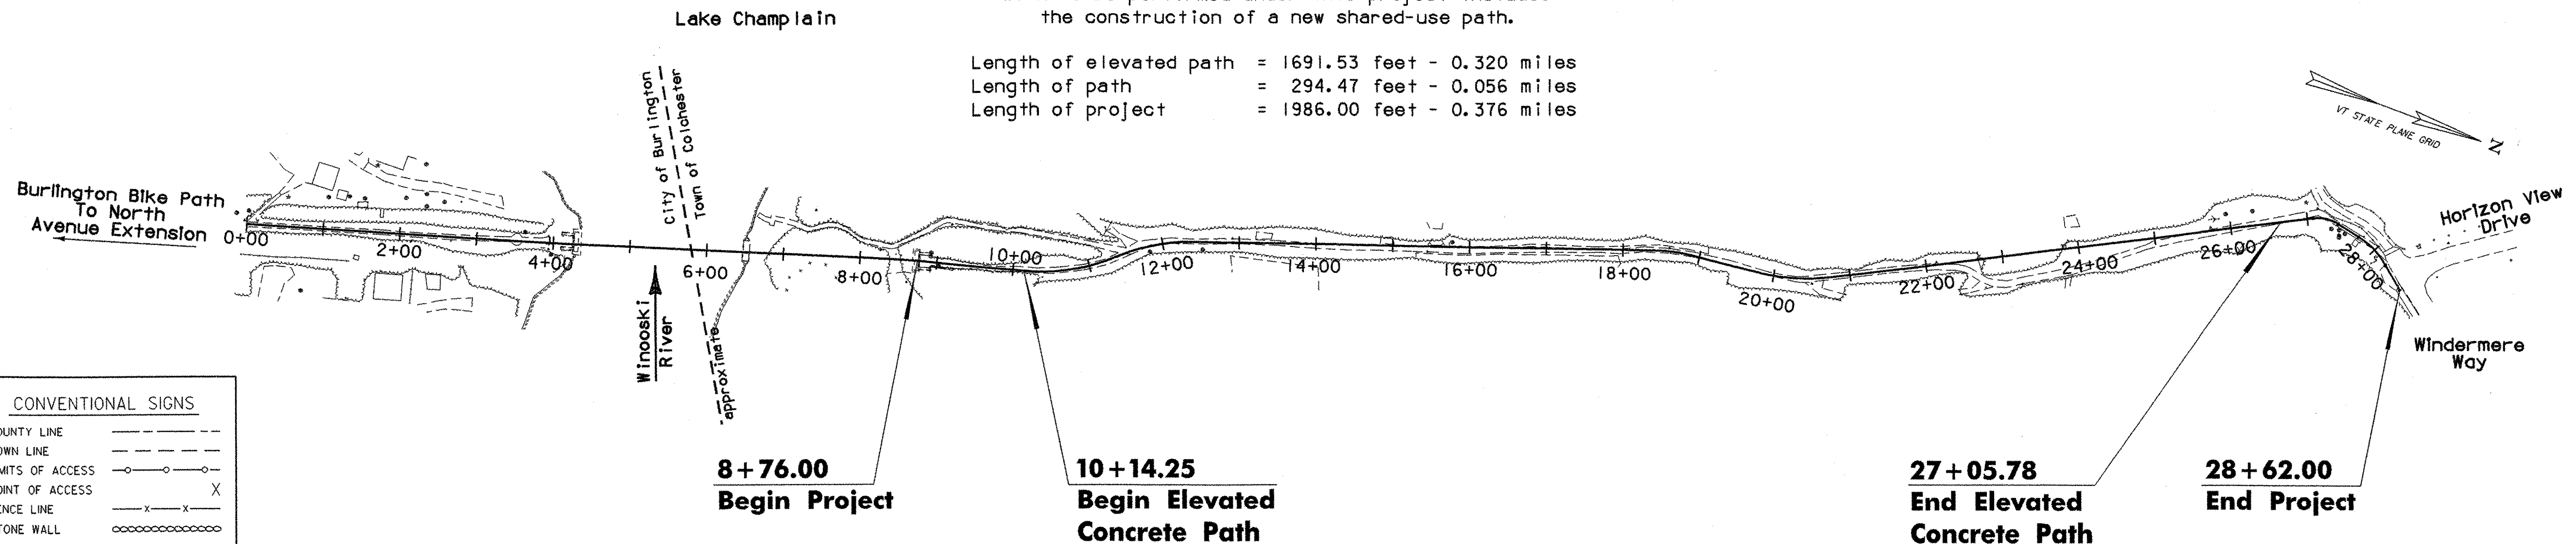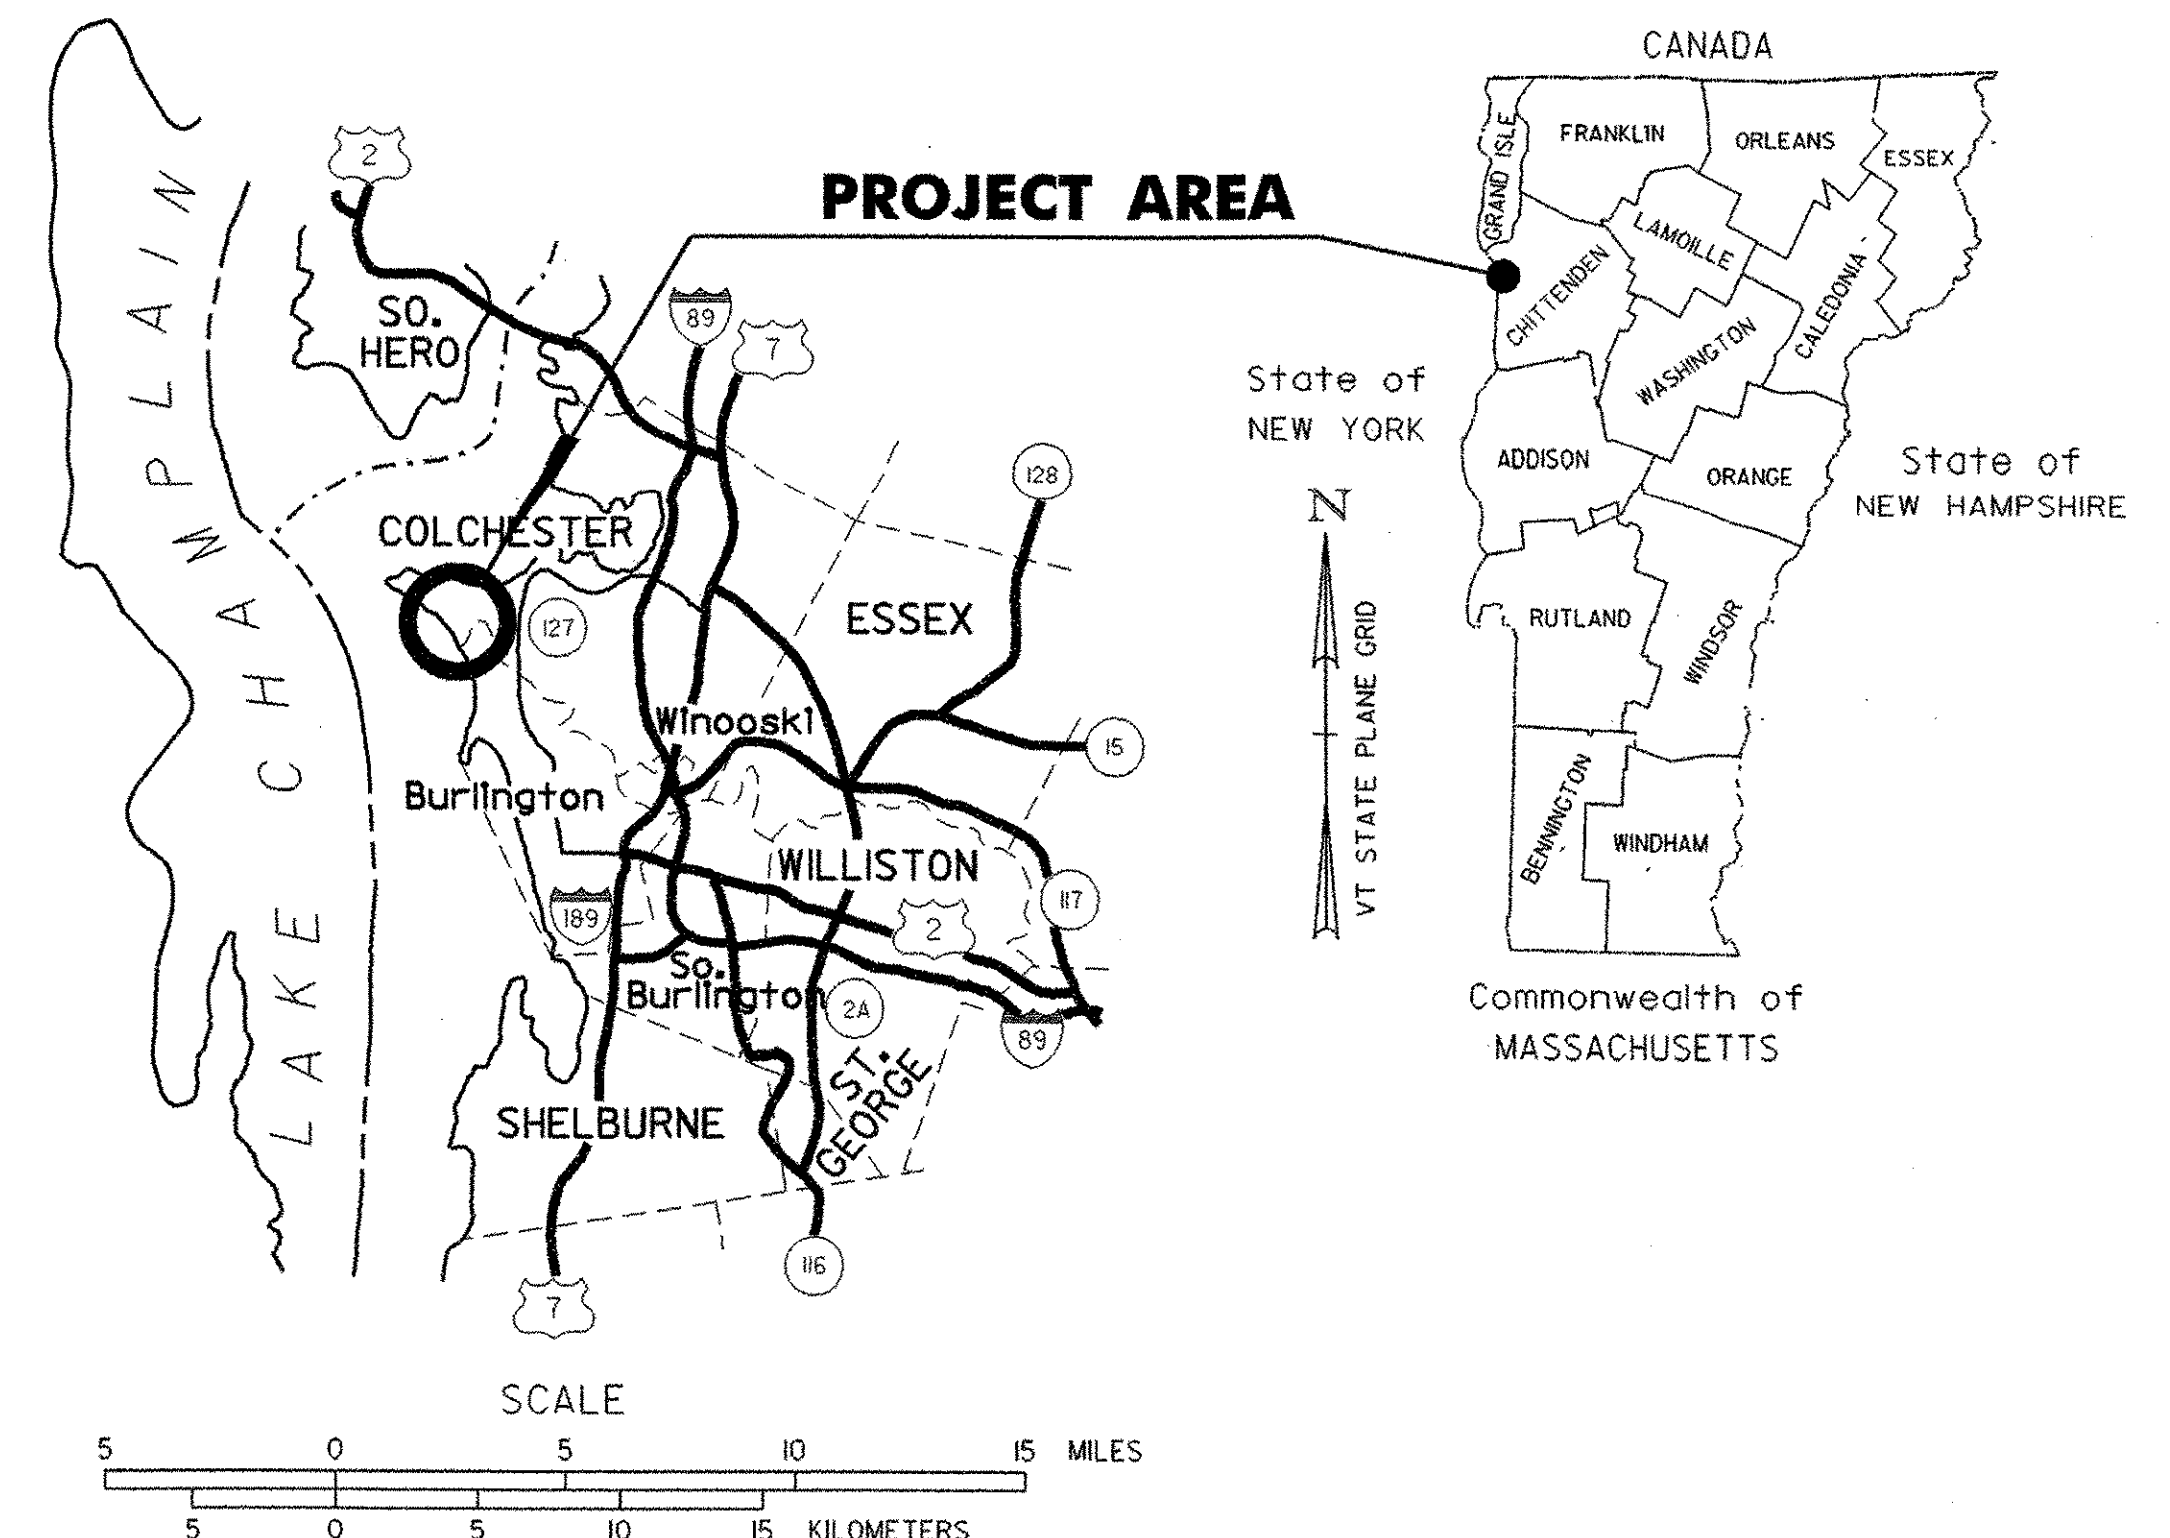

CONVENTIONAL SIGNS	
COUNTY LINE	---
TOWN LINE	---
LIMITS OF ACCESS	---o---o---
POINT OF ACCESS	X
FENCE LINE	---x---x---
STONE WALL	oooooo
TRAVELED WAY	---
GUARD RAIL	---o---o---
RAILROAD	
SURVEY LINE	---
CULVERT	---
POWER POLE	⊕
TELEPHONE POLE	⊕
TREES	⊙
CONTROL OF ACCESS	///
PROPERTY LINE	---
R.O.W. TAKING LINE	---
SLOPE RIGHTS	SR
TOP OF CUT	---
TOE OF SLOPE	---

DATUM	
VERTICAL	NAVD 88
HORIZONTAL	NAD 83 (96)

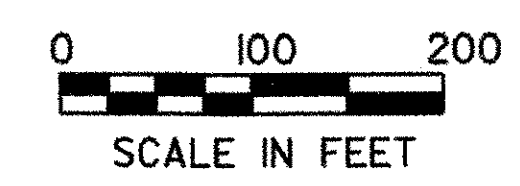

CHANGES AS MAY BE REQUIRED BY THE FEDERAL HIGHWAY ADMINISTRATION OR THE DIRECTOR OF PROJECT DEVELOPMENT.

CONSTRUCTION IS TO BE CARRIED ON IN ACCORDANCE WITH THESE PLANS AND THE STANDARD SPECIFICATIONS FOR CONSTRUCTION DATED 2001, AS APPROVED BY THE FEDERAL HIGHWAY ADMINISTRATION ON JANUARY 4, 2001 FOR USE ON THIS PROJECT, INCLUDING ALL SUBSEQUENT REVISIONS AND SUCH REVISED SPECIFICATIONS AND SPECIAL PROVISIONS AS ARE INCORPORATED IN THESE PLANS.

DIRECTOR OF PROJECT DEVELOPMENT	
APPROVED <u>[Signature]</u>	DATE <u>3/5/02</u>
PROJECT MANAGER : CRAIG KELLER	
PROJECT NAME :	Colchester
PROJECT NUMBER :	STP Bike (48)
SHEET 1 OF 87 SHEETS	