

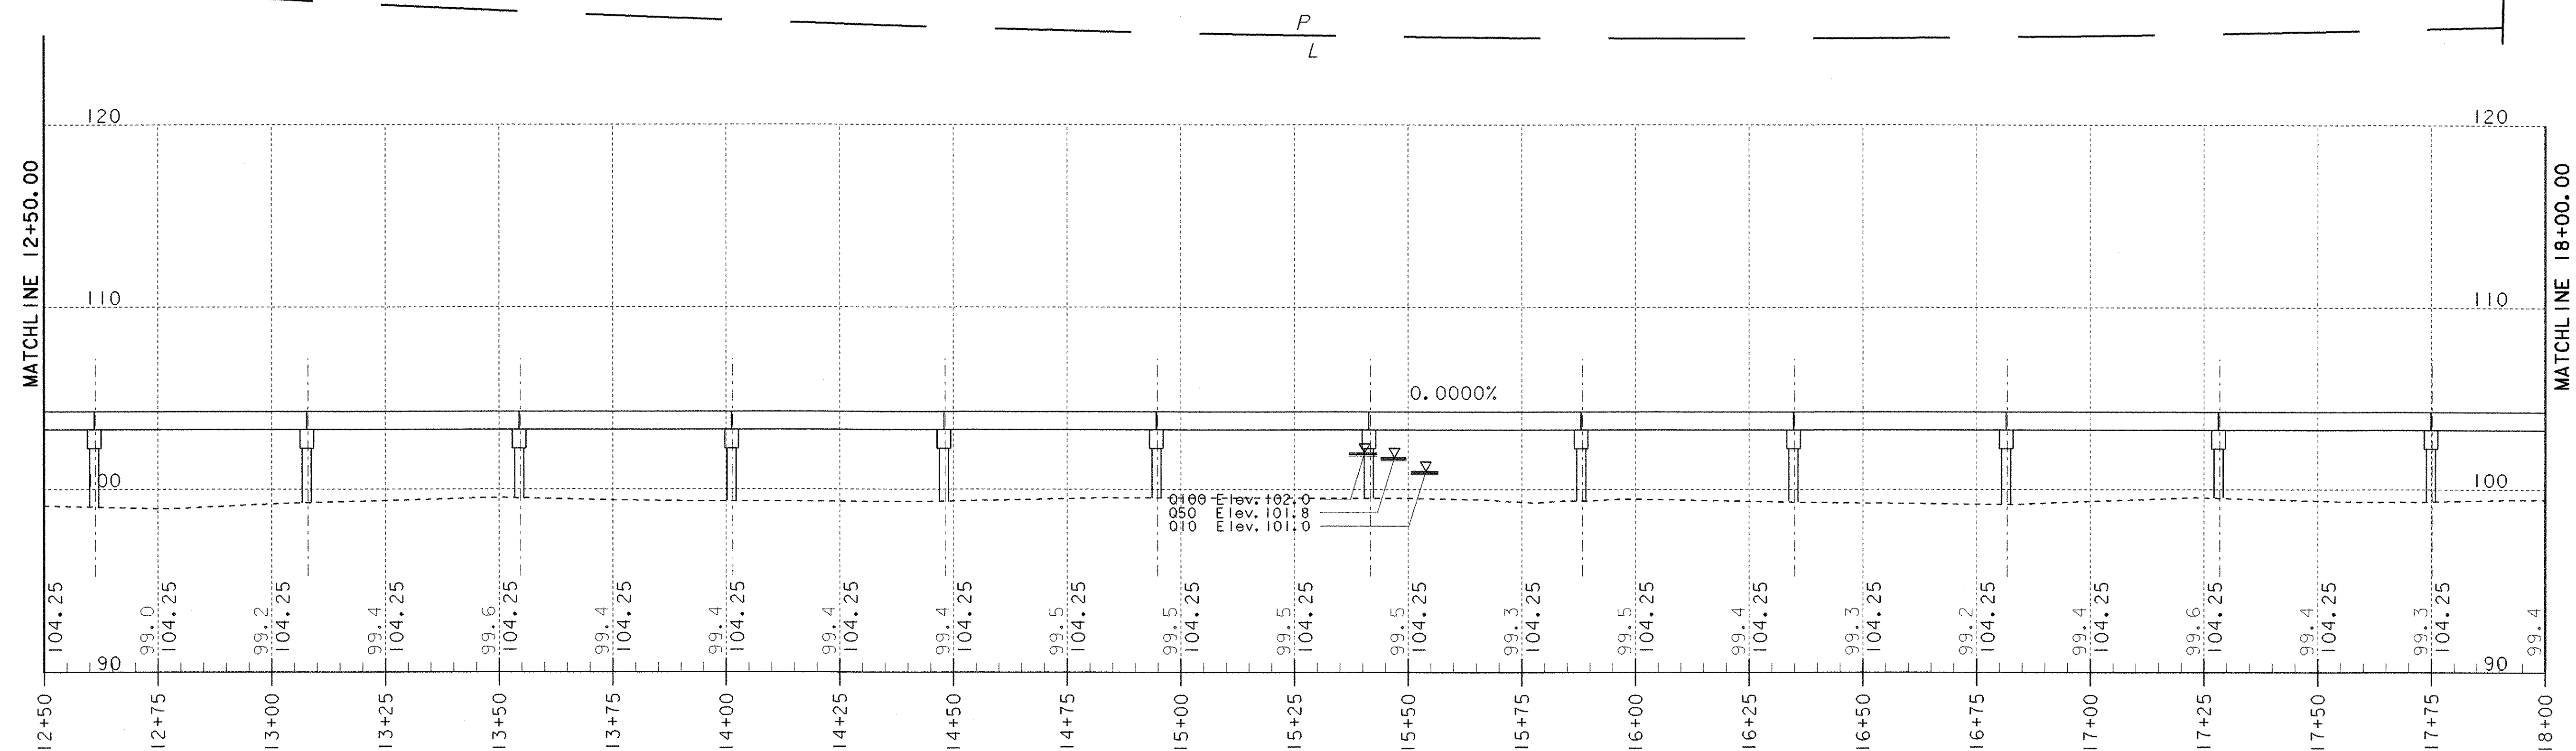


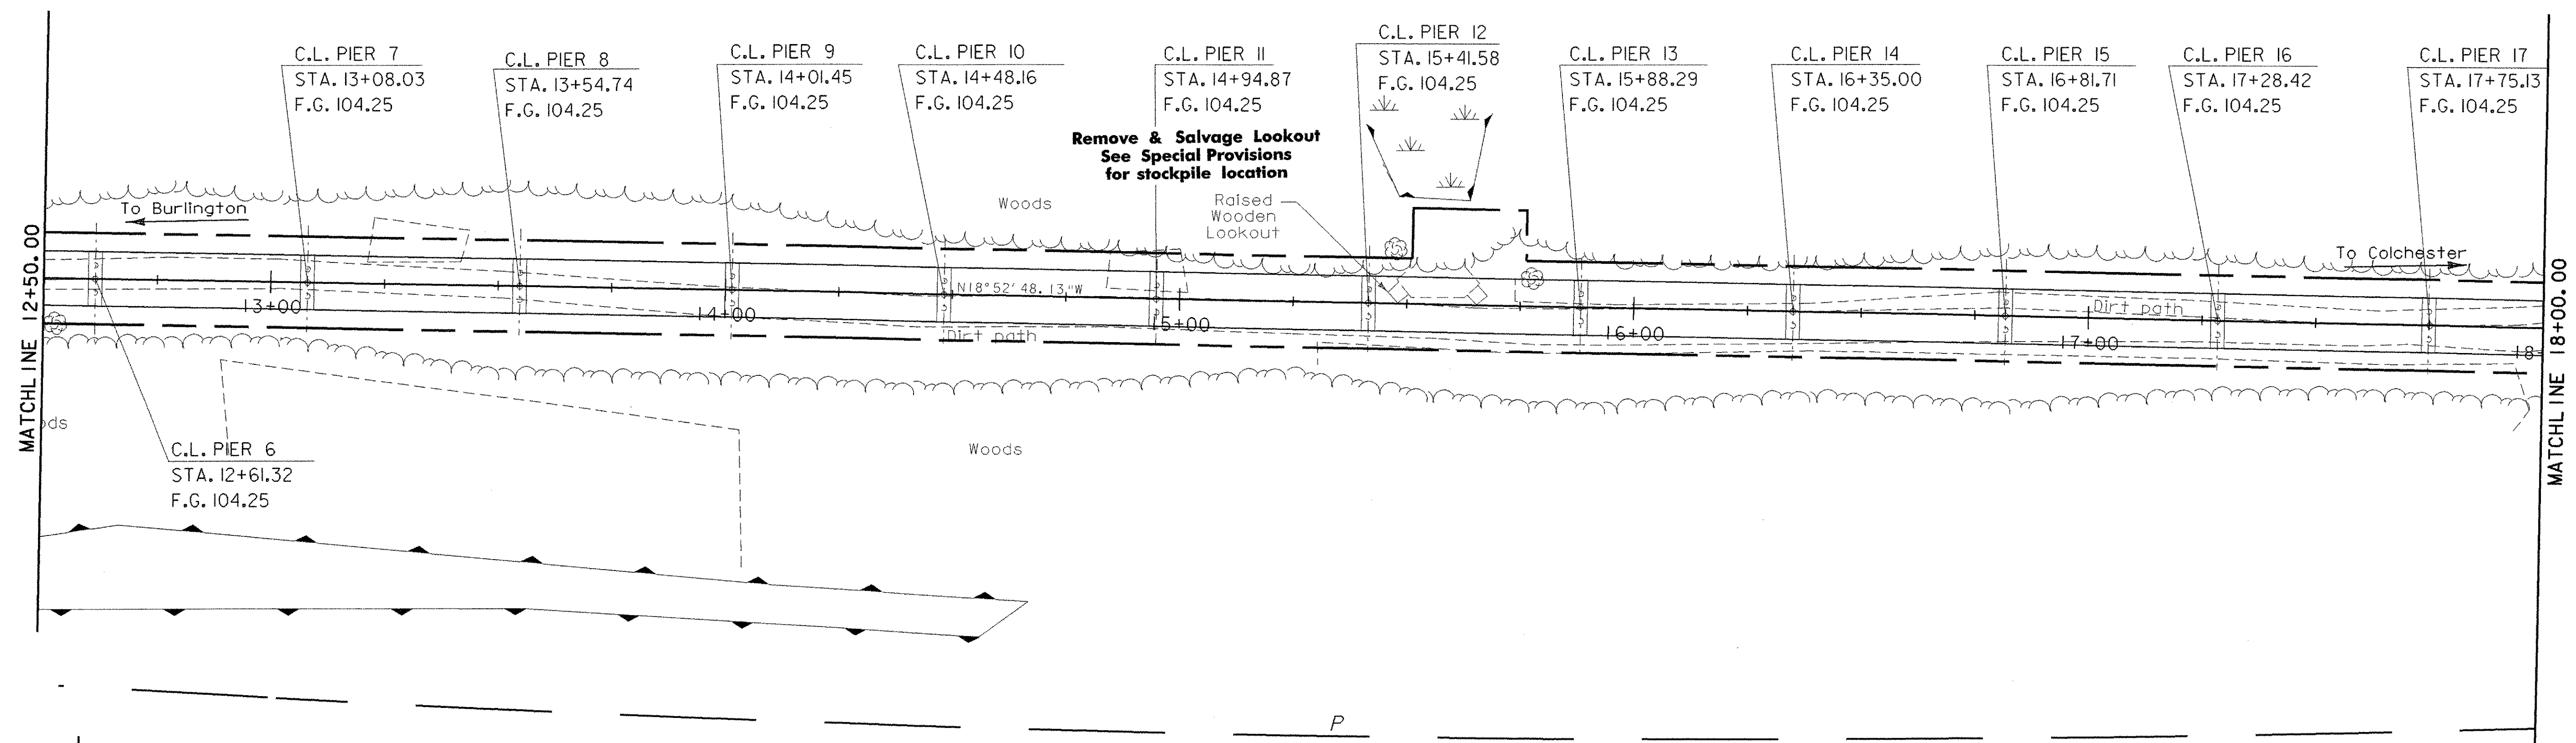

PROJECT NAME:	Colchester
PROJECT NUMBER:	STP Bike(48)
FILE NAME: /str5/03f038/sf038bdr.dgn	PLOT DATE: 05-AUG-2003
PROJECT LEADER: C. Keller	DRAWN BY: G. Shangraw
DESIGNED BY: M. Evans-Mongeon	CHECKED BY:
sf038L2.i	SHEET 23 OF 87

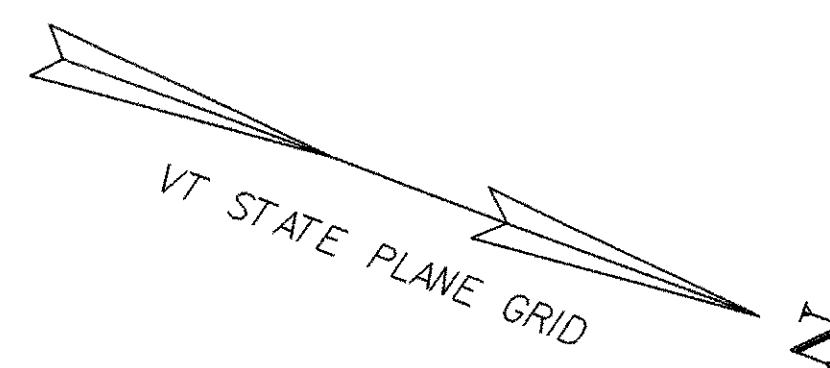