

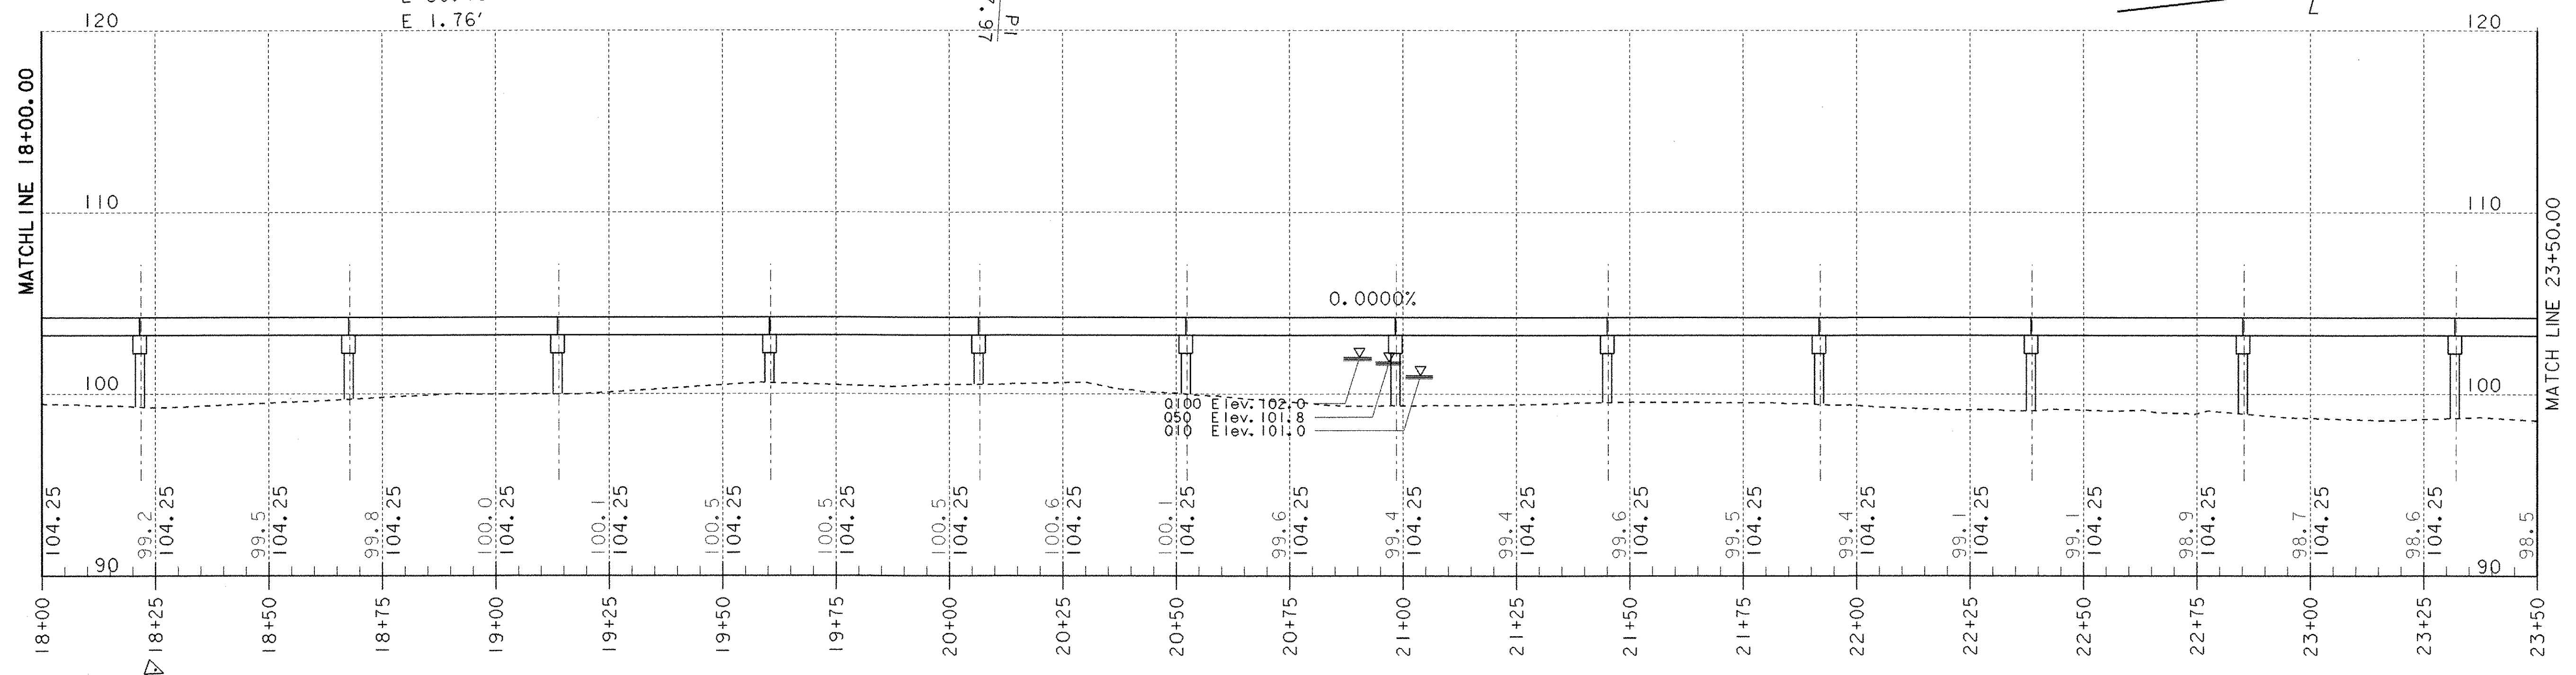


Delta 21°46'17.69"
 Dc 22°55'05.92"
 R 250.00'
 T 48.08'
 L 95.00'
 E 4.58'

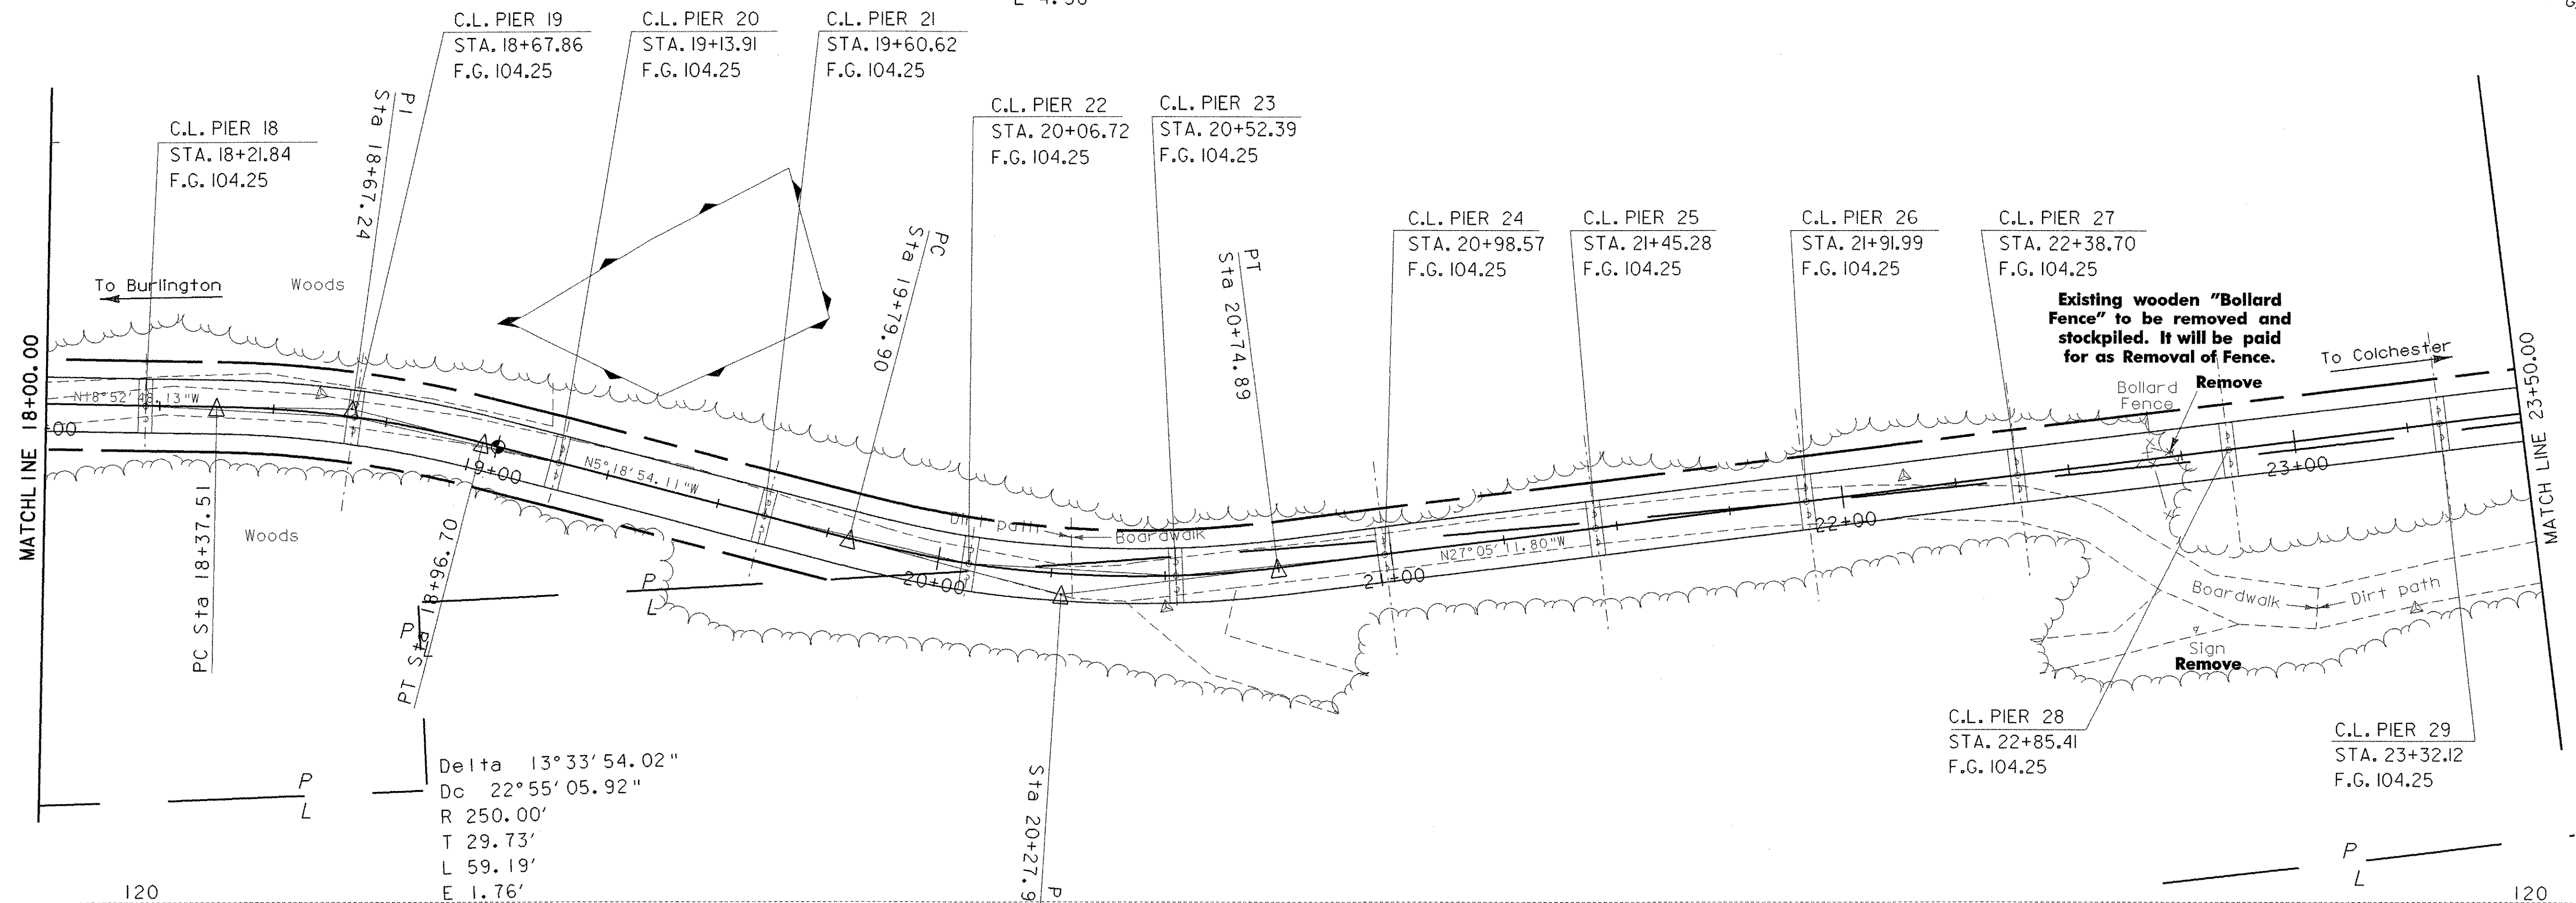

PROJECT NAME:	Colchester
PROJECT NUMBER:	STP Bike(48)
FILE NAME: /str5/03f038/sf038bdr.dgn	PLOT DATE: 05-AUG-2003
PROJECT LEADER: C. Keller	DRAWN BY: G. Shangraw
DESIGNED BY: M. Evans-Mongeon	CHECKED BY:
sf038L3.i	SHEET 24 OF 87

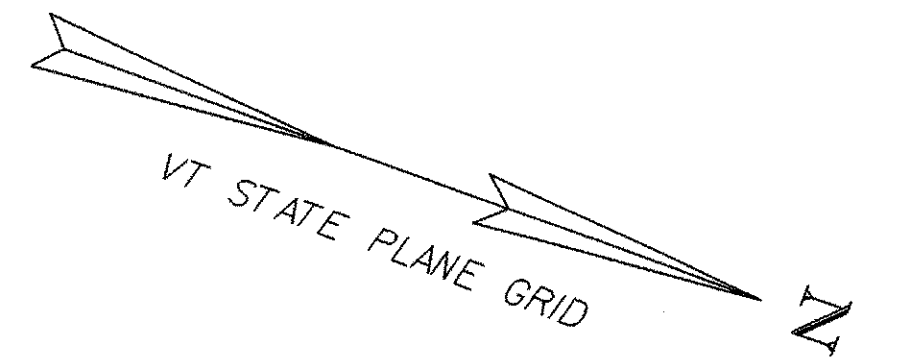