


WOOD BOLLARD WITH POST CAP
Sta. 27+25.0 Centerline


NOTE:
CONTRACTOR SHALL ENSURE BOLLARDS ARE REMOVABLE ONCE PLACED WITHIN SLEEVE BY MILLING TIMBER AS NEEDED.

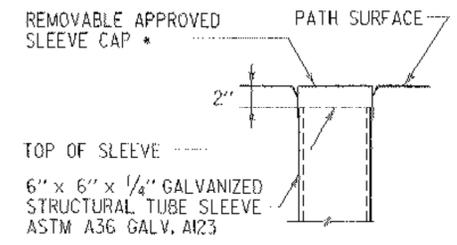


* CONTRACTOR SHALL SUPPLY RESIDENT ENGINEER WITH 4 ADDITIONAL SLEEVE CAPS TO BE RETAINED FOR FUTURE USE.

DETAIL A

* PAYMENT FOR BOLLARD, MARKERS, POST CAP AND SLEEVE WILL BE MADE UNDER ITEM 619.15 WOOD MARKER POST (MOD.)

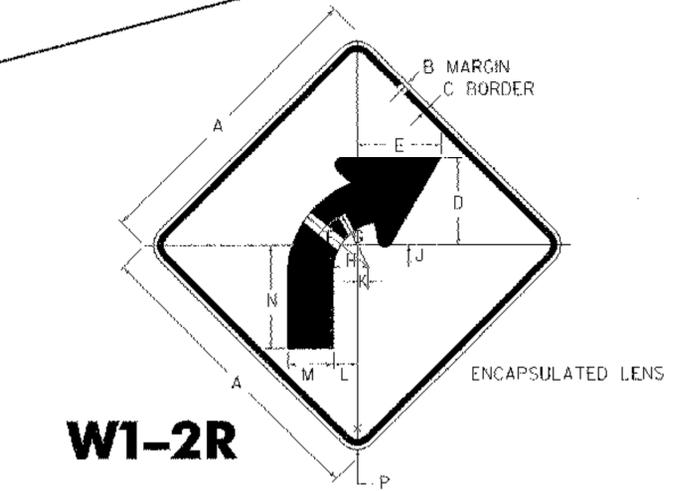


SIGN	DIMENSIONS (INCHES)													
	A	B	C	D	E	F	G	H	J	K	L	M	N	P
PATH	18	3/8	5/8	5 3/8	5 1/2	6	4 3/4	3 3/8	1 3/4	1 1/4	2	2 5/8	6 1/4	1 1/2

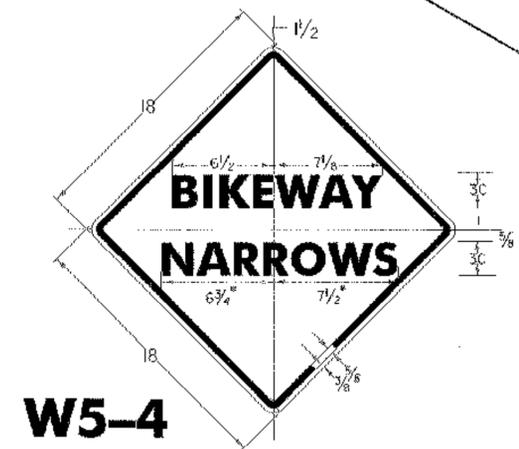

SEE STANDARD E-144 FOR ARROW HEAD DETAILS

SIGN	DIMENSIONS (INCHES)					
	A	B	C	D	E	F
PATH	18	3/8	5/8	5	5/8	1 1/2

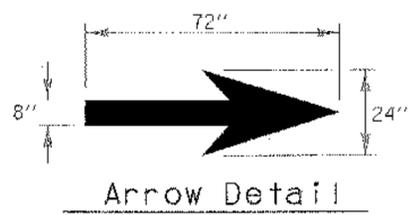

Signs & Markings

PROJECT NAME: Colchester
STP Bike(48)
PROJECT NUMBER:
FILE NAME: s:\s\03f038\s\038signs.dgn PLOT DATE: 05-AUG-2003
PROJECT LEADER: C. Keller DRAWN BY: G. Shangraw
DESIGNED BY: G. Shangraw CHECKED BY:
s\038signs.l SHEET 33 OF 87

