



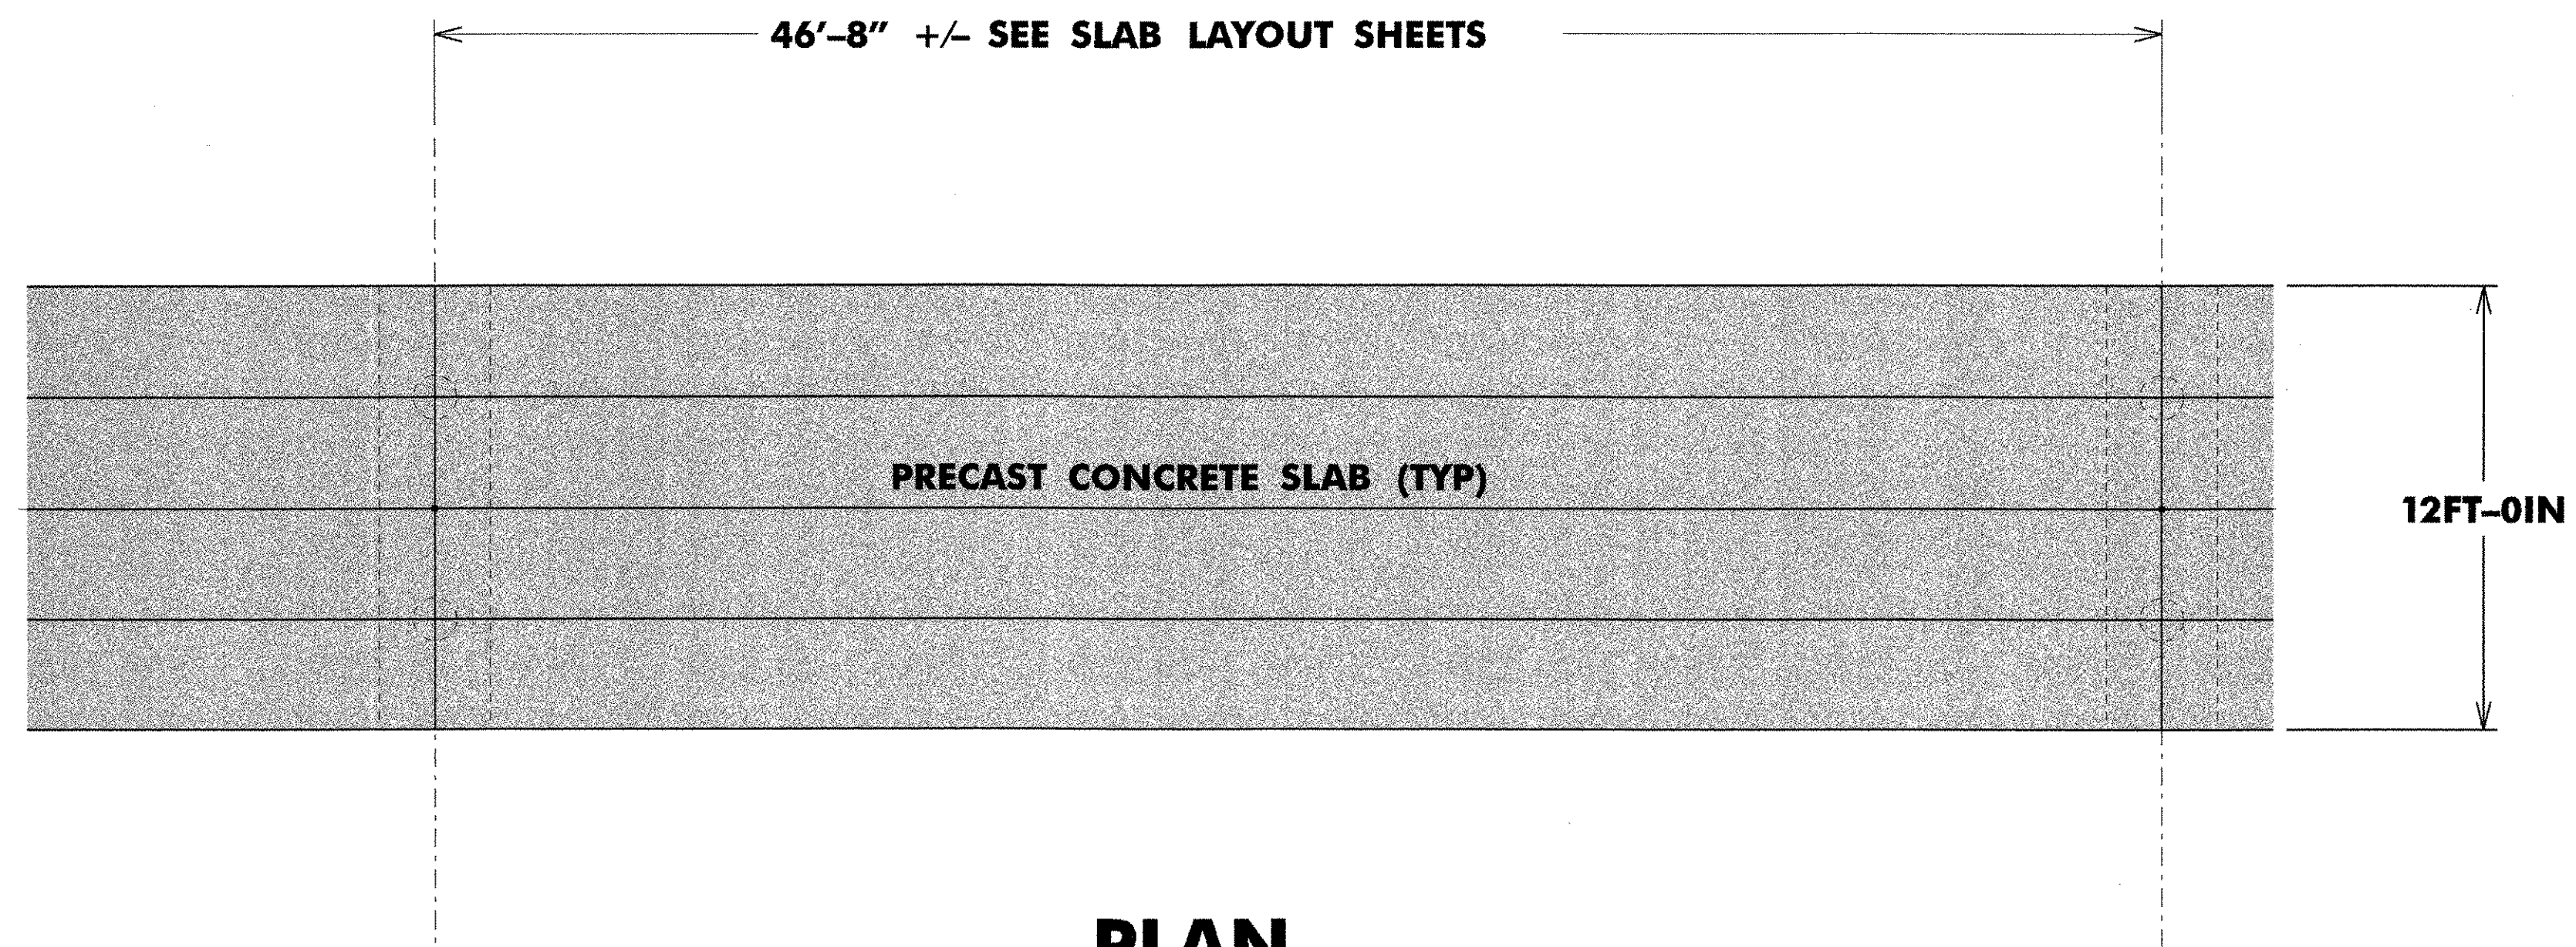


PLAN

SCALE 1/4" = 1'-0"

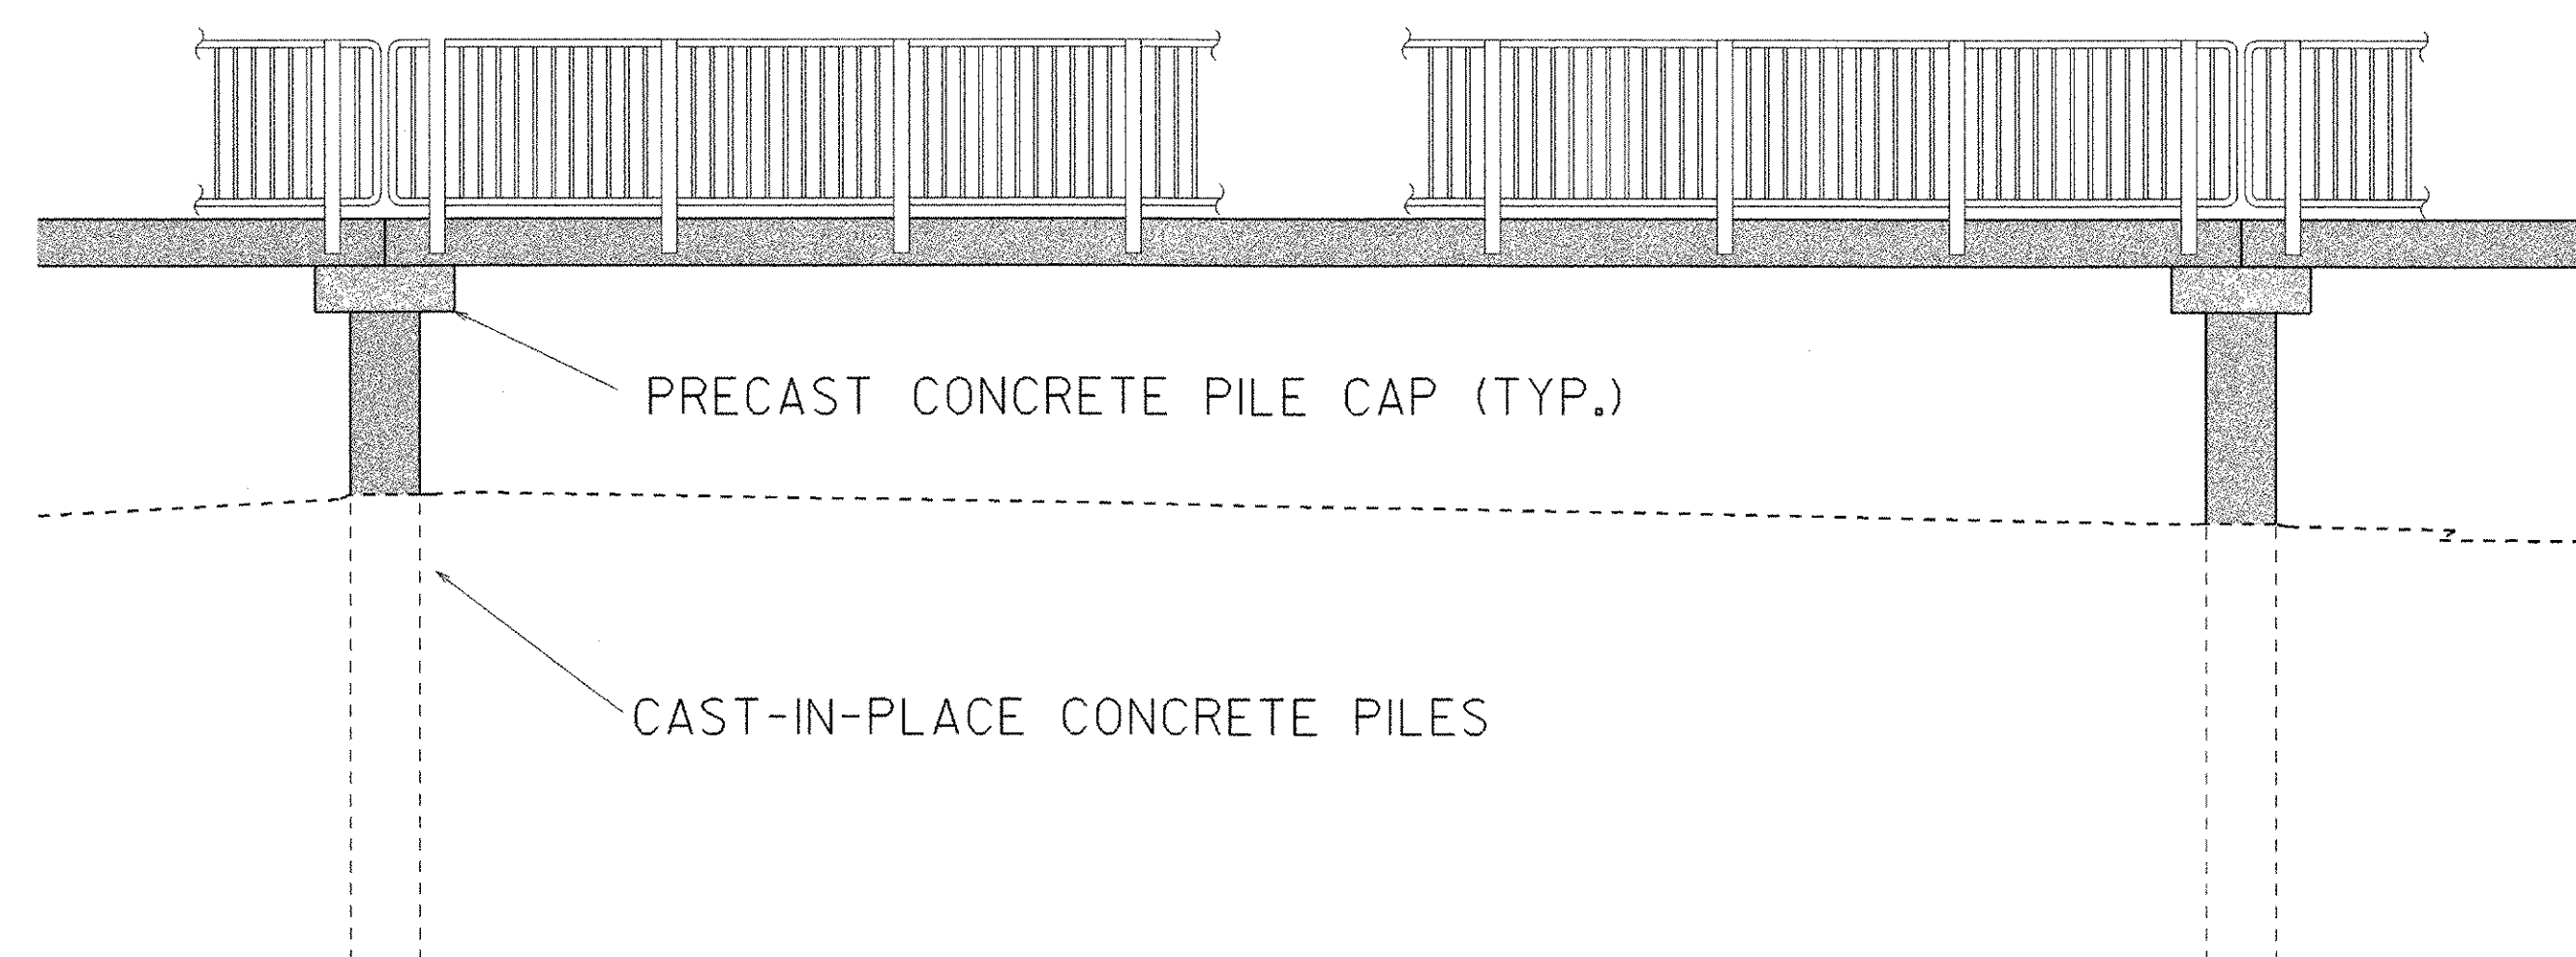

ELEVATION

SCALE 1/4" = 1'-0"

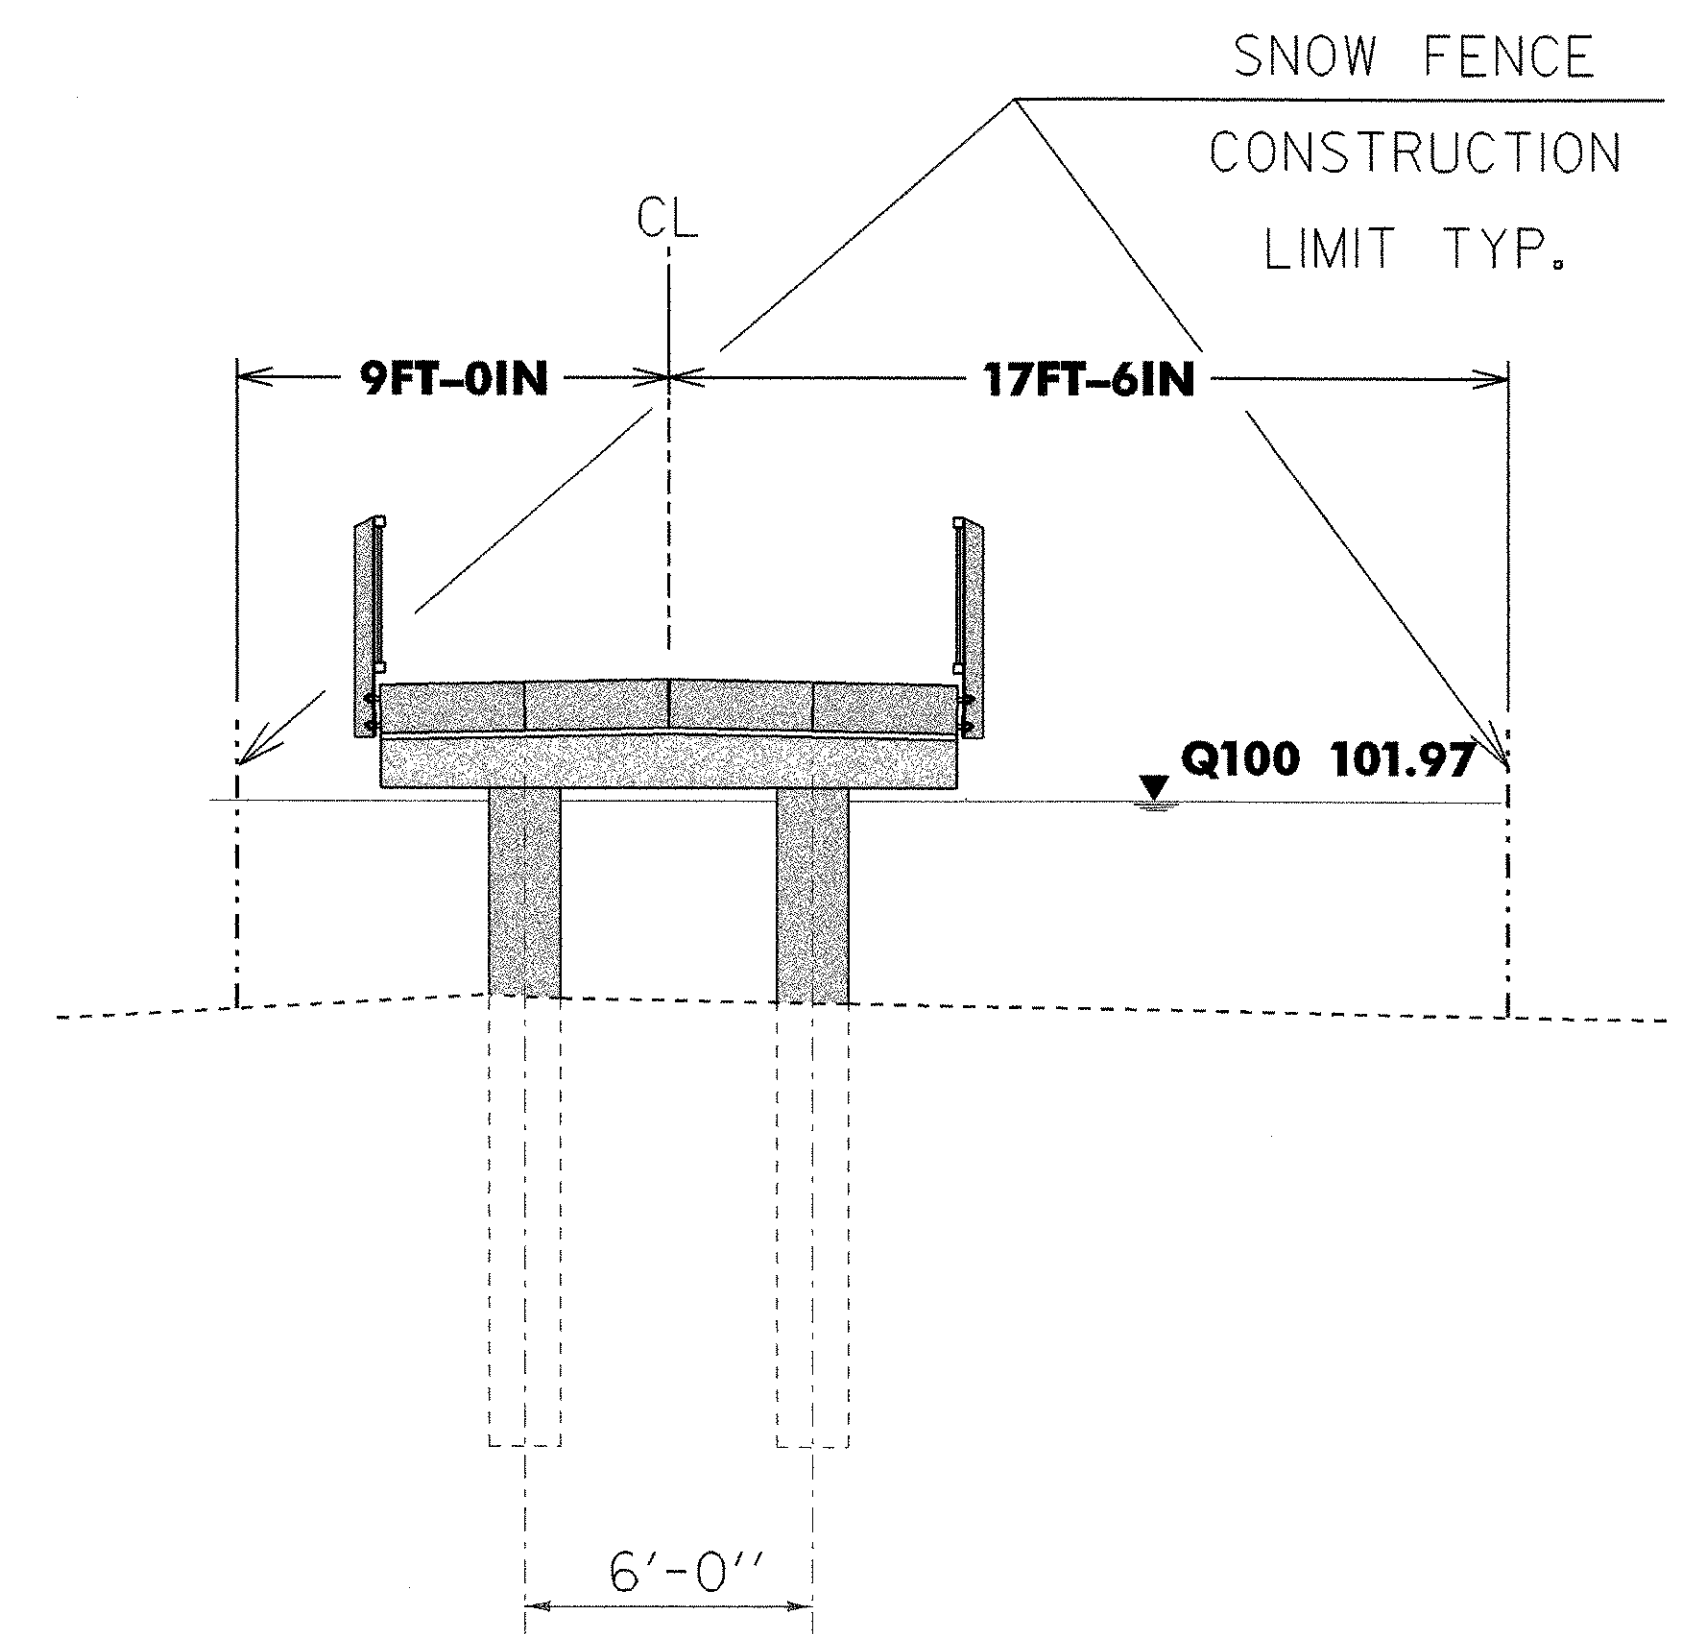

SECTION

SCALE 1/4" = 1'-0"

PLAN & ELEVATION

PROJECT NAME:	COLCHESTER	FILE NAME:	sr+5/03f038/sf038pe.dgn	PLOT DATE:	05-AUG-2003
PROJECT NUMBER:	STP BIKE(48)	PROJECT LEADER:	C. KELLER	DRAWN BY:	J. GEORGE
		DESIGNED BY:		CHECKED BY:	M.E.M.
			sf038pe.l	SHEET	38 OF 87