



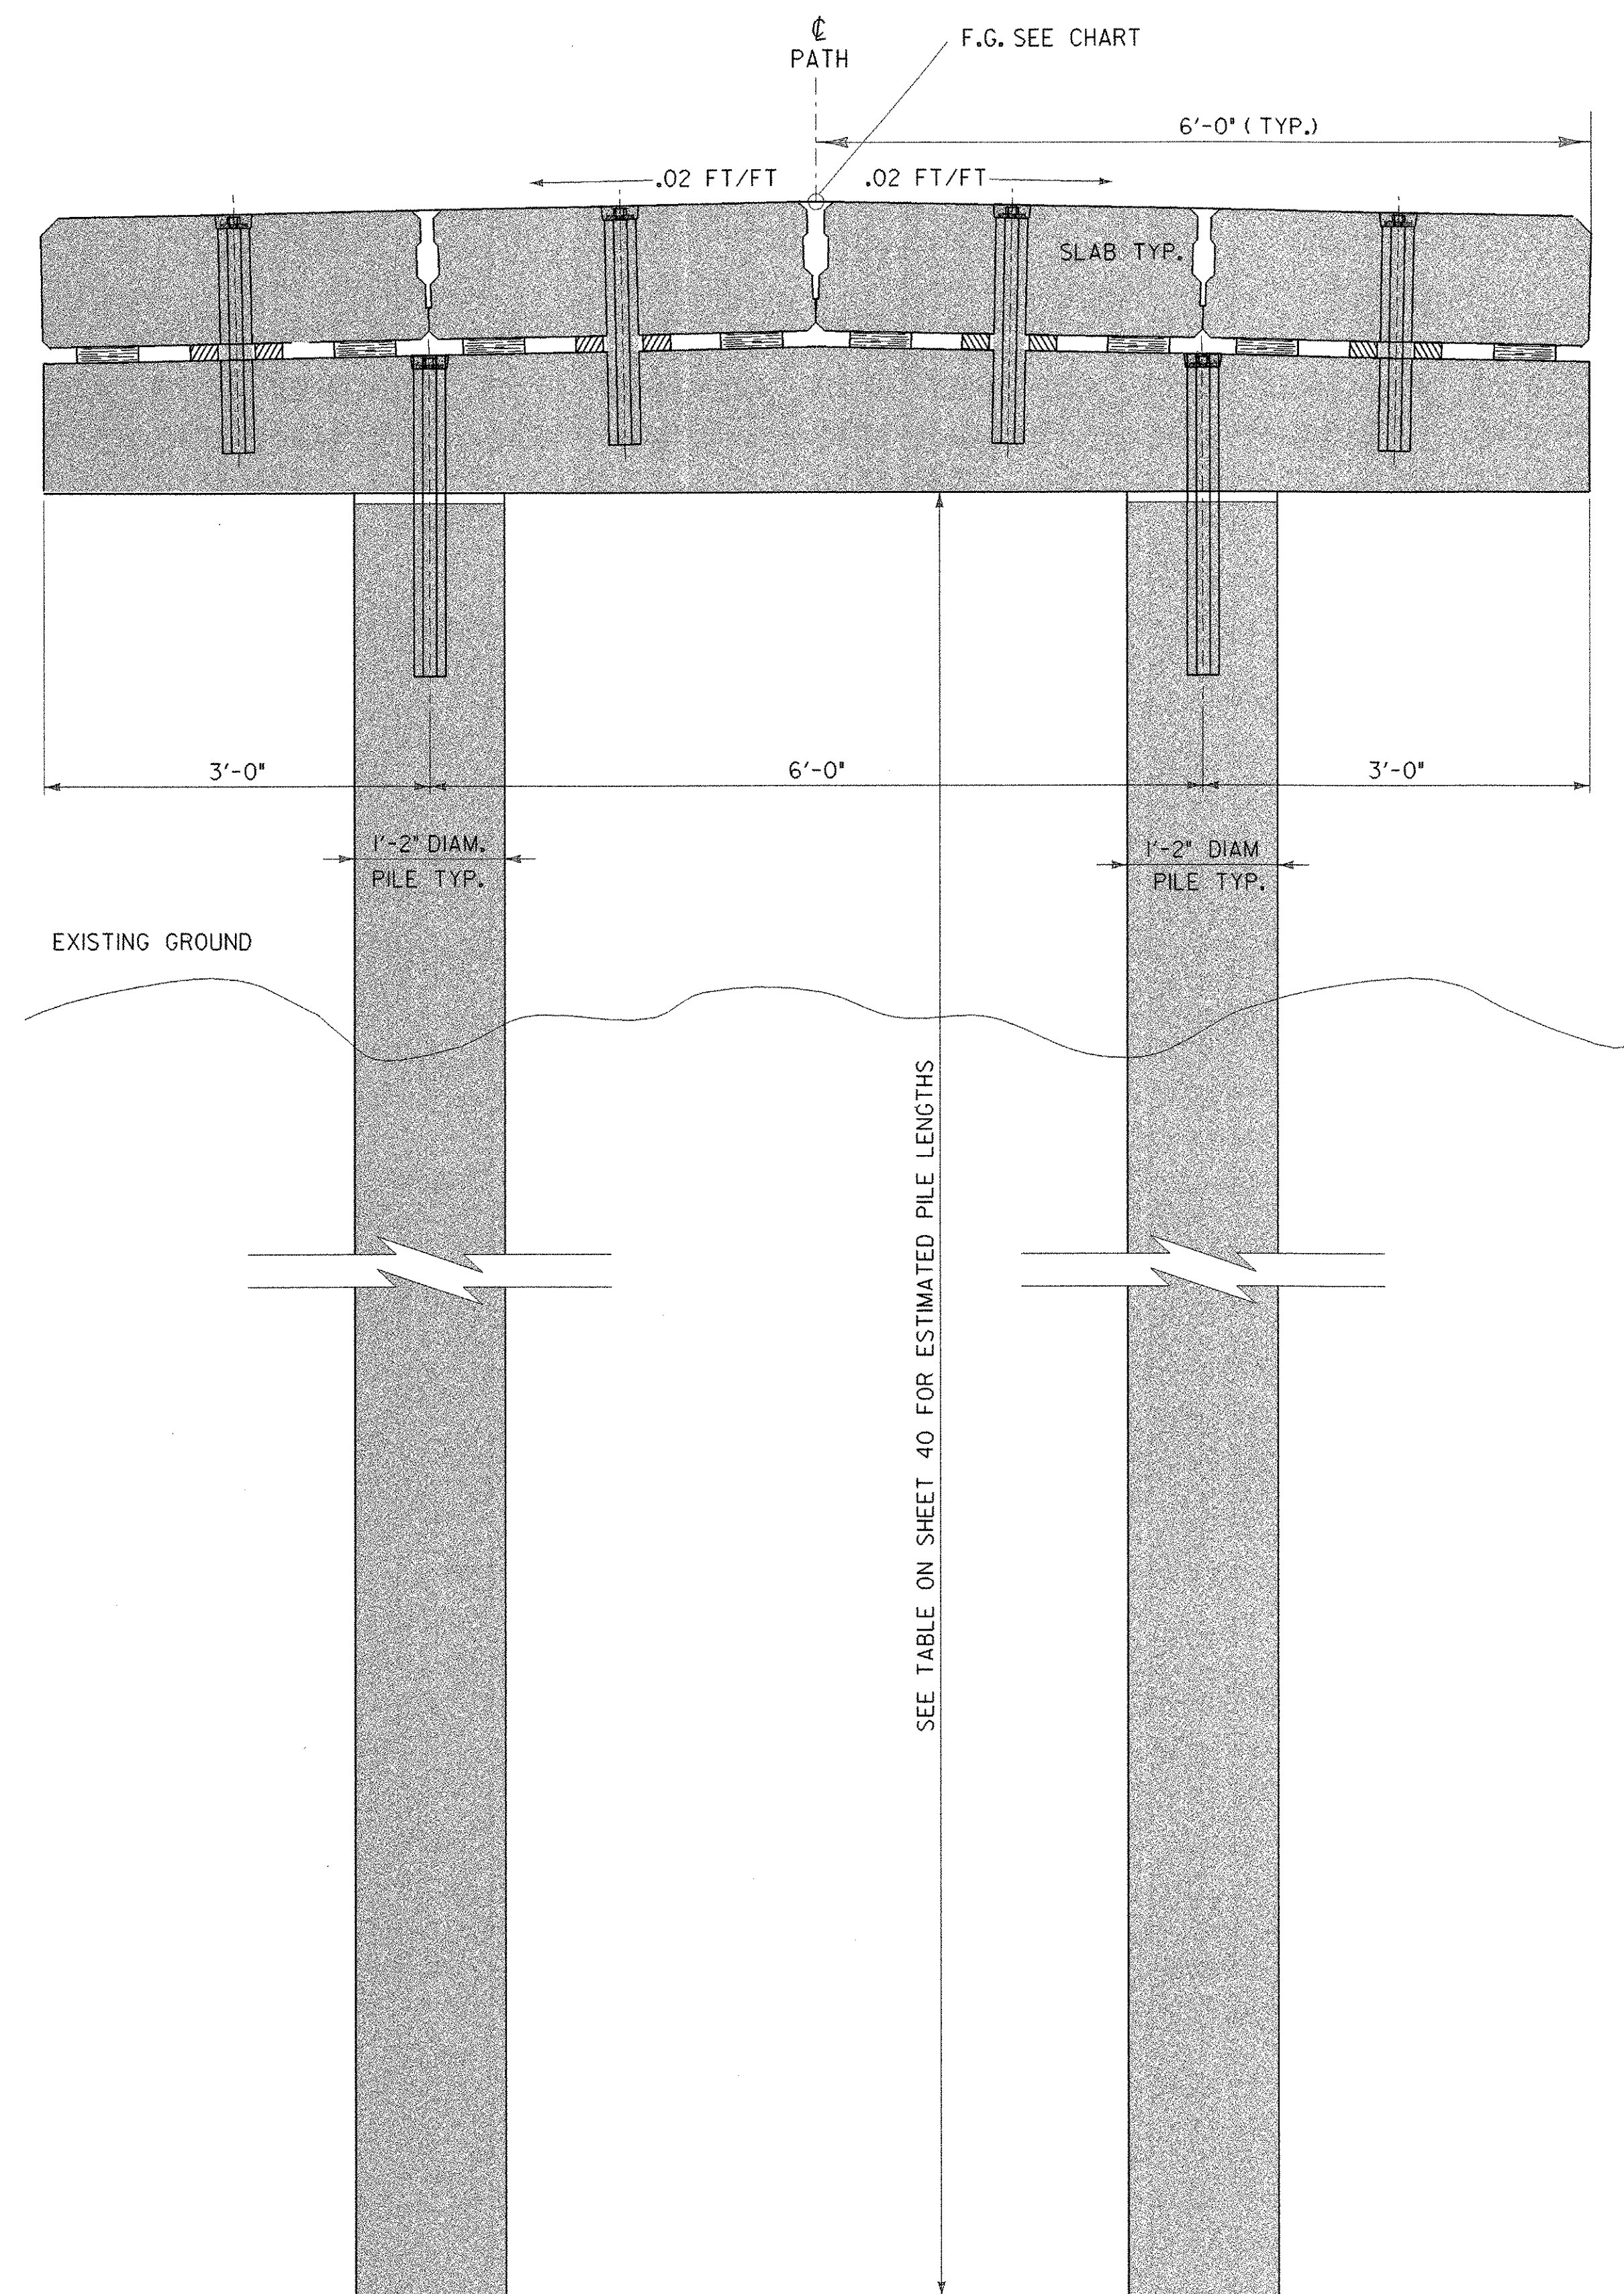

SUBSTRUCTURE ELEVATION
FACING UP STATION

SCALE 1" = 1'-0"
1 9 6 3 0 1 2

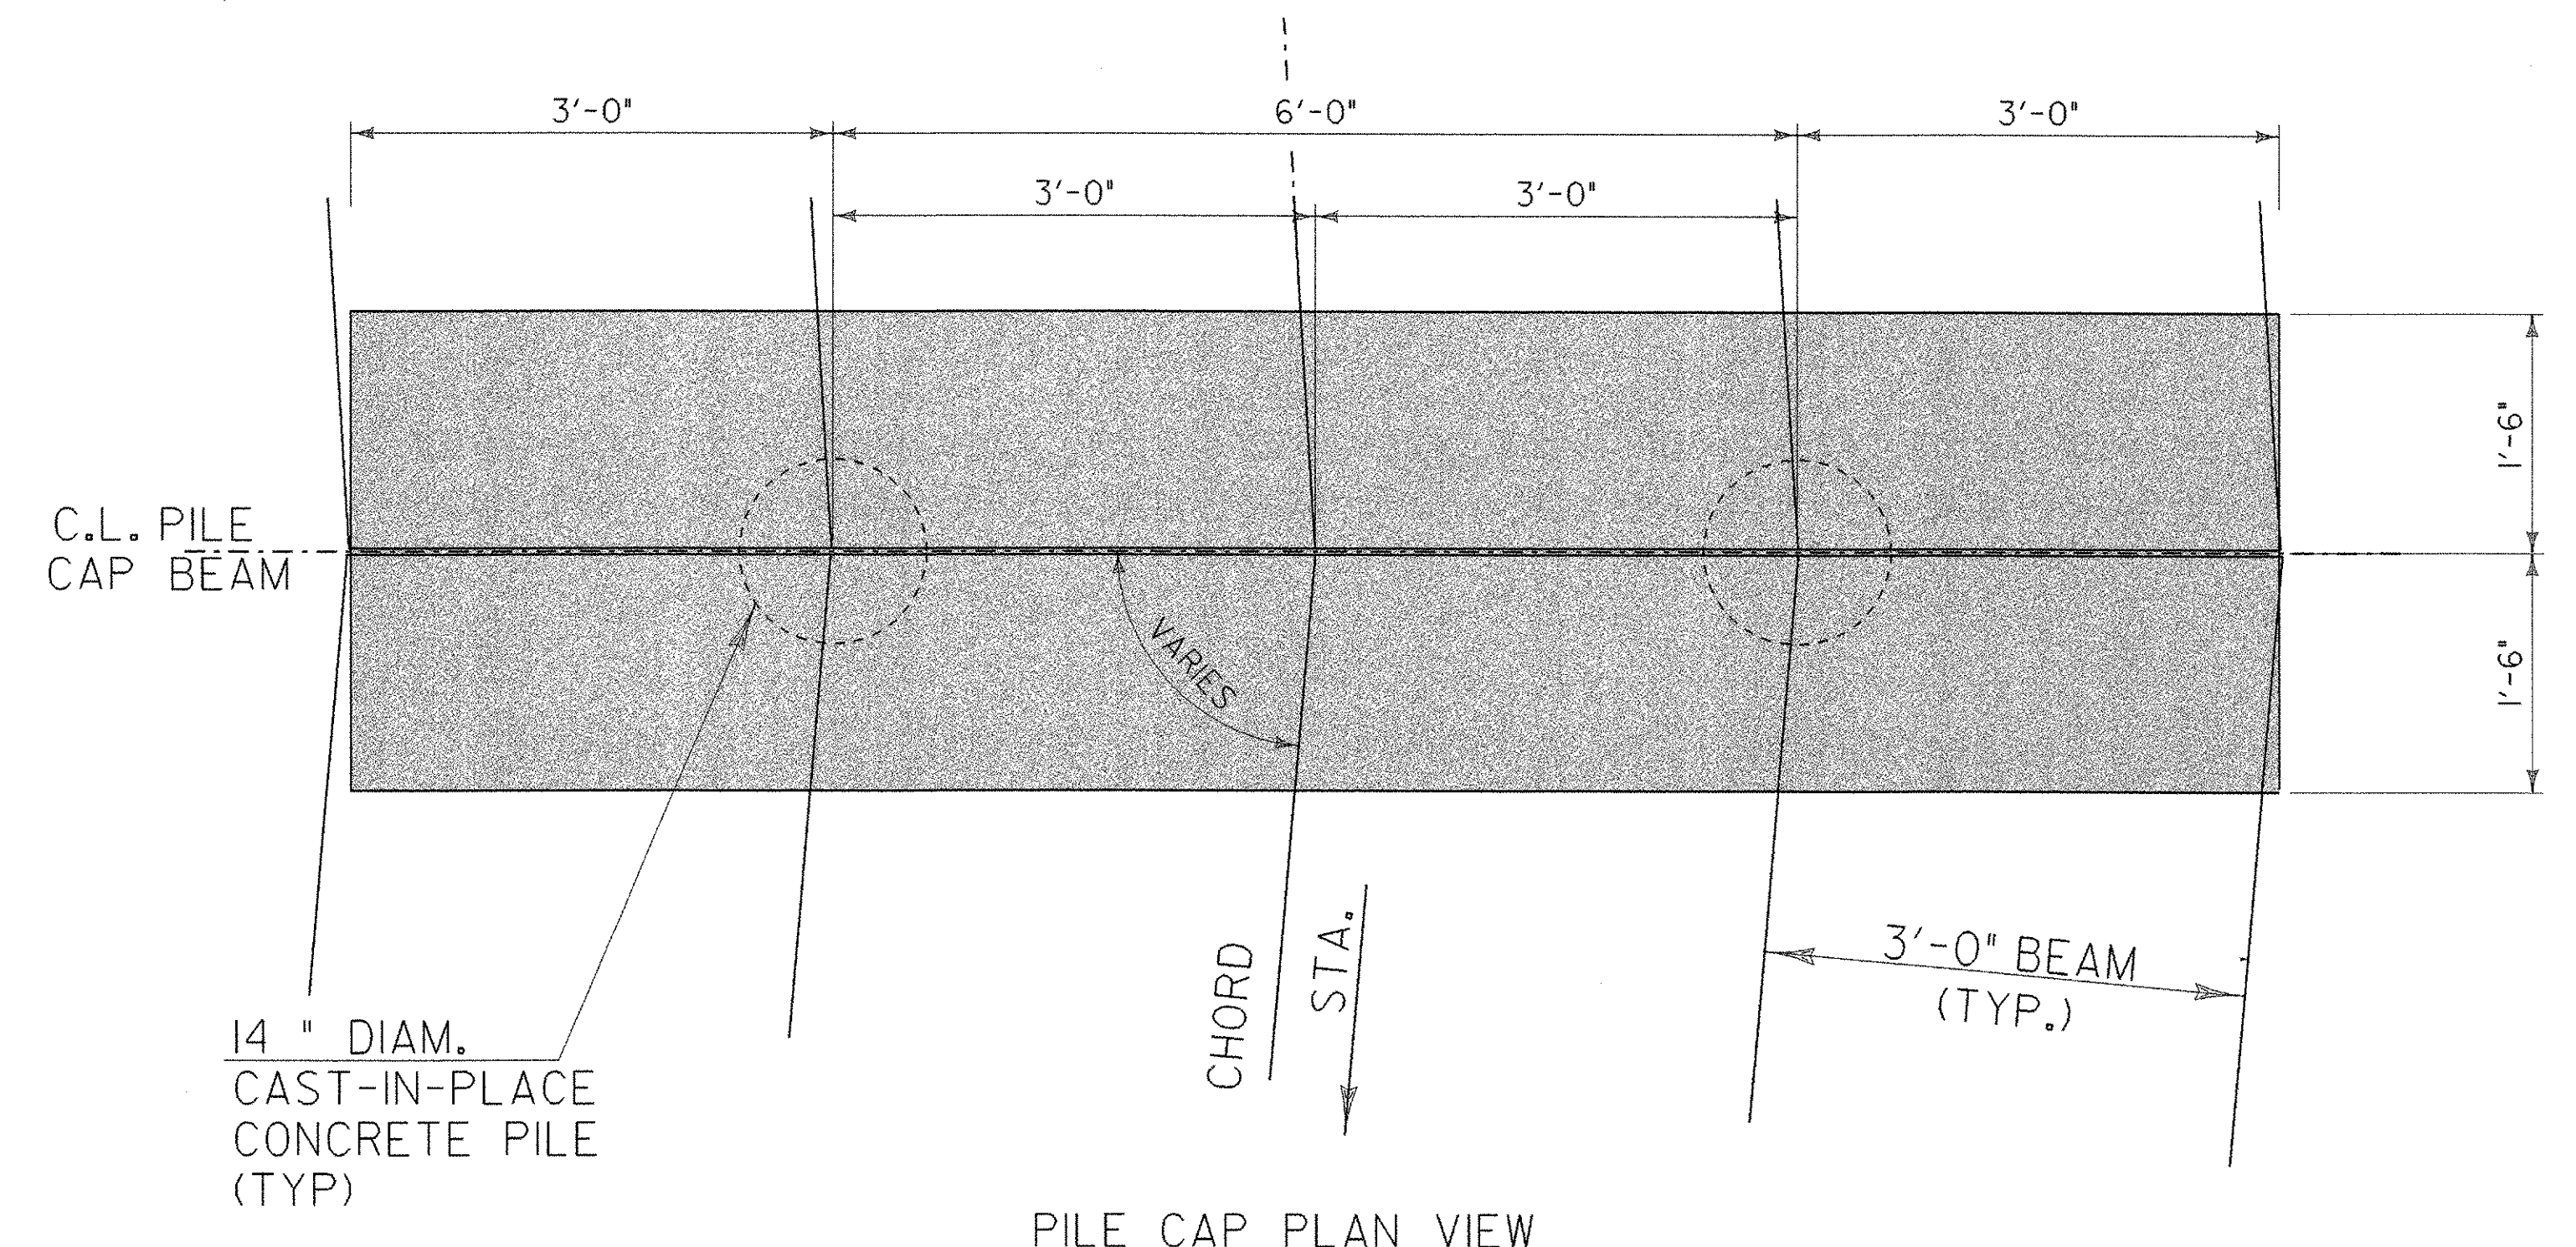

PILE CAP PLAN VIEW

SCALE 1" = 1'-0"
1 9 6 3 0 1 2

SECTION VIEW OF ELEVATED PATH

PROJECT NAME: COLCHESTER
PROJECT NUMBER: STP Bike(48)

FILE NAME: /str5/03f038/sf038pstdet.dgn PLOT DATE: 05-AUG-2003
PROJECT LEADER: C. KELLER DRAWN BY: J. GEORGE
DESIGNED BY: J. GEORGE CHECKED BY: M.E.M.
sf038pstdet.i SHEET 39 OF 87