


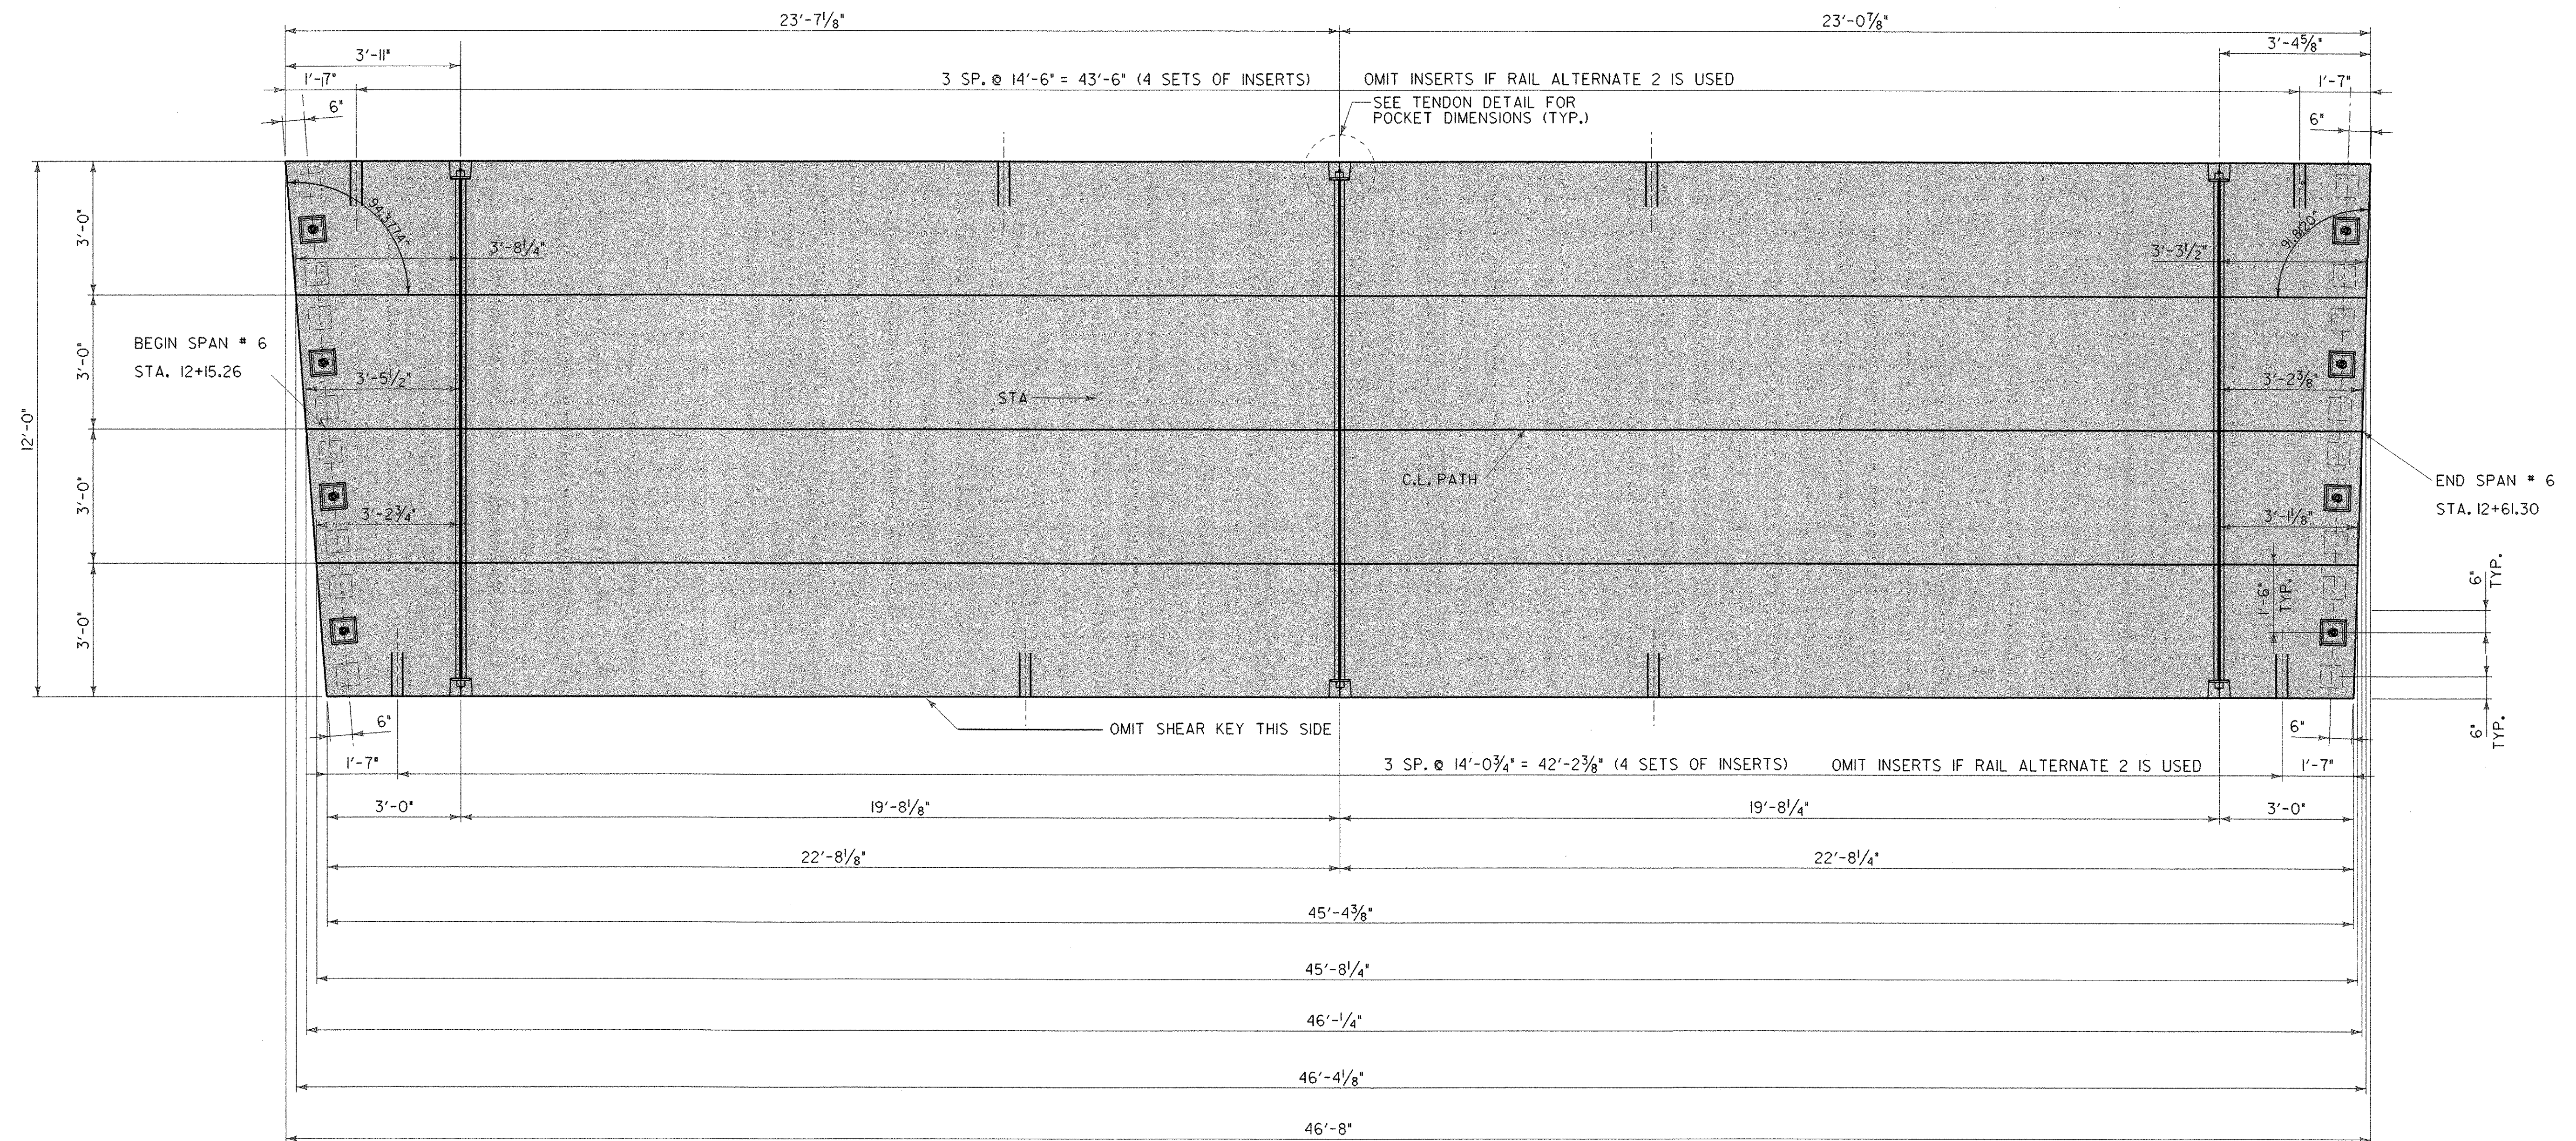

PRESTRESSED SLAB LAYOUT
SPAN 6

SCALE 1/2" = 1'-0"
1 0 1 2

THE TOPS OF THE PRESTRESSED SLABS SHALL BE SCREEDED AND GIVEN A BROOMED OR WIRE BROOM FINISH.
THE GROOVES SHALL BE IN THE TRANSVERSE DIRECTION AND PENETRATE THE SURFACE APPROXIMATELY 1/4"

SLAB DETAILS SPAN 6

PROJECT NAME:	COLCHESTER
PROJECT NUMBER:	STP Bike(48)
FILE NAME:	/str5/03f038/sf038pstdet.dgn
PROJECT LEADER:	C. KELLER
DESIGNED BY:	J. GEORGE
	sf038pstde+8.i
DATE:	05-AUG-2003
DRAWN BY:	J. GEORGE
CHECKED BY:	M.E.M.
SHEET	46 OF 87